MAP OF SUB-LOT NO. 808
HOMEWOOD FOURTH ADD'N. VOL. 19 PG. 28
ORIG. LOTS 77 & 78 - SHEFFIELD TWP.
LORAIN CITY - LORAIN COUNTY - OHIO
SCALE: 1"=30' JAN. 30-1970 5:30 P.M.
NOTE: There are no encroachments on
this property.
Gary E. Penfound REG. SURVEYOR NO. 4457
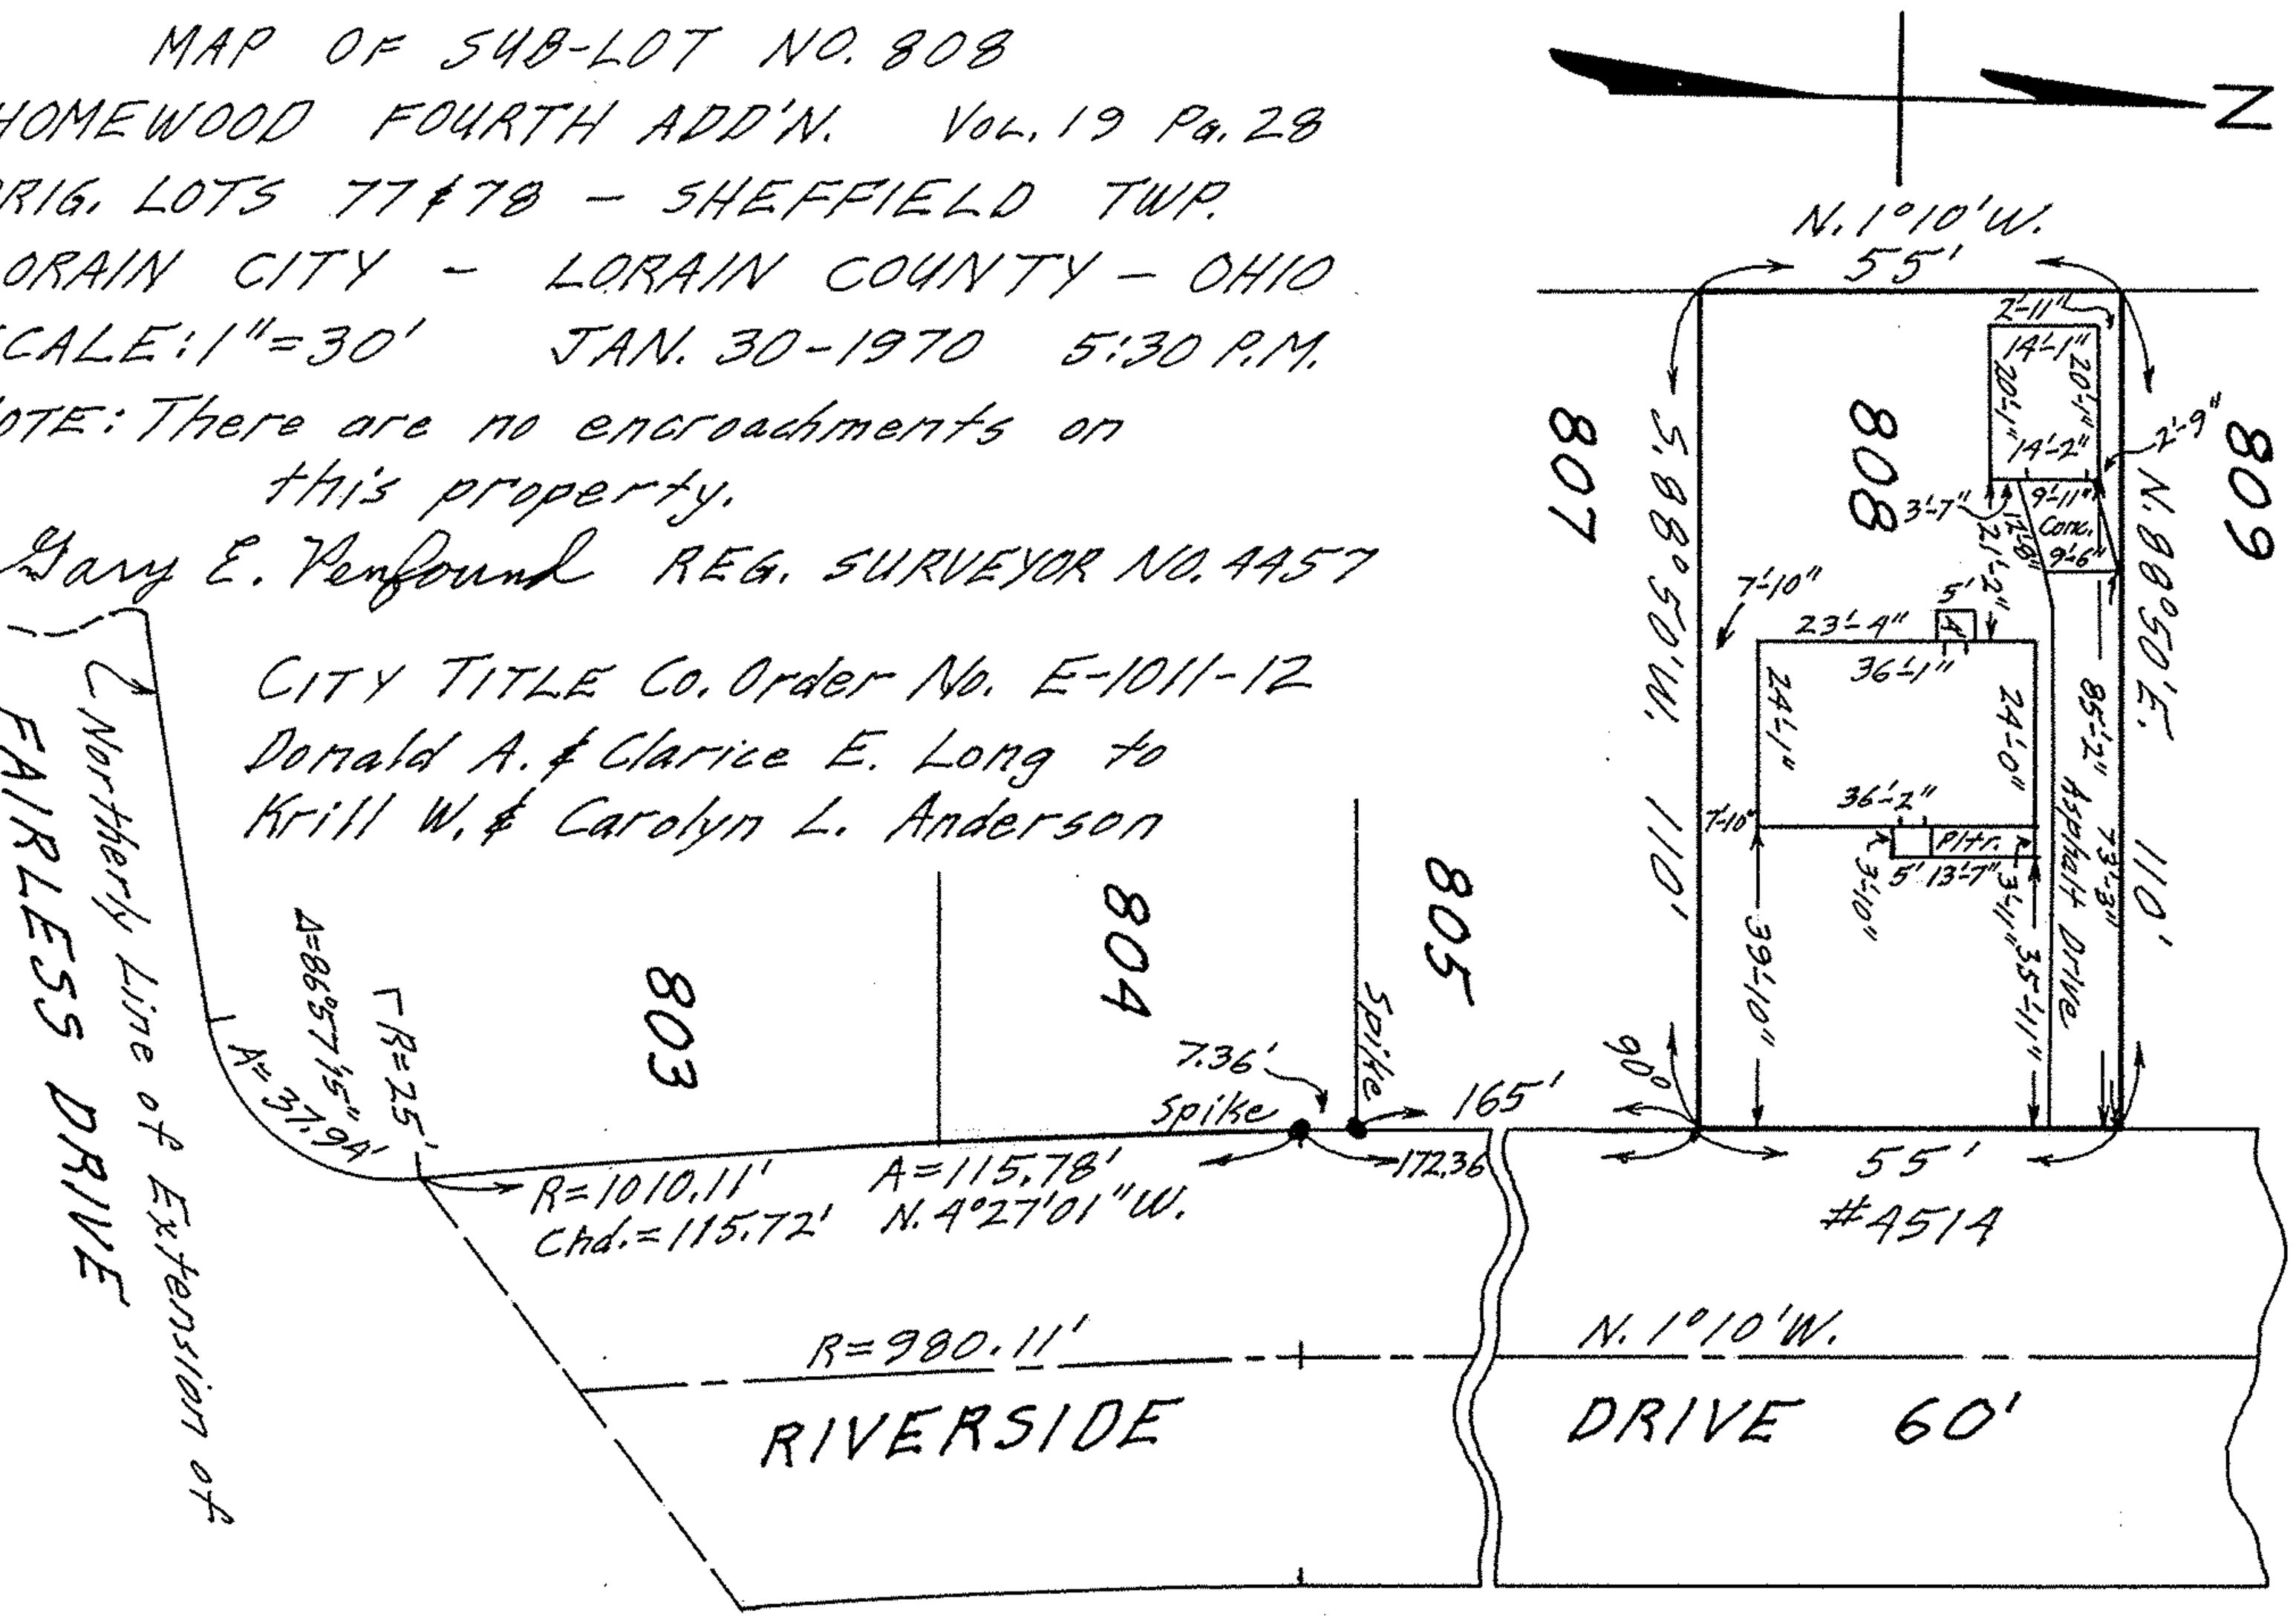
CITY TITLE Co. Order No. E-1011-12
Donald A. & Clarice E. Long to
Krill W. & Carolyn L. Anderson