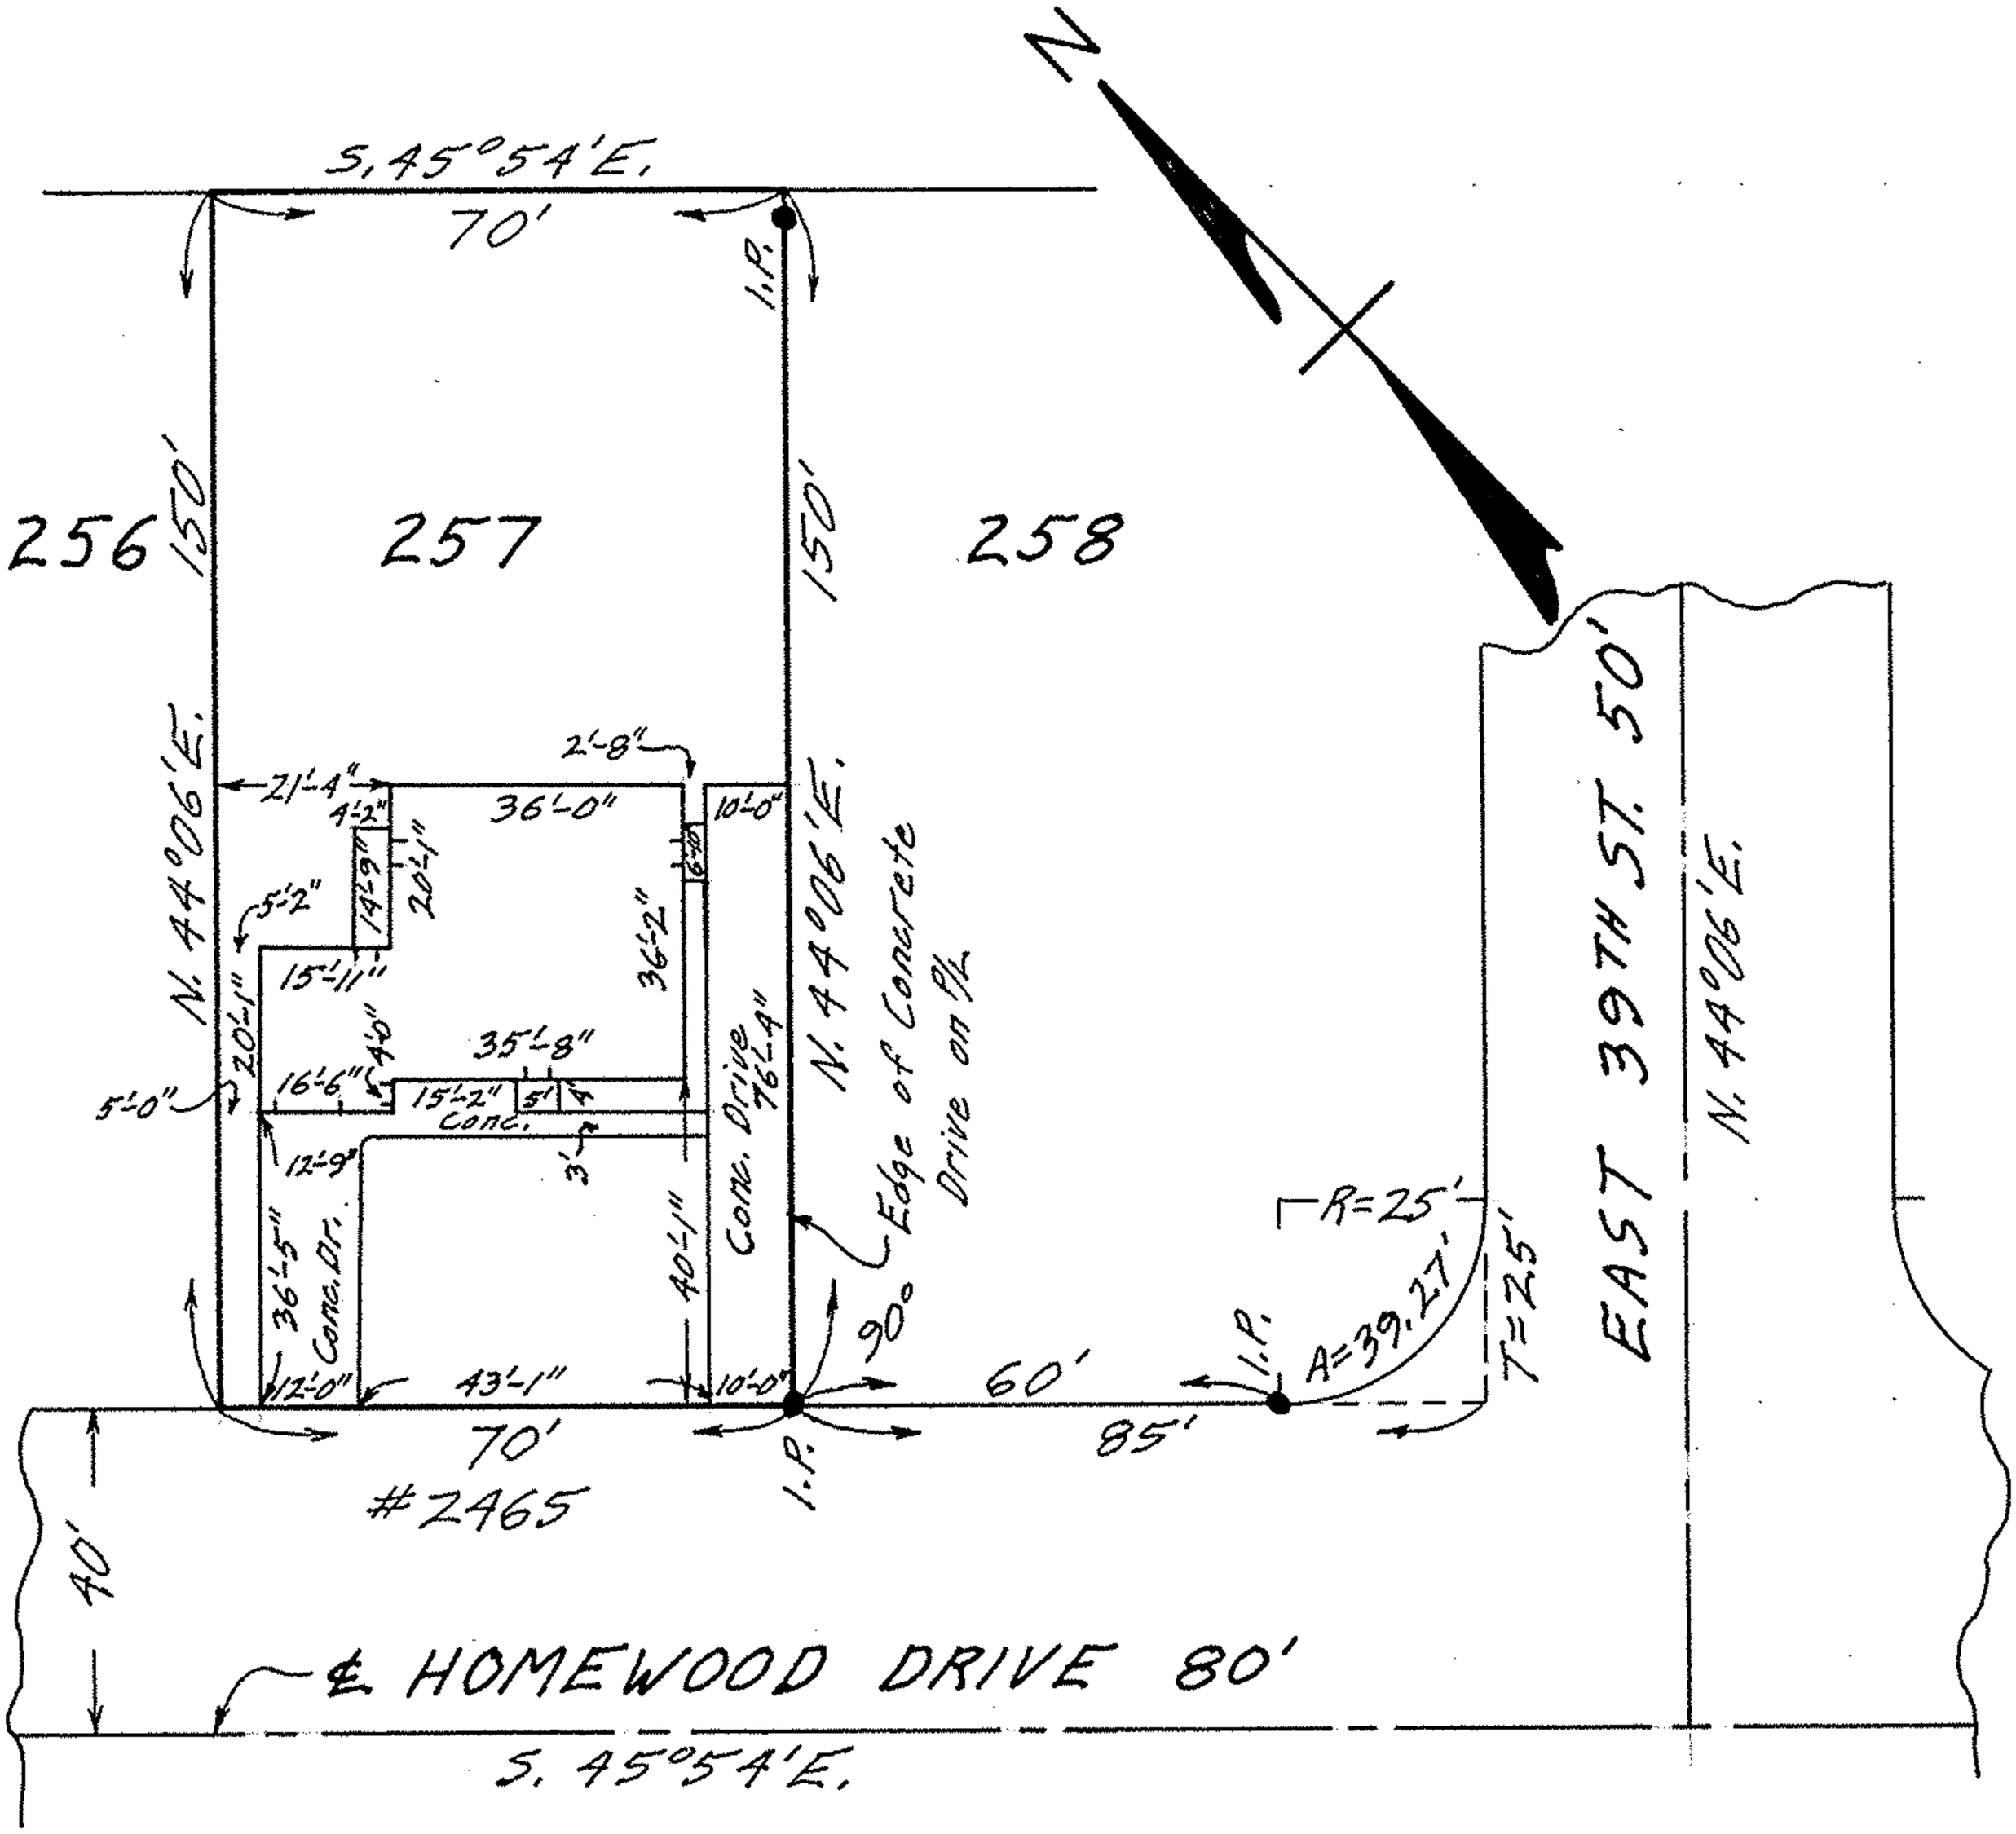

MAP OF SUB-LOT NO. 257

HOMEWOOD ADD'N. VOL. 14 PGS. 22 & 23

ORIG. LOT 80 SHEFFIELD TWP.

LORAIN CITY - LORAIN COUNTY - OHIO

SCALE: 1" = 30' FEB. 11-1970 5:45 P.M.

NOTE; There are no encroachments on this property.

Gary E. Penfound REG. SURVEYOR NO. 4457

CITY TITLE Co. Order No. E-1028-29

James W. & Elizabeth Smith to Raymond Meyers

03-00-080