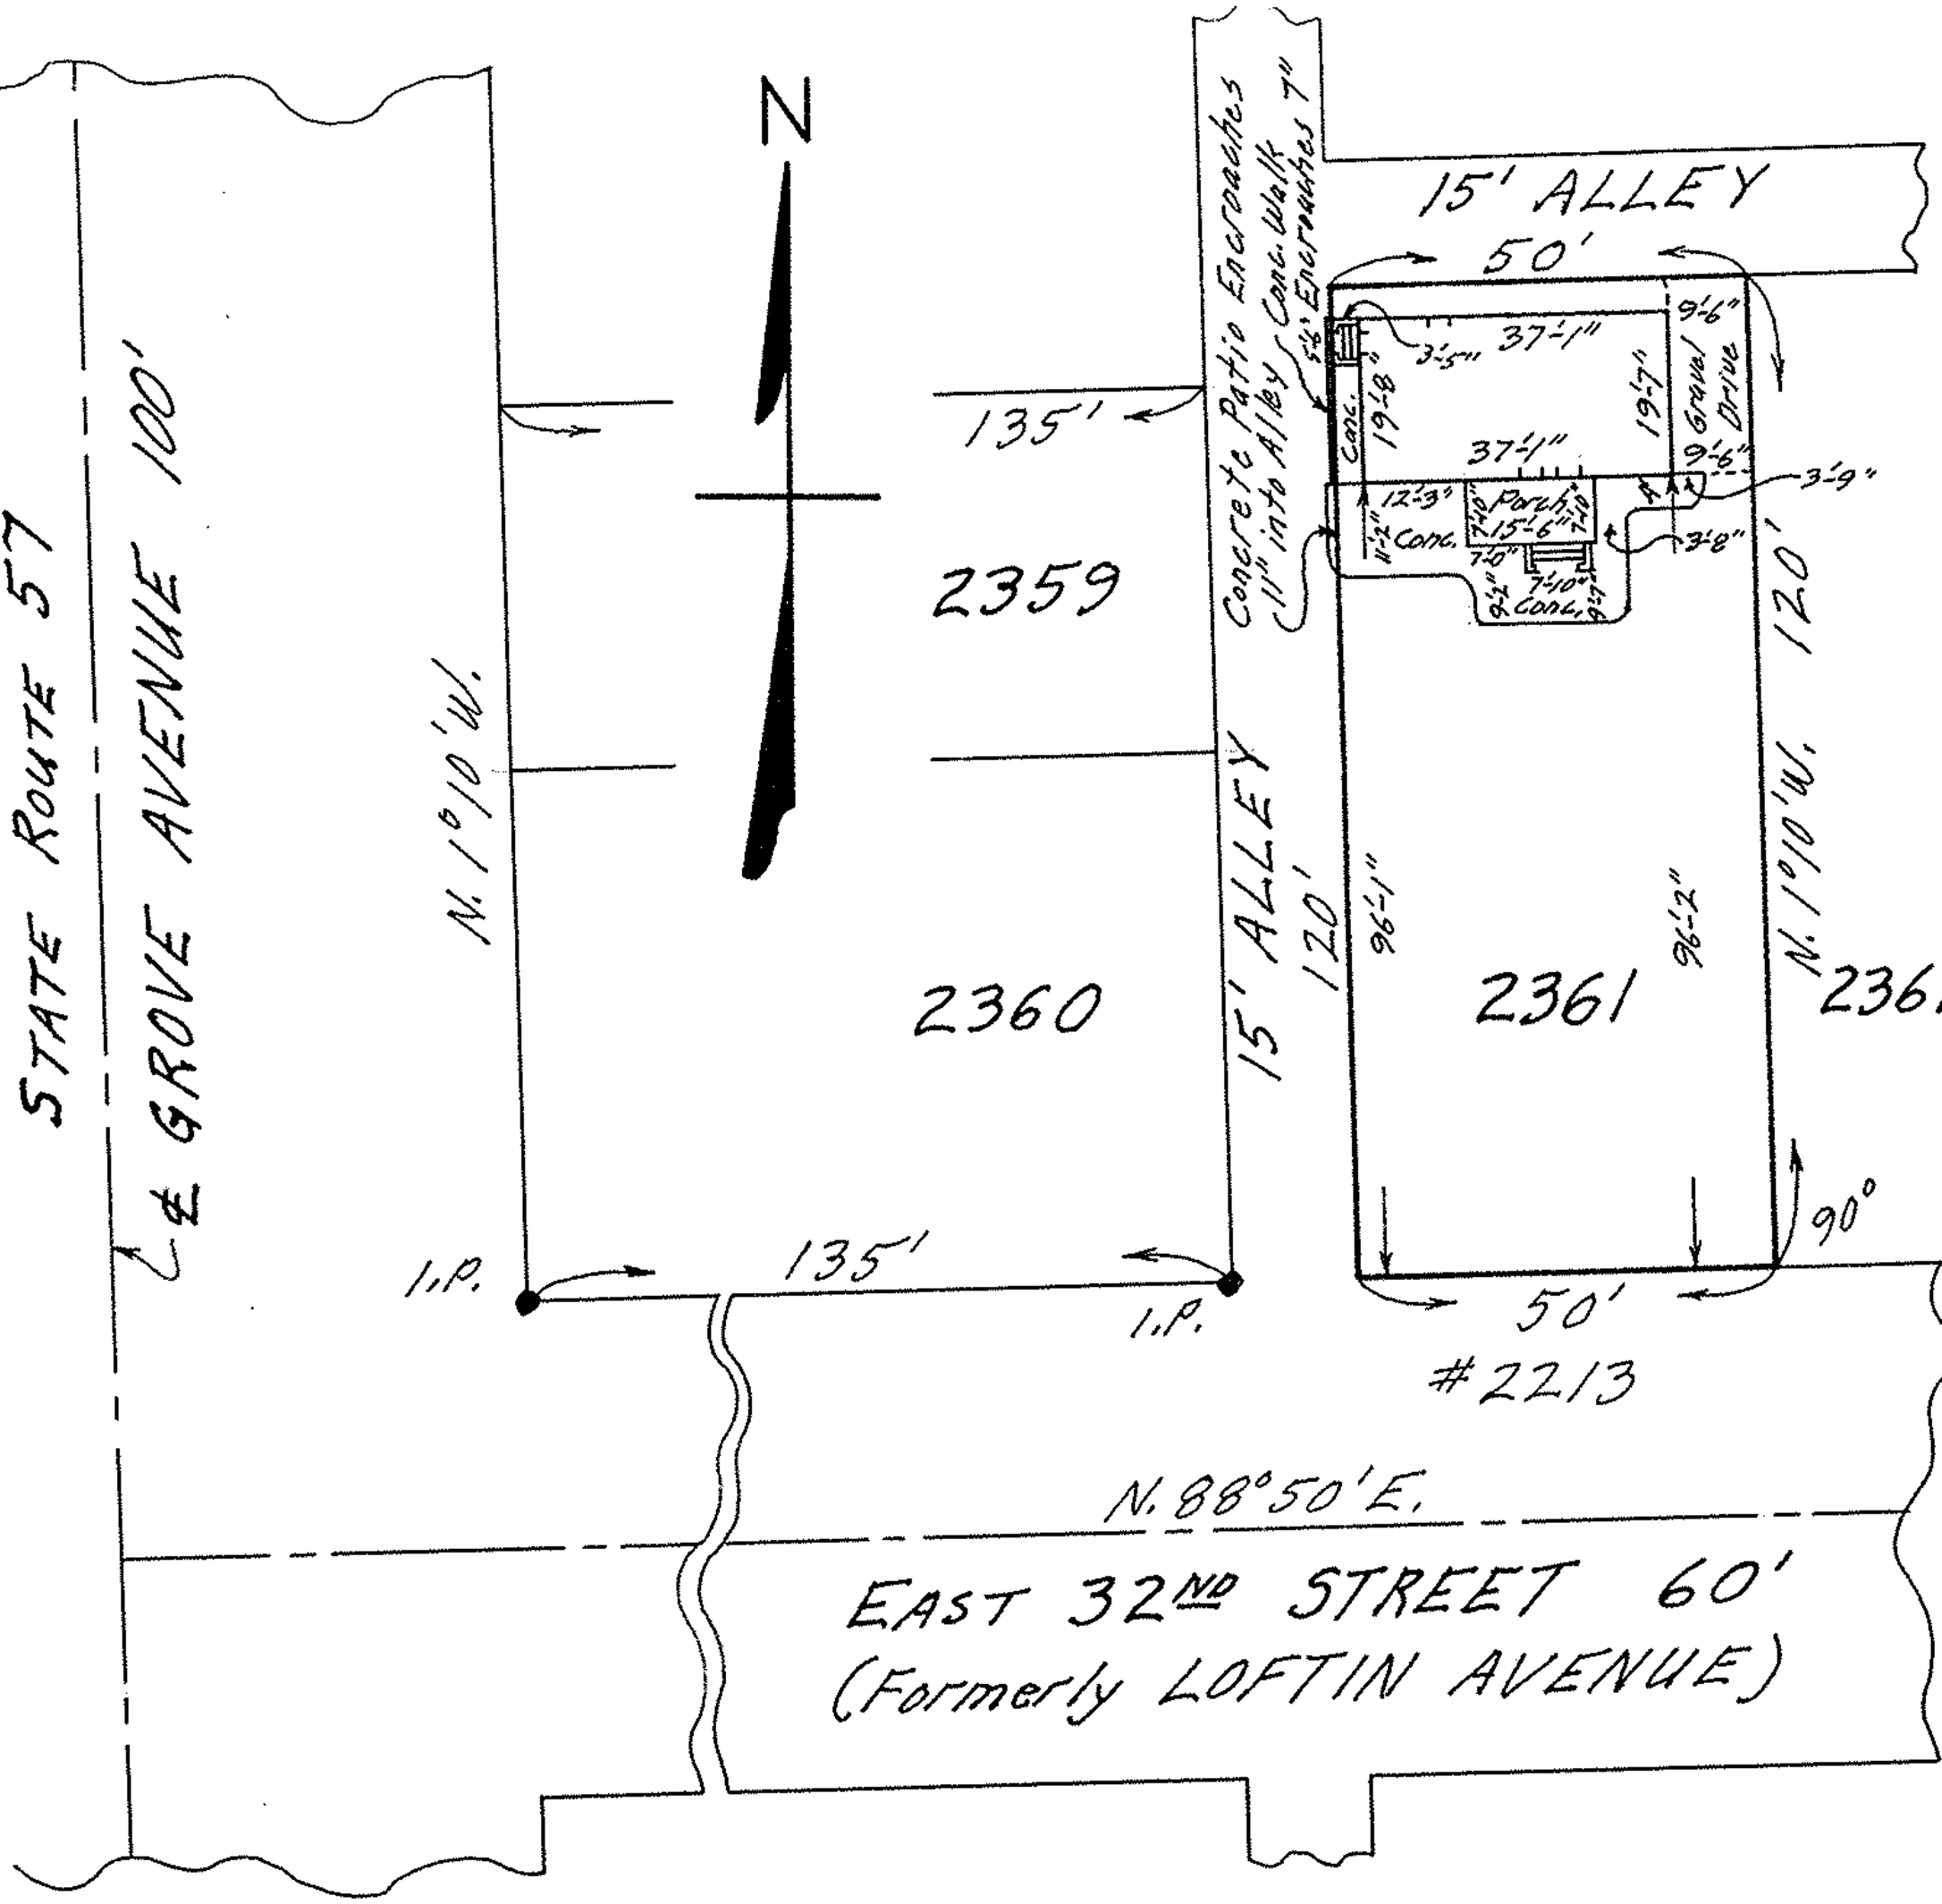

MAP OF SUB-LOT NO. 2361 OF SUB'N. NO. 4 OF THE SHEFFIELD LAND & IMPROVEMENT COMPANY'S PROPERTY
VOL. 6 PG. 3 PLATS ORIGINAL LOT 94 SHEFFIELD TWP.
LORAIN CITY - LORAIN COUNTY - OHIO
SCALE: 1" = 30' AUG. 16-1970 6:00 P.M.
NOTE! There are no encroachments onto this property, but concrete patio & walk encroach into Alley. Gary E. Penfound REG. SURVEYOR NO. 4457
CITY TITLE CO. Order No. E-1254-5 Dugovich to Gonzalez

03-00-094