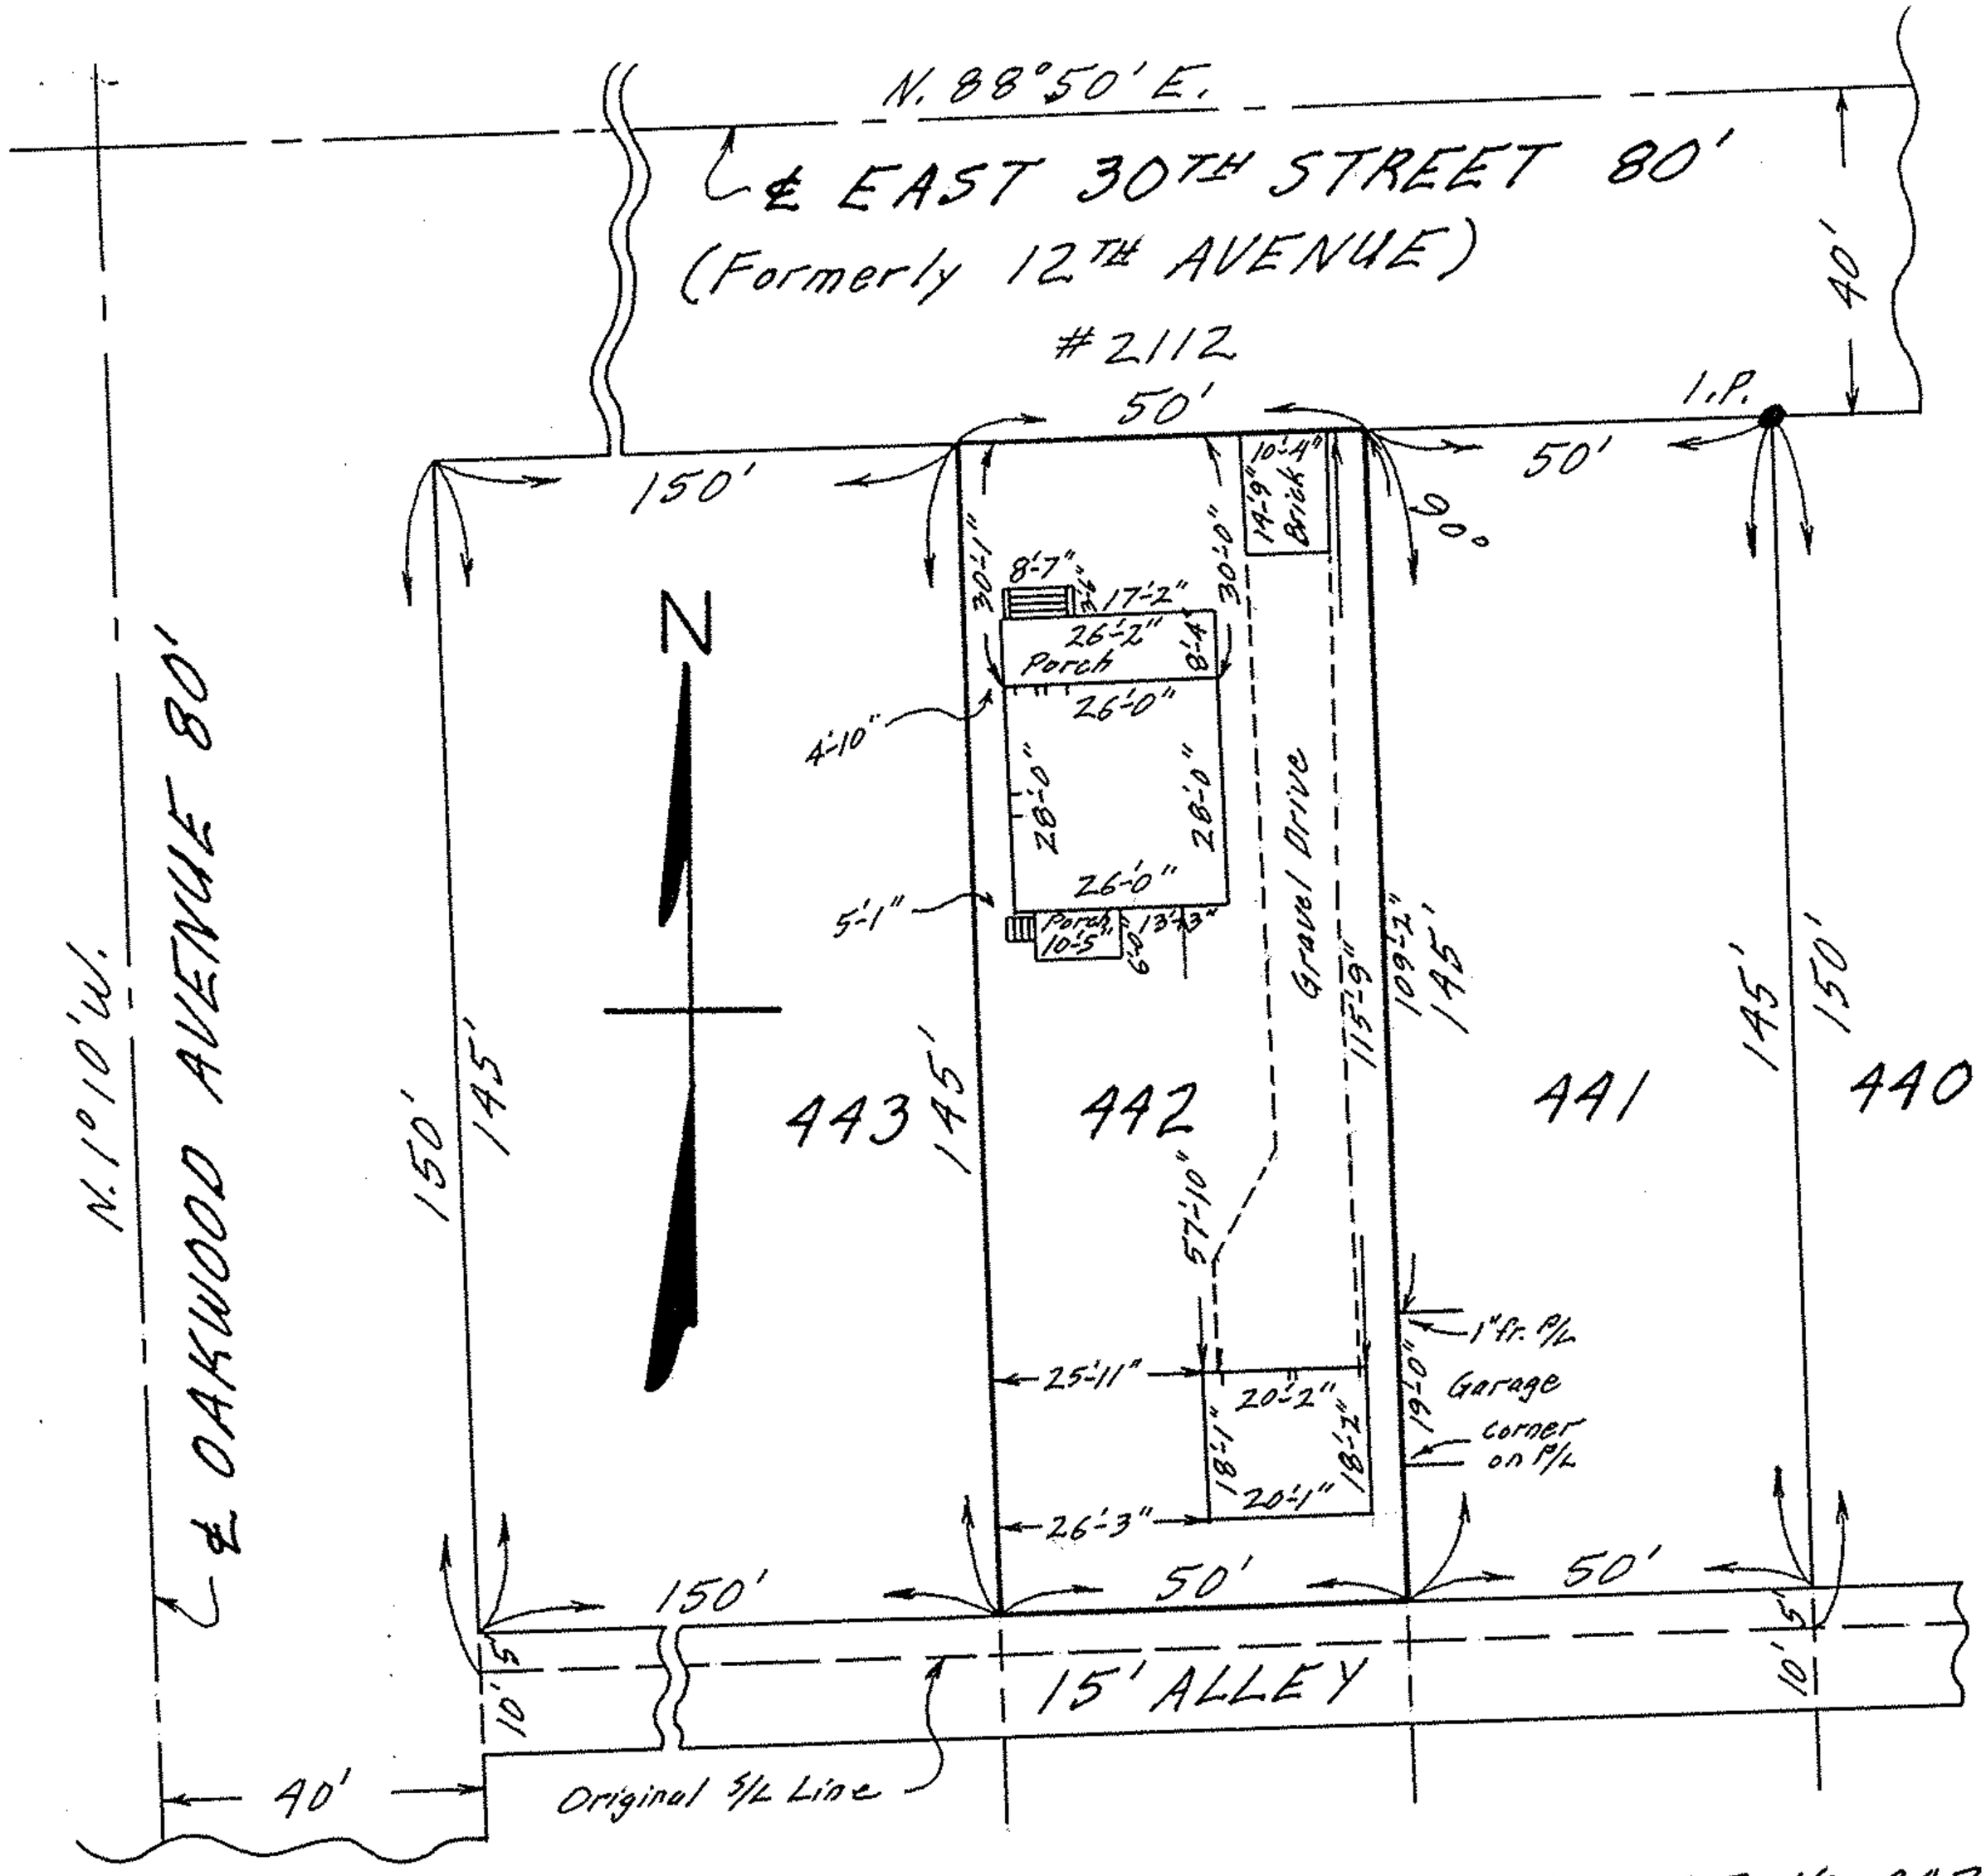

MAP OF THE NORTHERLY 145 FEET OF SUB-LOT NO. 442
THE SHEFFIELD LAND COMPANY'S SUB'N. NO. 1 - Vol. 4 Pg. 23
ORIGINAL LOT NO. 94 - SHEFFIELD TWP.
LORAIN CITY - LORAIN COUNTY - OHIO
SCALE: 1"=30' DEC. 5-1970 3:15 P.M.
NOTE: There are no encroachments on this
property, but rear corner of garage
from Sub-Lot 441 is on property line.
Gary E. Penfound REG. SURVEYOR NO. 4457
CITY TITLE Co. Order No. E-1403-4 Zudell to Simmons 03-00-094