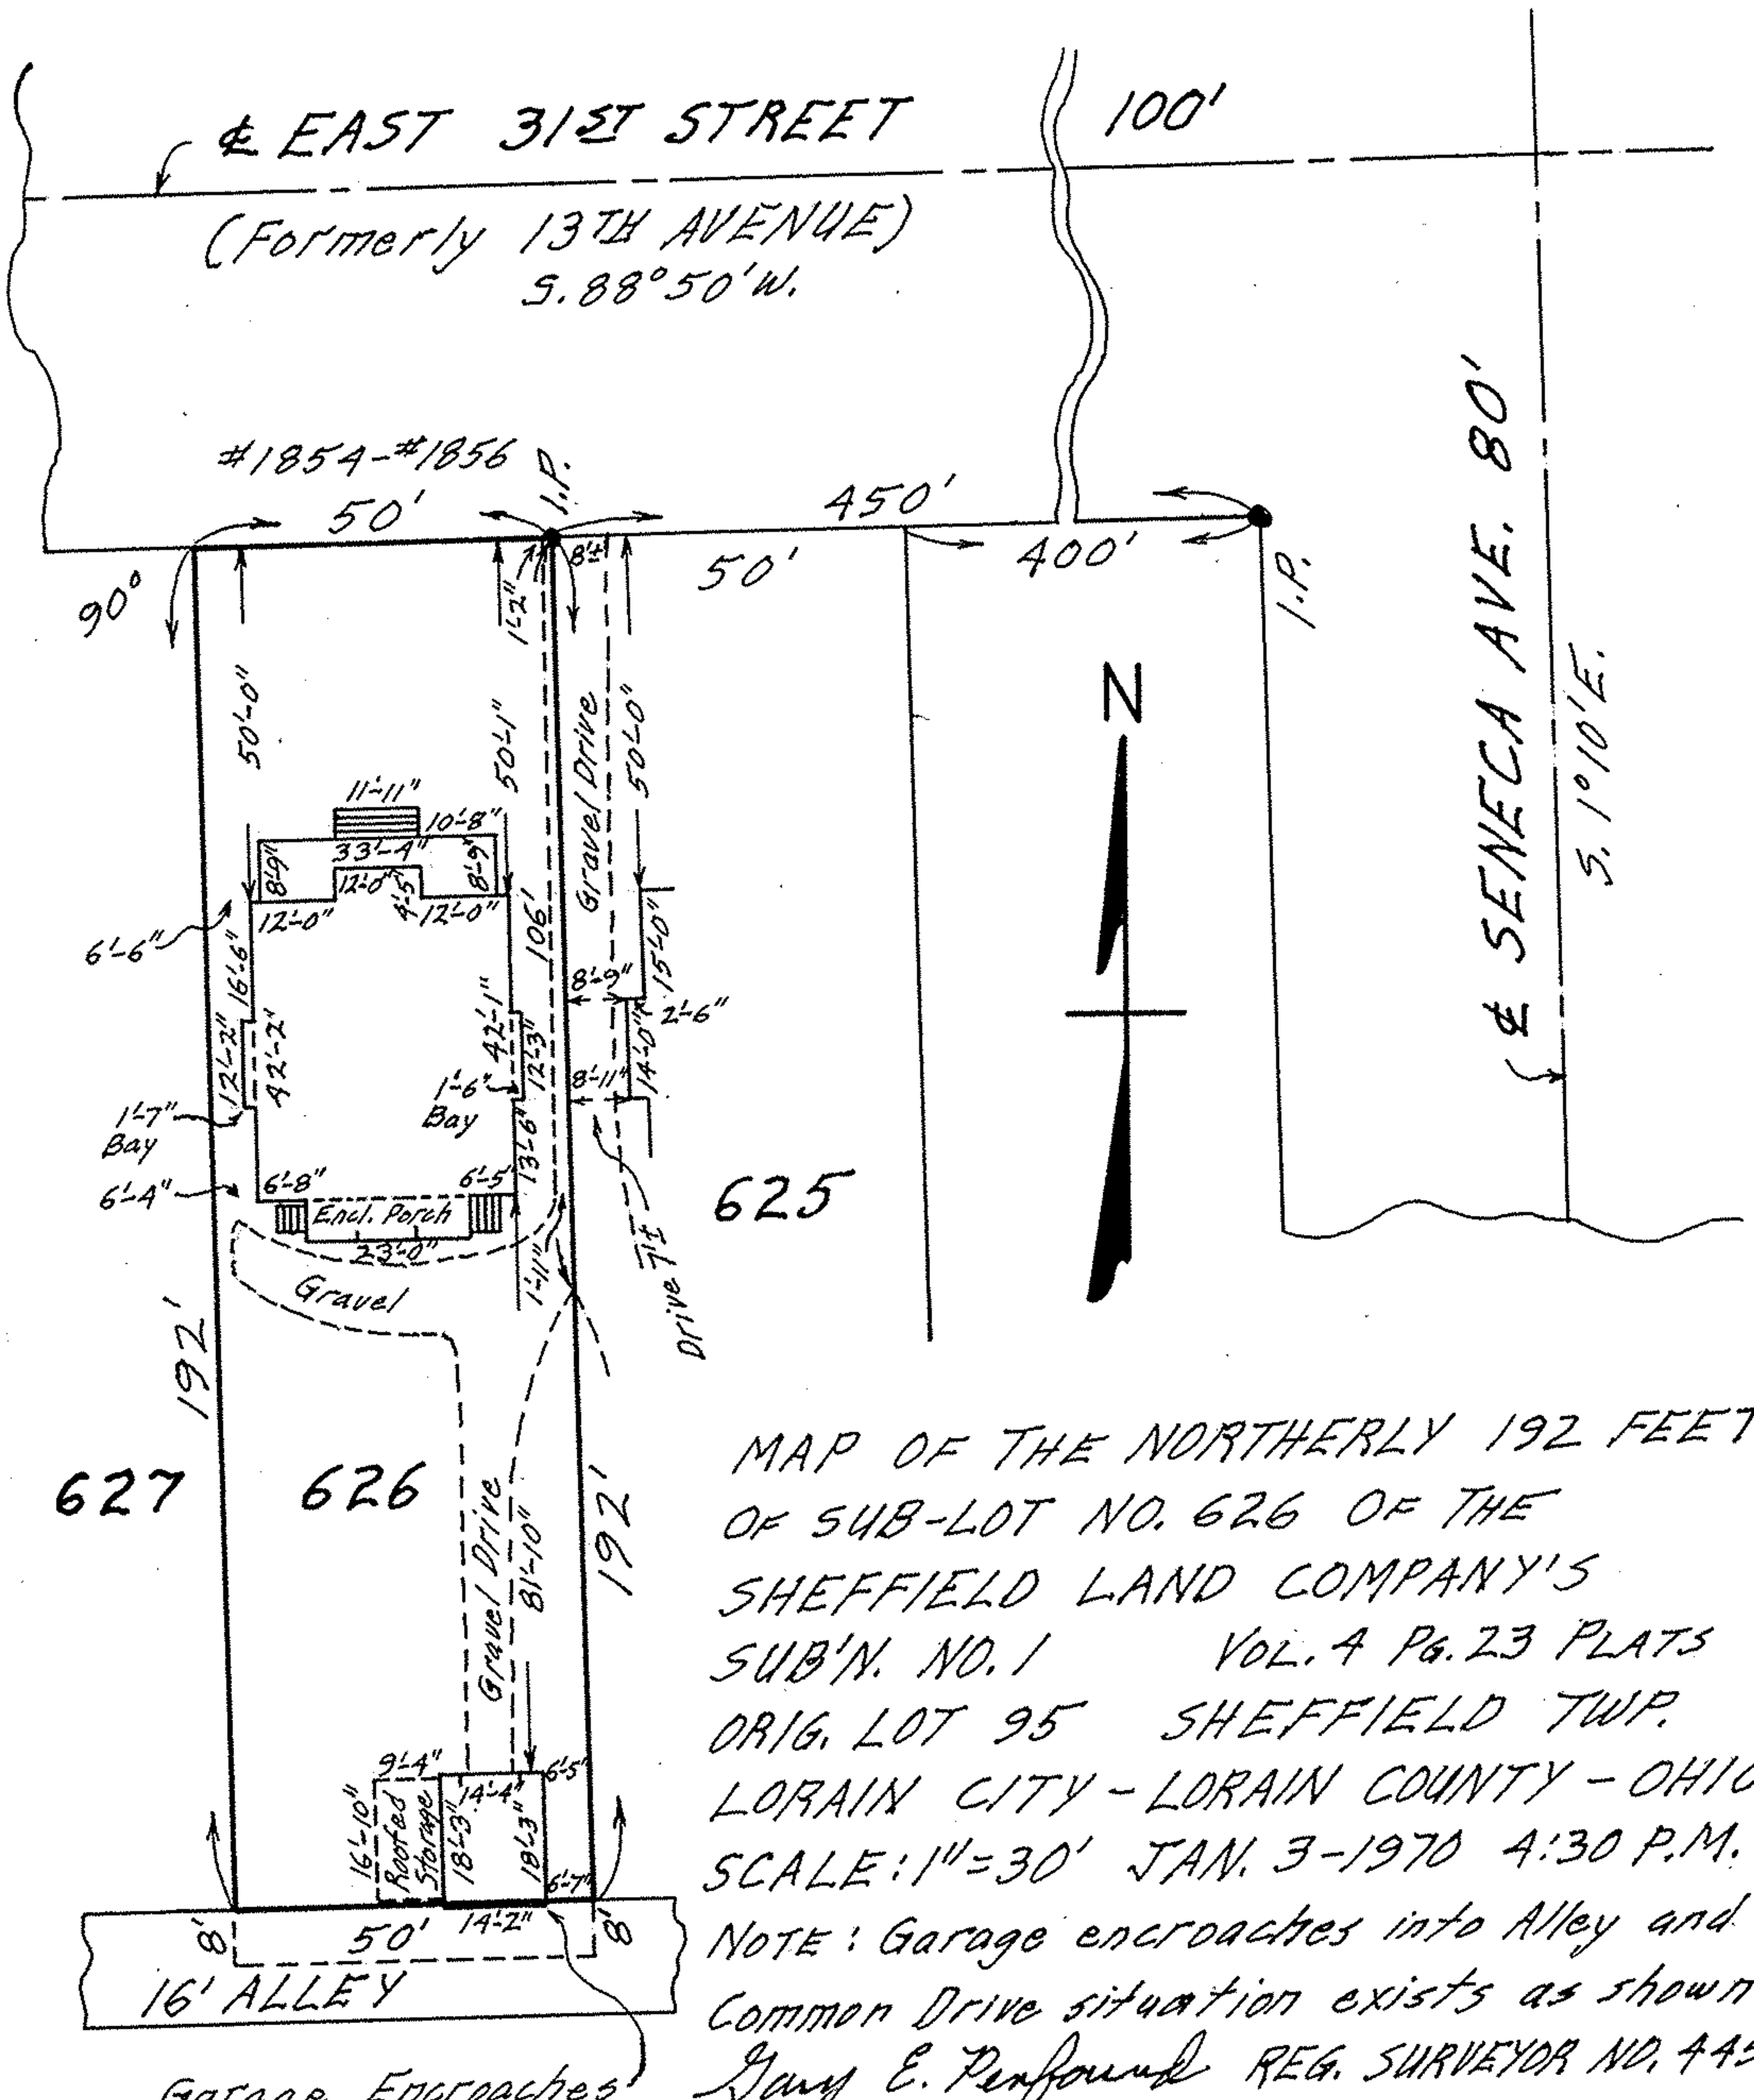

Garage Encroaches
3" into Alley

MAP OF THE NORTHERLY 192 FEET
OF SUB-LOT NO. 626 OF THE
SHEFFIELD LAND COMPANY'S
SUB'N. NO. 1 VOL. 4 PG. 23 PLATS
ORIG. LOT 95 SHEFFIELD TWP.
LORAIN CITY - LORAIN COUNTY - OHIO
SCALE: 1"=30' JAN. 3-1970 4:30 P.M.
NOTE: Garage encroaches into Alley and
Common Drive situation exists as shown.
Gary E. Perfound REG. SURVEYOR NO. 4457
CITY TITLE Co. Order No. E-990-1
Skorvanik to Gonzalez

03-00-095