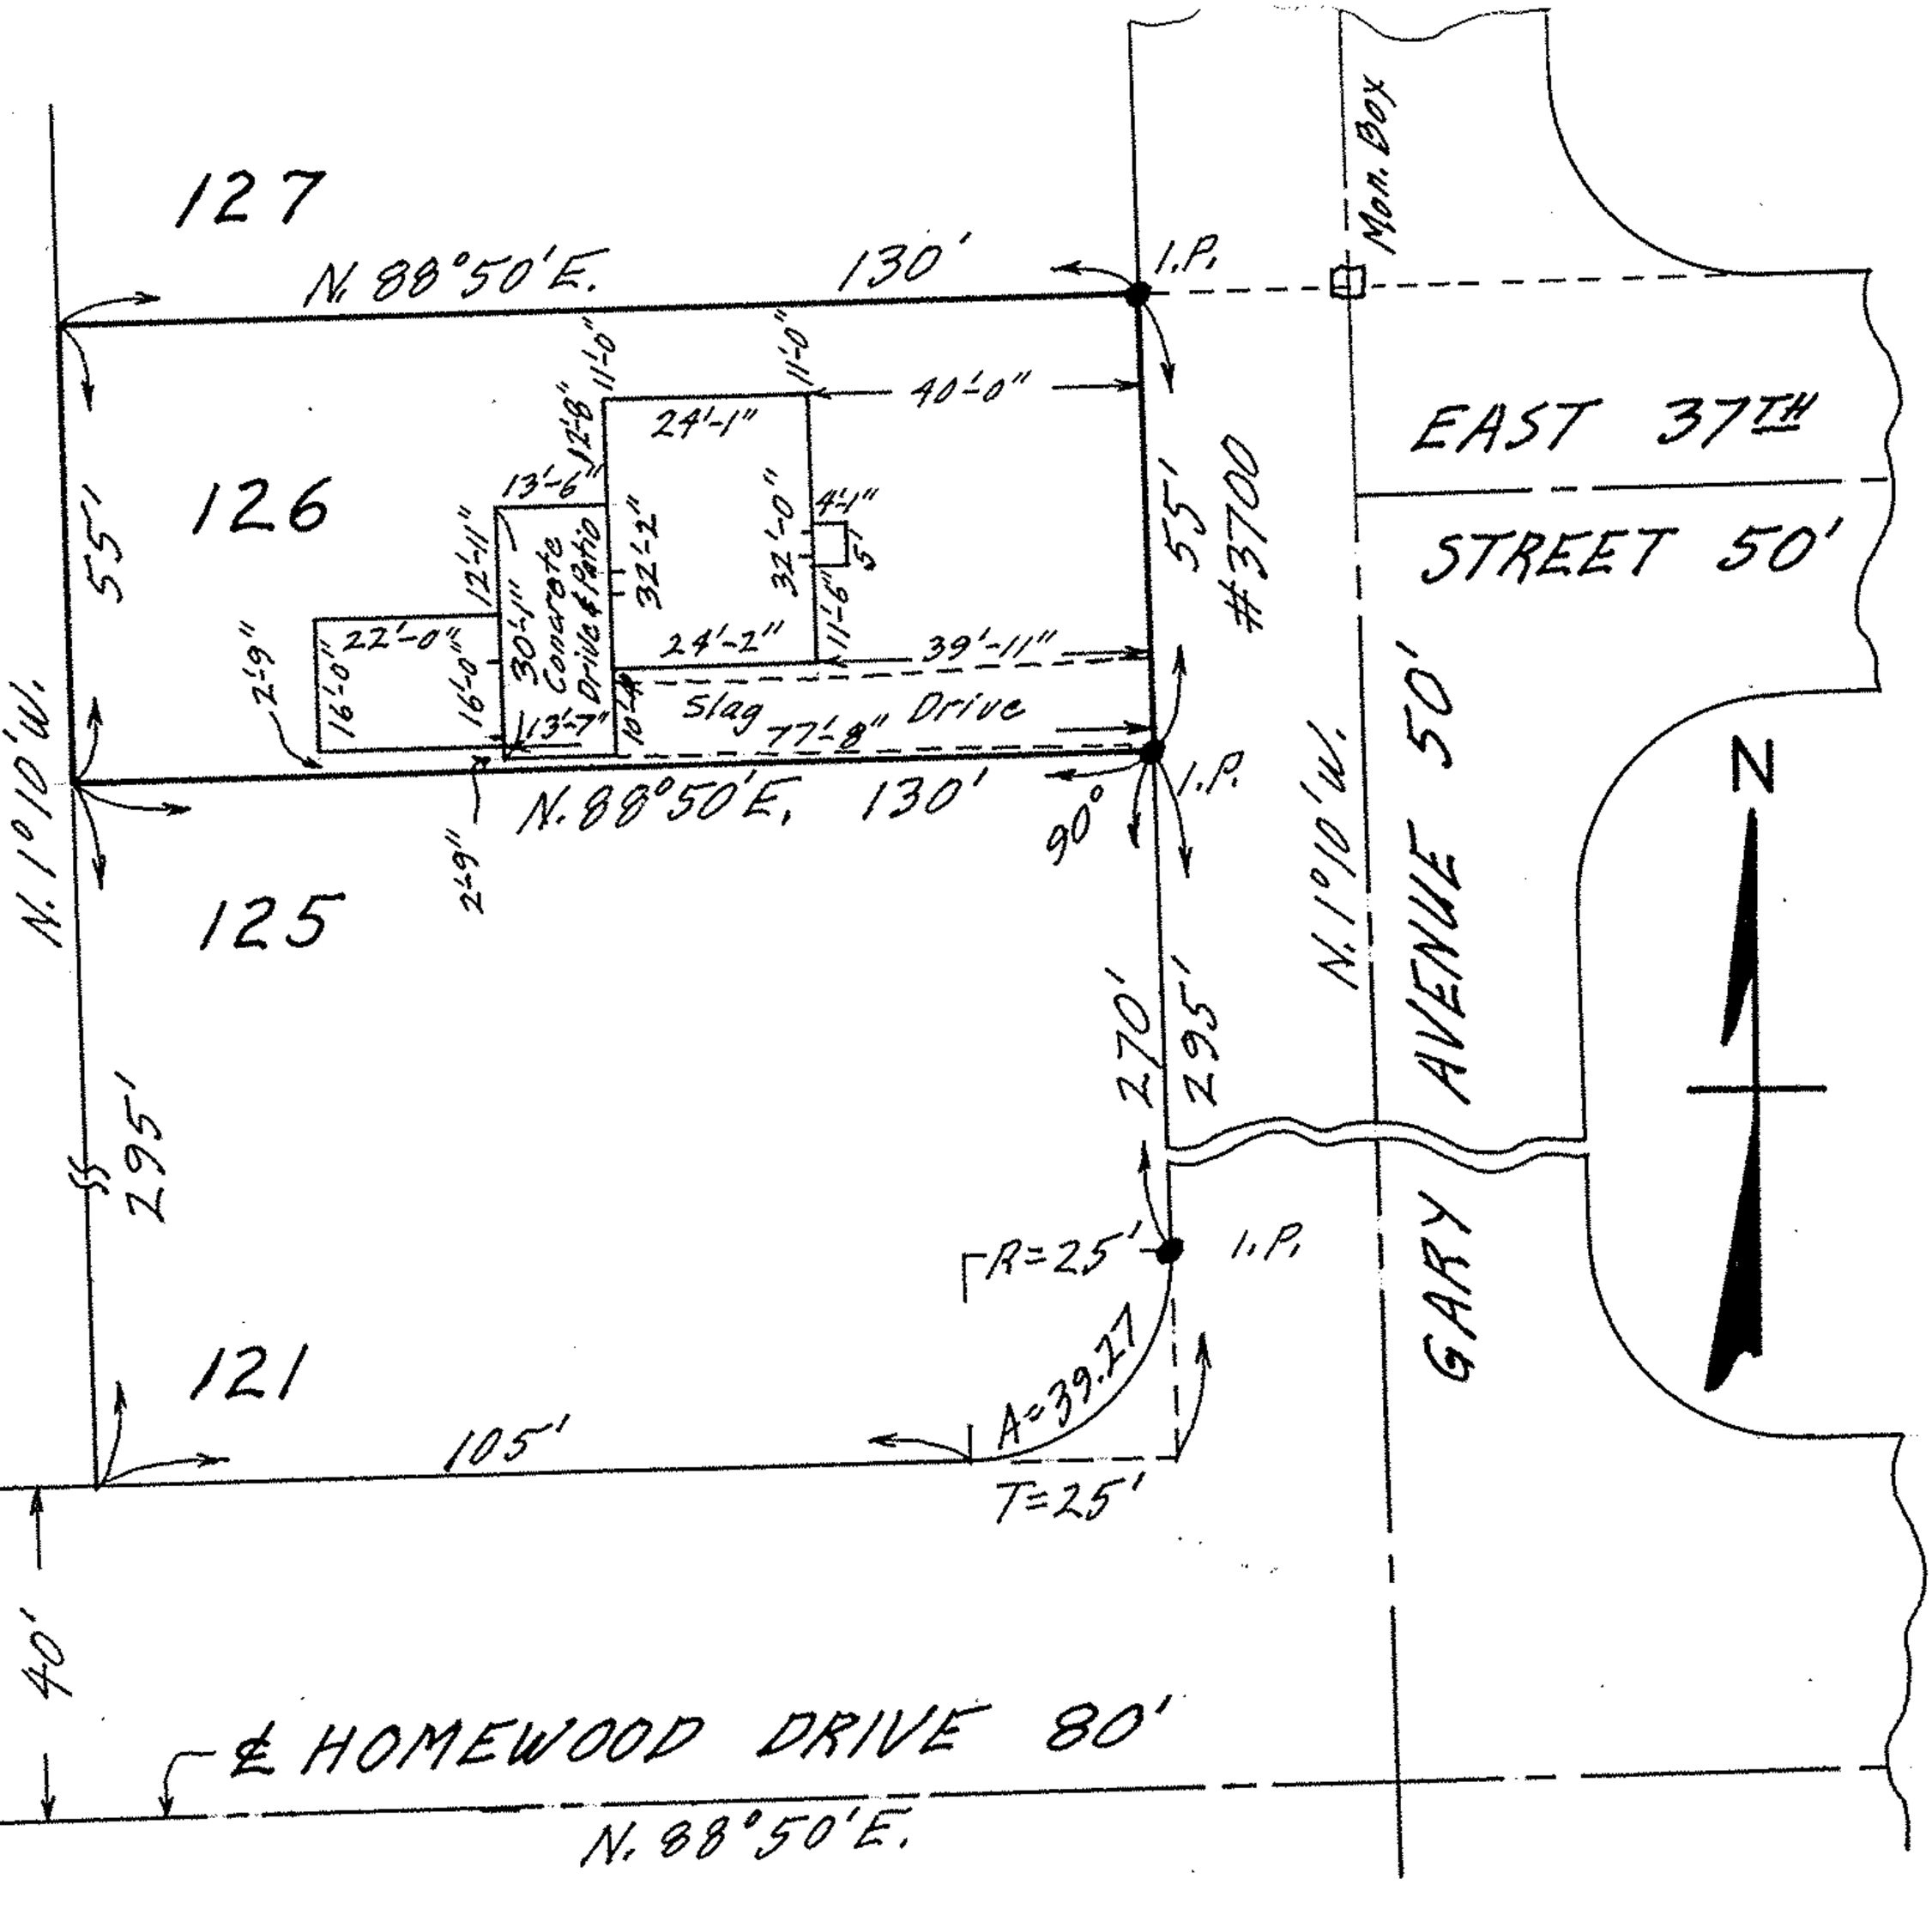

MAP OF SUB-LOT NO. 126
HOMEWOOD ADD'N. VOL. 14 PGS. 22 & 23
ORIG. LOT 99 - SHEFFIELD TWP.
LORAIN CITY - LORAIN COUNTY - OHIO
SCALE: 1" = 30' FEB. 17-1970 5:45 P.M.
NOTE: There are no encroachments on this property.
Gary E. Penfound REG. SURVEYOR NO. 4457
CITY TITLE CO. Order No. E-1039-40
J.C. & Lillian Risner to Harry R. & Leona Cutlip

03-00-099