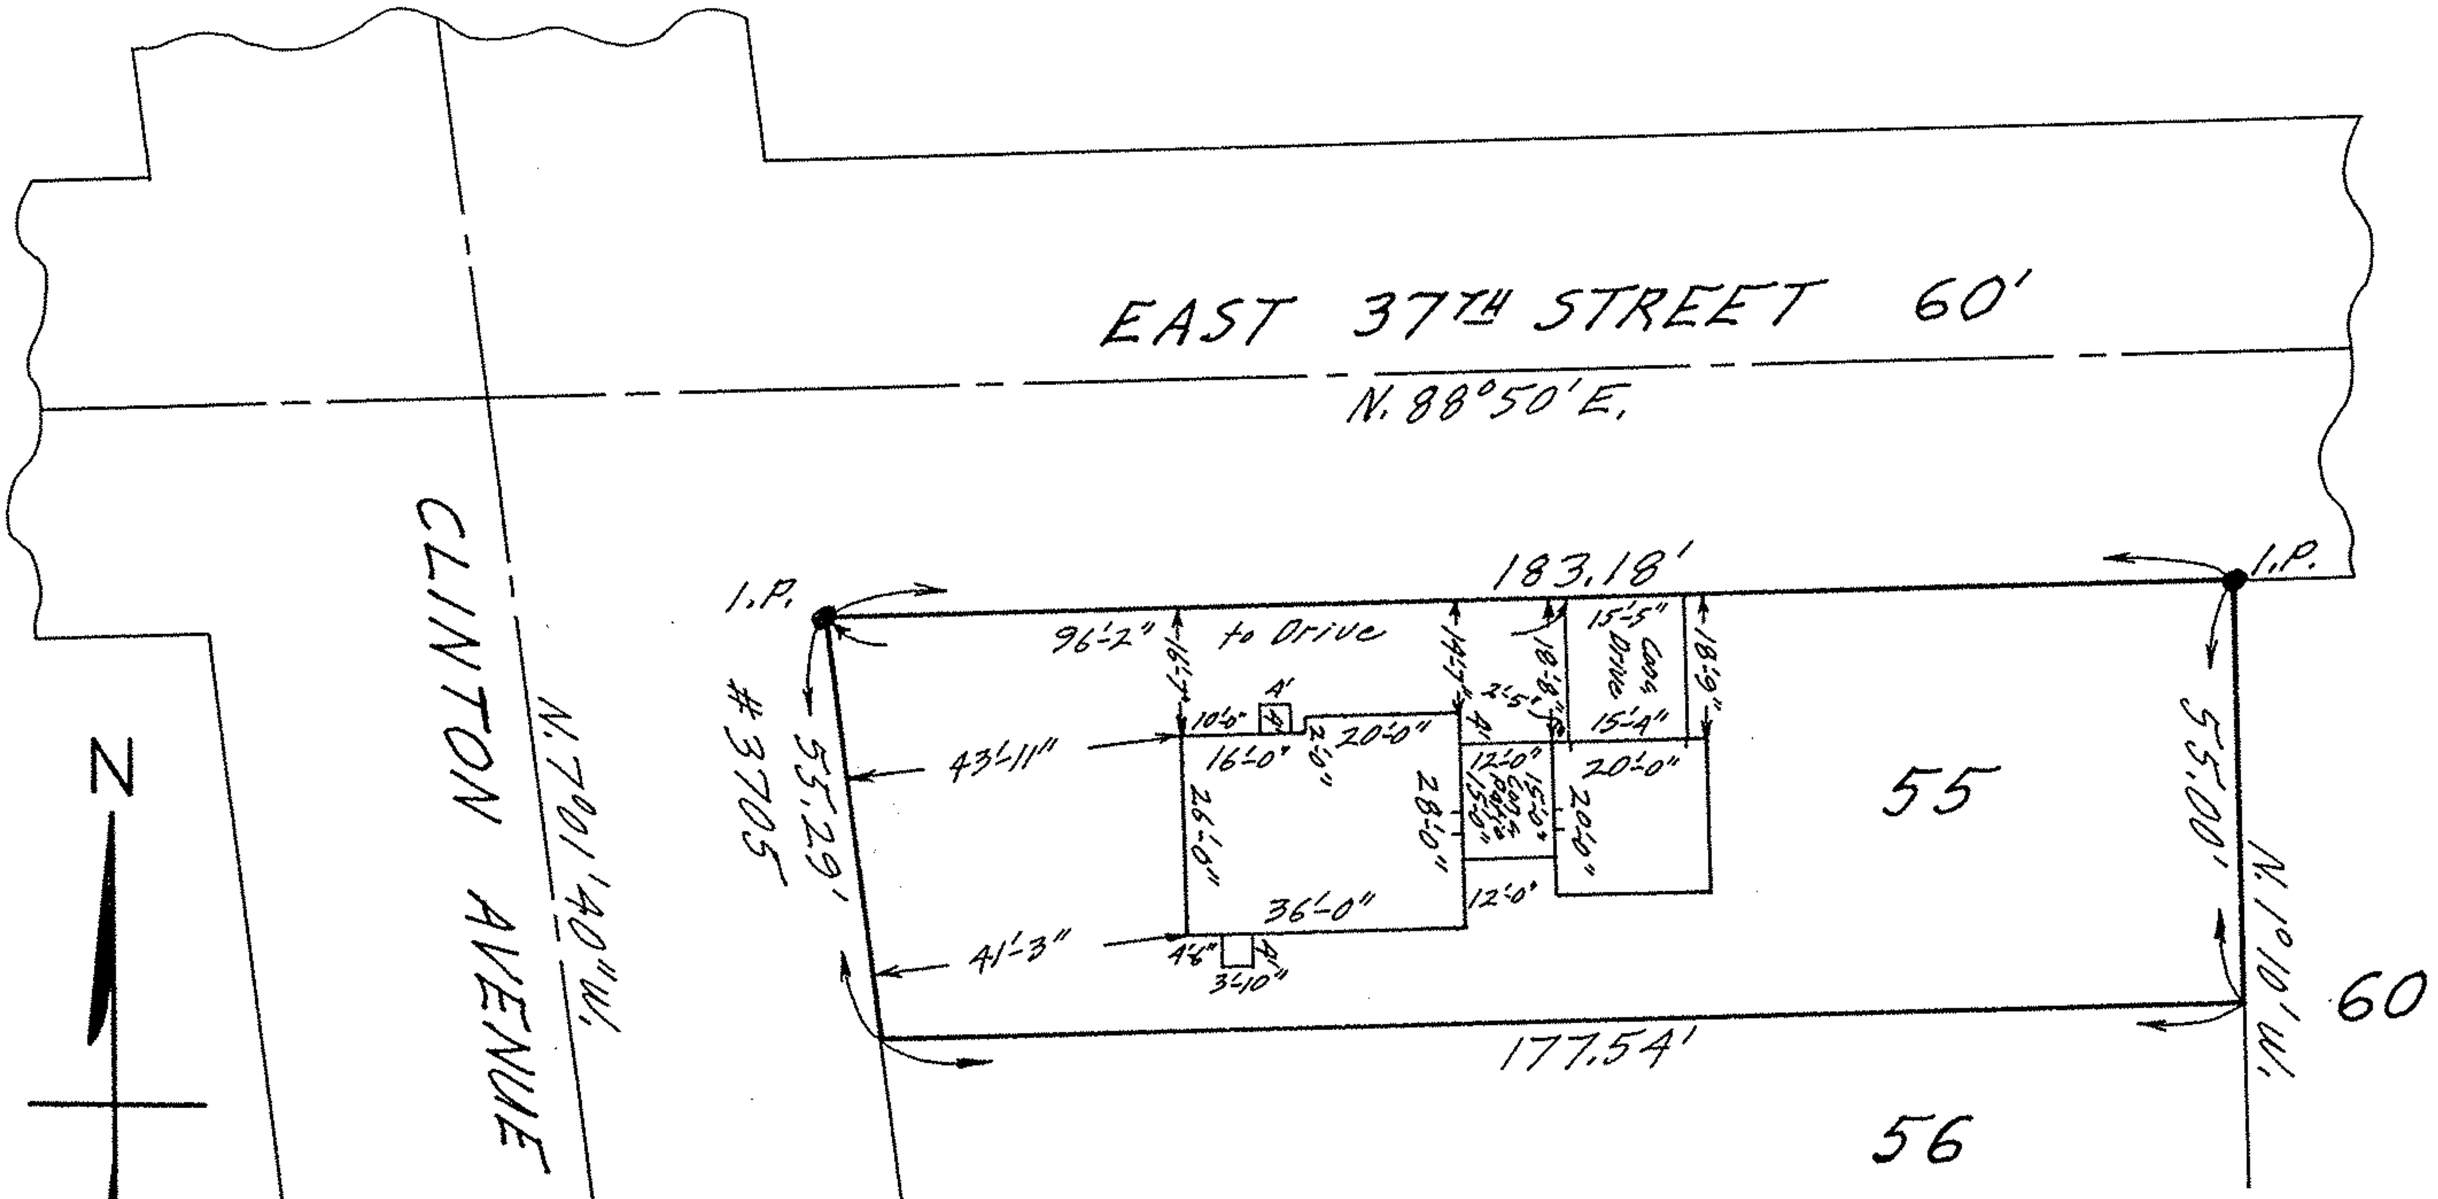

MAP OF SUB-LOT NO. 55
OAKWOOD ACRES SUB'N. NO. 1 VOL. 20 PG. 45
ORIG. LOT NO. 100 SHEFFIELD TOWNSHIP
LORAIN CITY - LORAIN COUNTY - OHIO
SCALE: 1"=30' SEPT. 15-1970 4:00 P.M.
NOTE: There are no encroachments on this property.
Gary E. Penfound REG. SURVEYOR NO. 4457
CITY TITLE Co. Order No. E-1304-5 Pope to Cruz

03-60-100