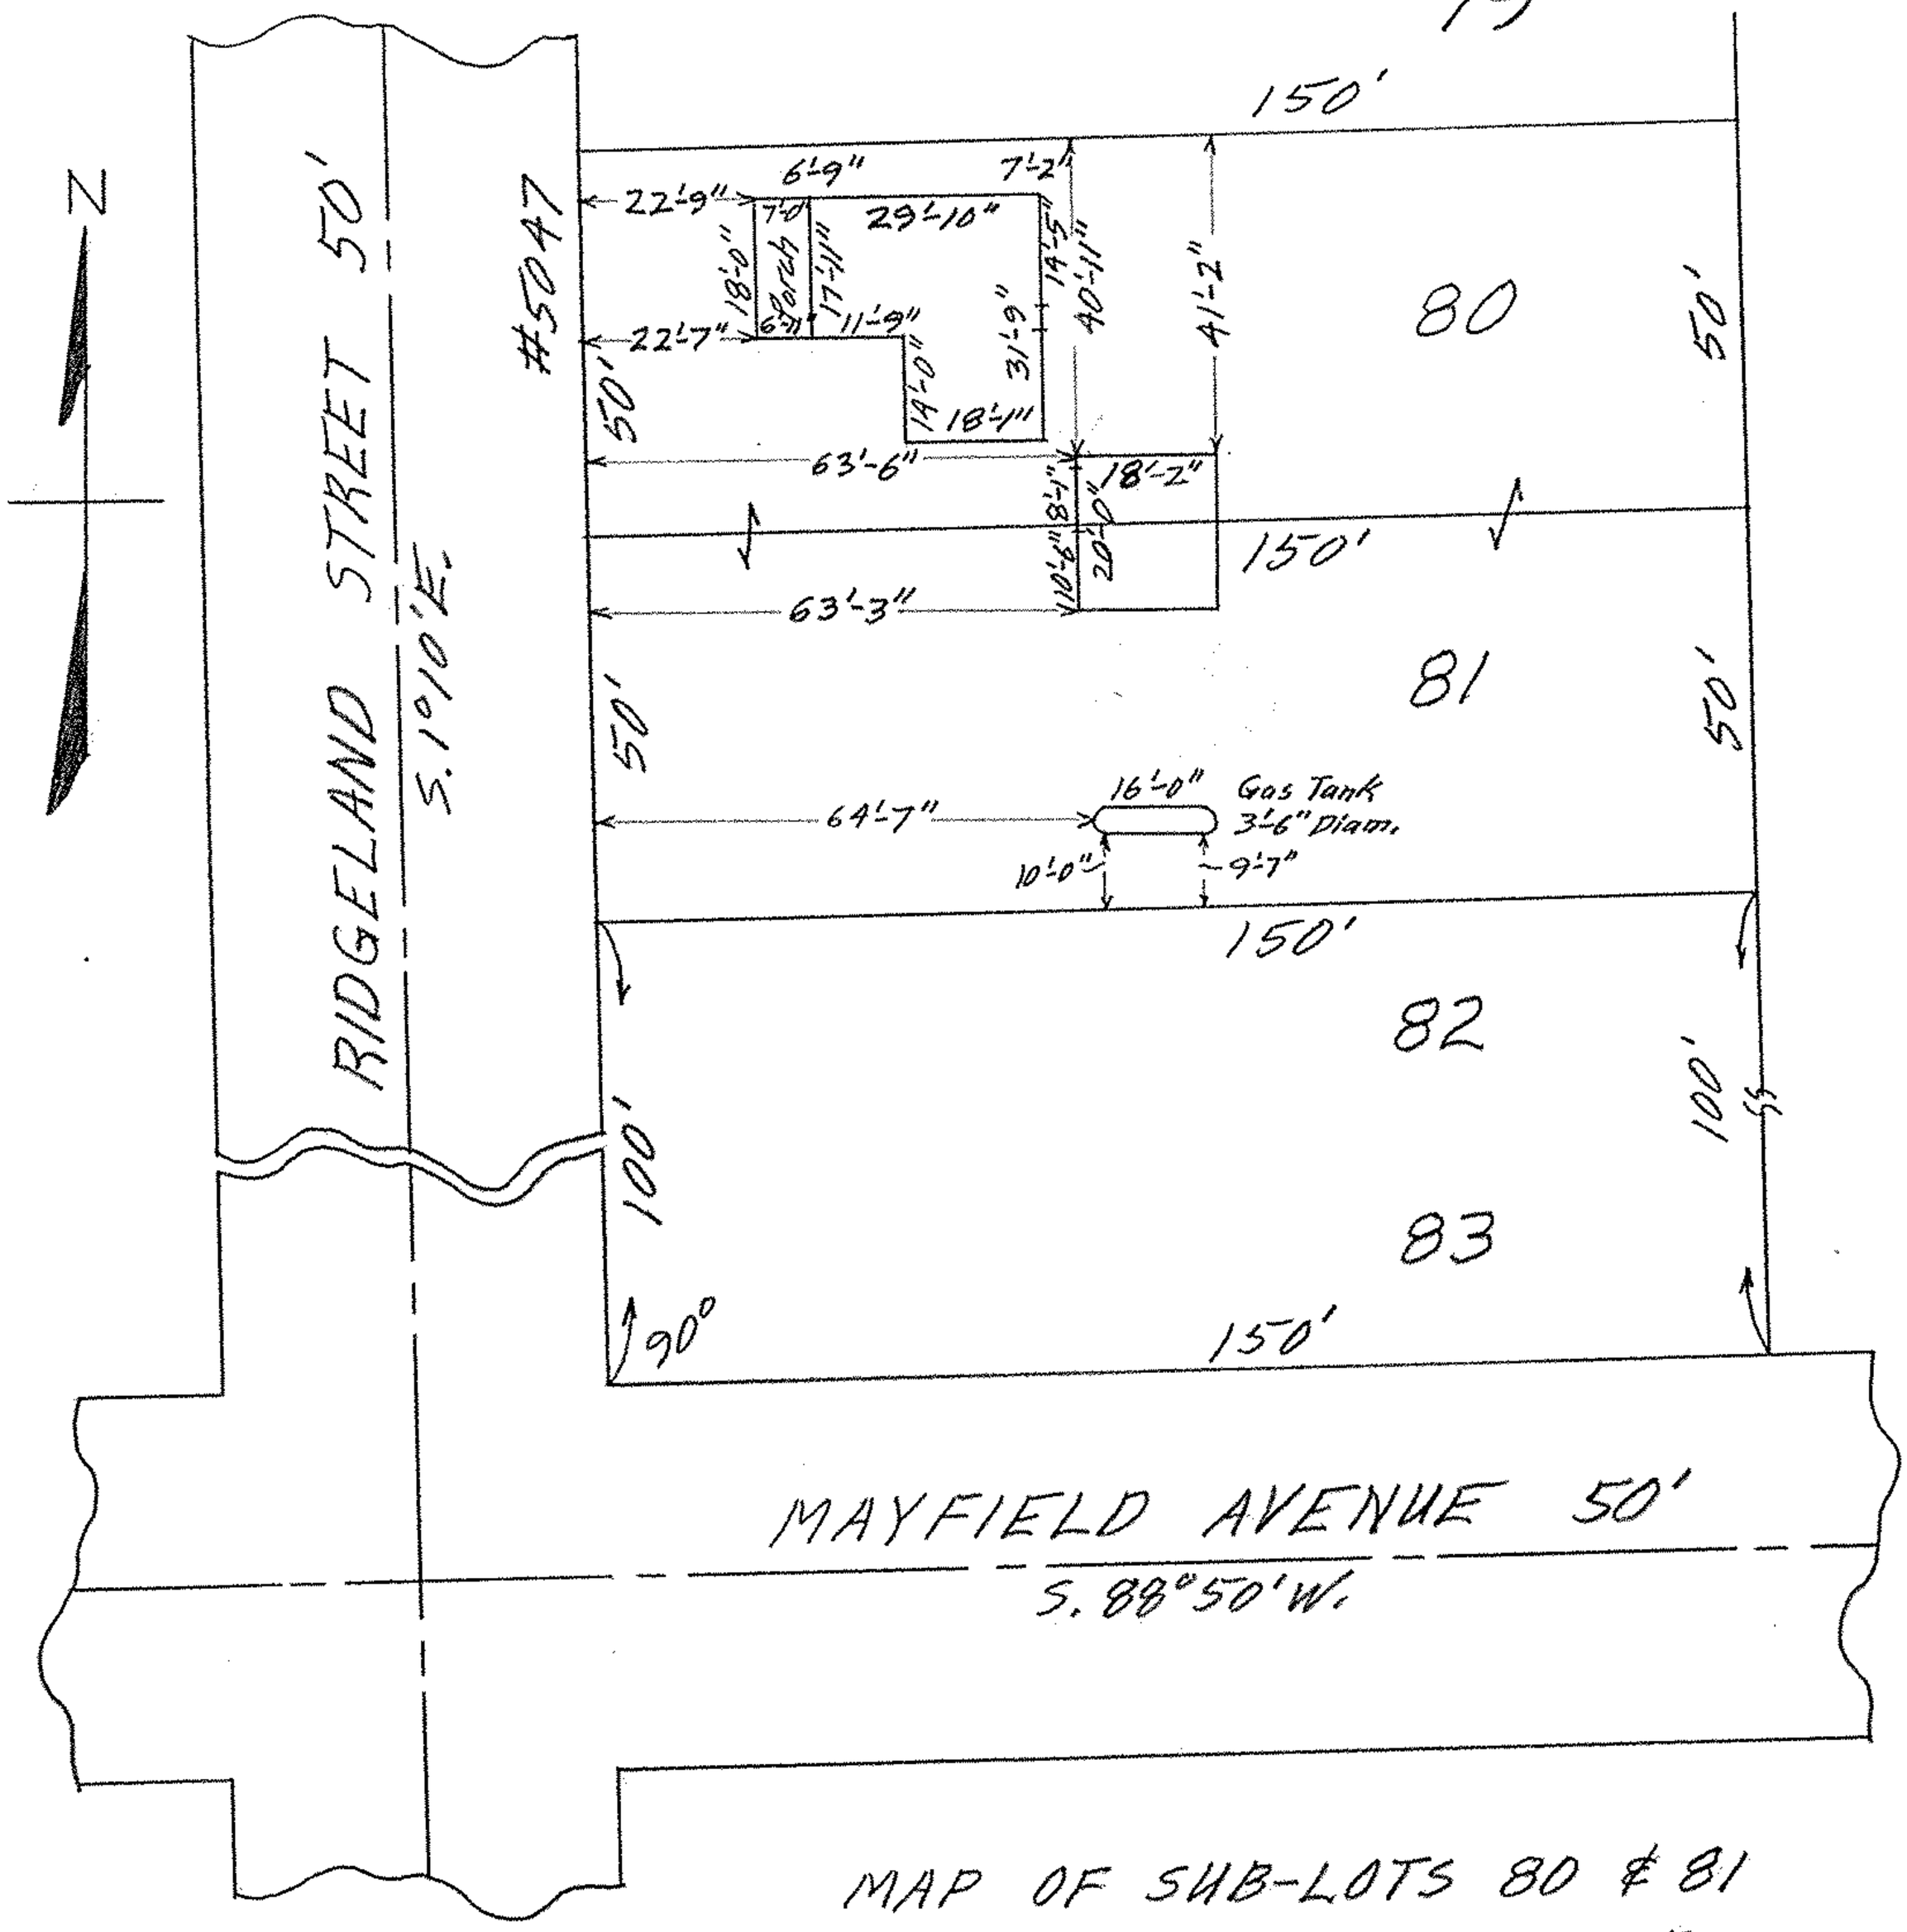

MAP OF SUB-LOTS 80 & 81
RIDGELAND ALL'T. VOL. 8 PG. 39 PLATS
ORIG. LOT NO. 109 SHEFFIELD TWP.
LORAIN COUNTY - OHIO
SCALE: 1"=30' FEB. 27-1963 3:30 P.M.
Gary E. Penfound REG. SURVEYOR

Horace J. & Janet I. Lobertini'

BH

03-00-109 BH