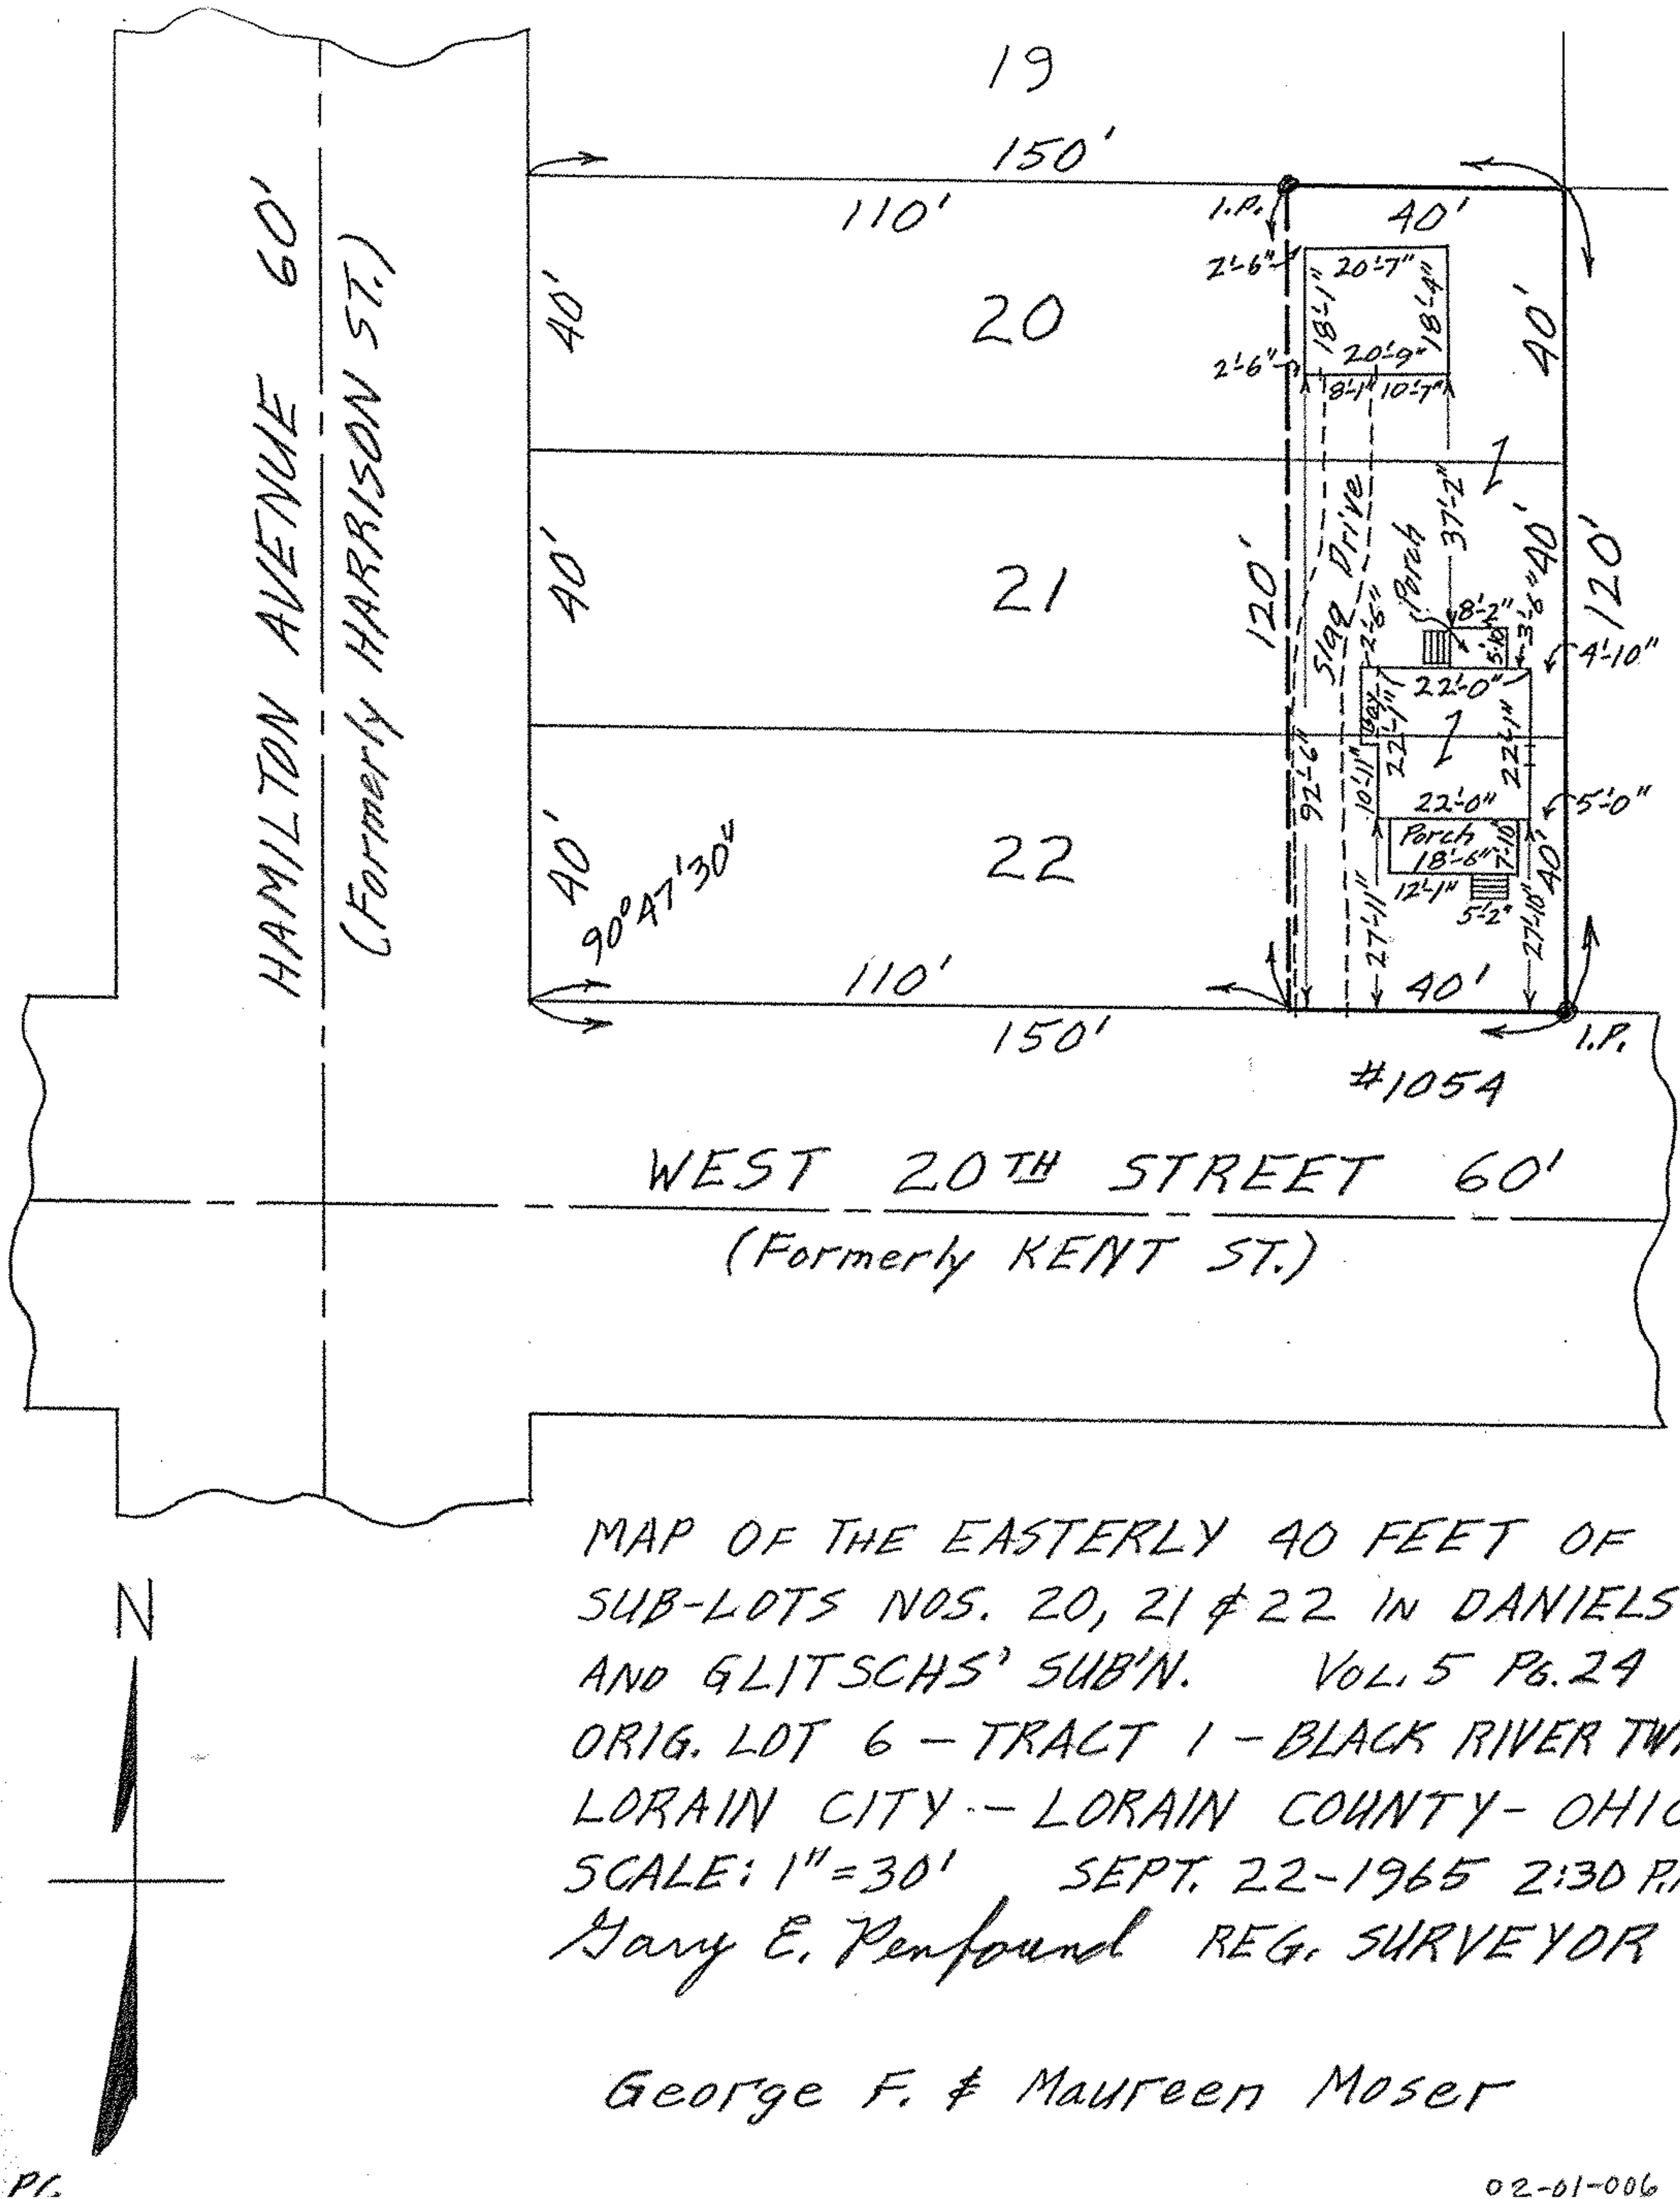

MAP OF THE EASTERLY 40 FEET OF SUB-LOTS NOS. 20, 21 & 22 IN DANIELS' AND GLITSCHS' SUB'N. VOL. 5 PG. 24
ORIG. LOT 6 – TRACT 1 – BLACK RIVER TWP.
LORAIN CITY – LORAIN COUNTY – OHIO
SCALE: 1" = 30' SEPT. 22-1965 2:30 P.M.
Gary E. Penfound REG. SURVEYOR

George F. & Maureen Moser

Pl.

02-01-006