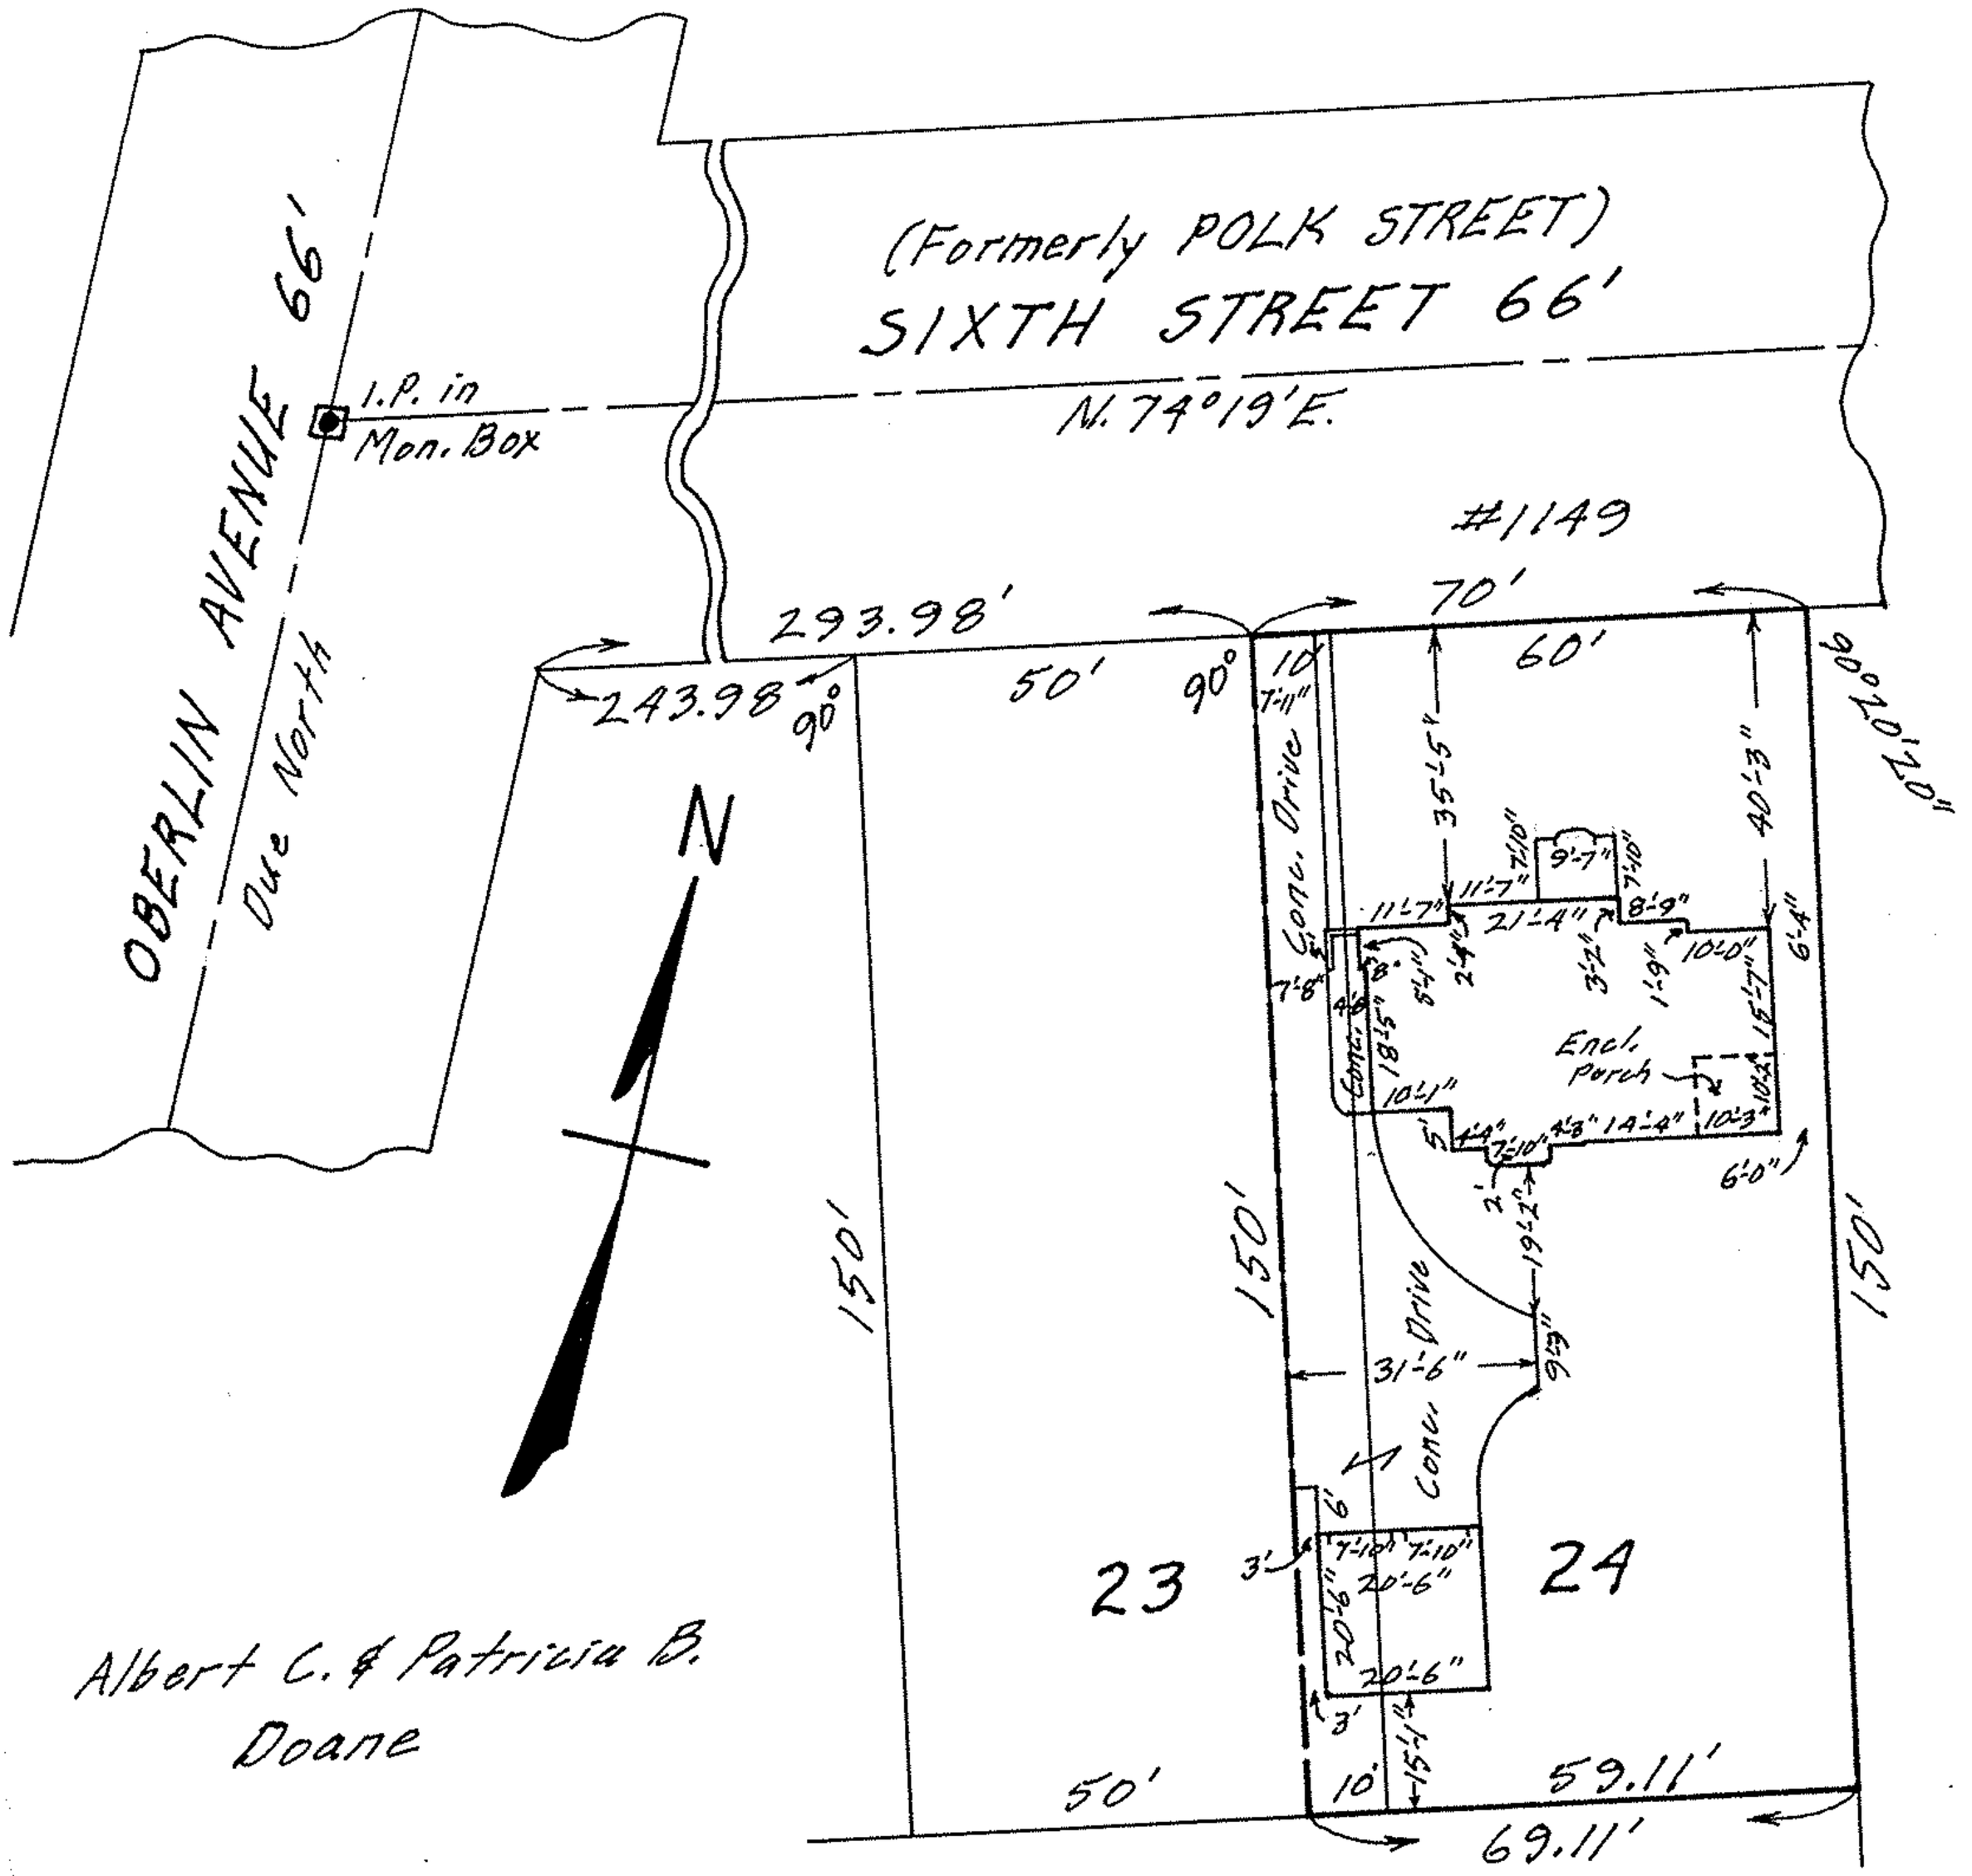

MAP OF SUB-LOT 24 AND EASTERLY
10 FEET OF SUB-LOT 23 OF
CONRAD KRANZ ADD'N. - VOL. 4 PG. 8
O.L. 6 - TR. 1 - BLACK RIVER TWP.
LORAIN CITY - LORAIN COUNTY - OHIO
SCALE: 1"=30' MAY 21-1968 4:00 P.M.
Gary E. Penfound REG. SURVEYOR

02-01-006 PC