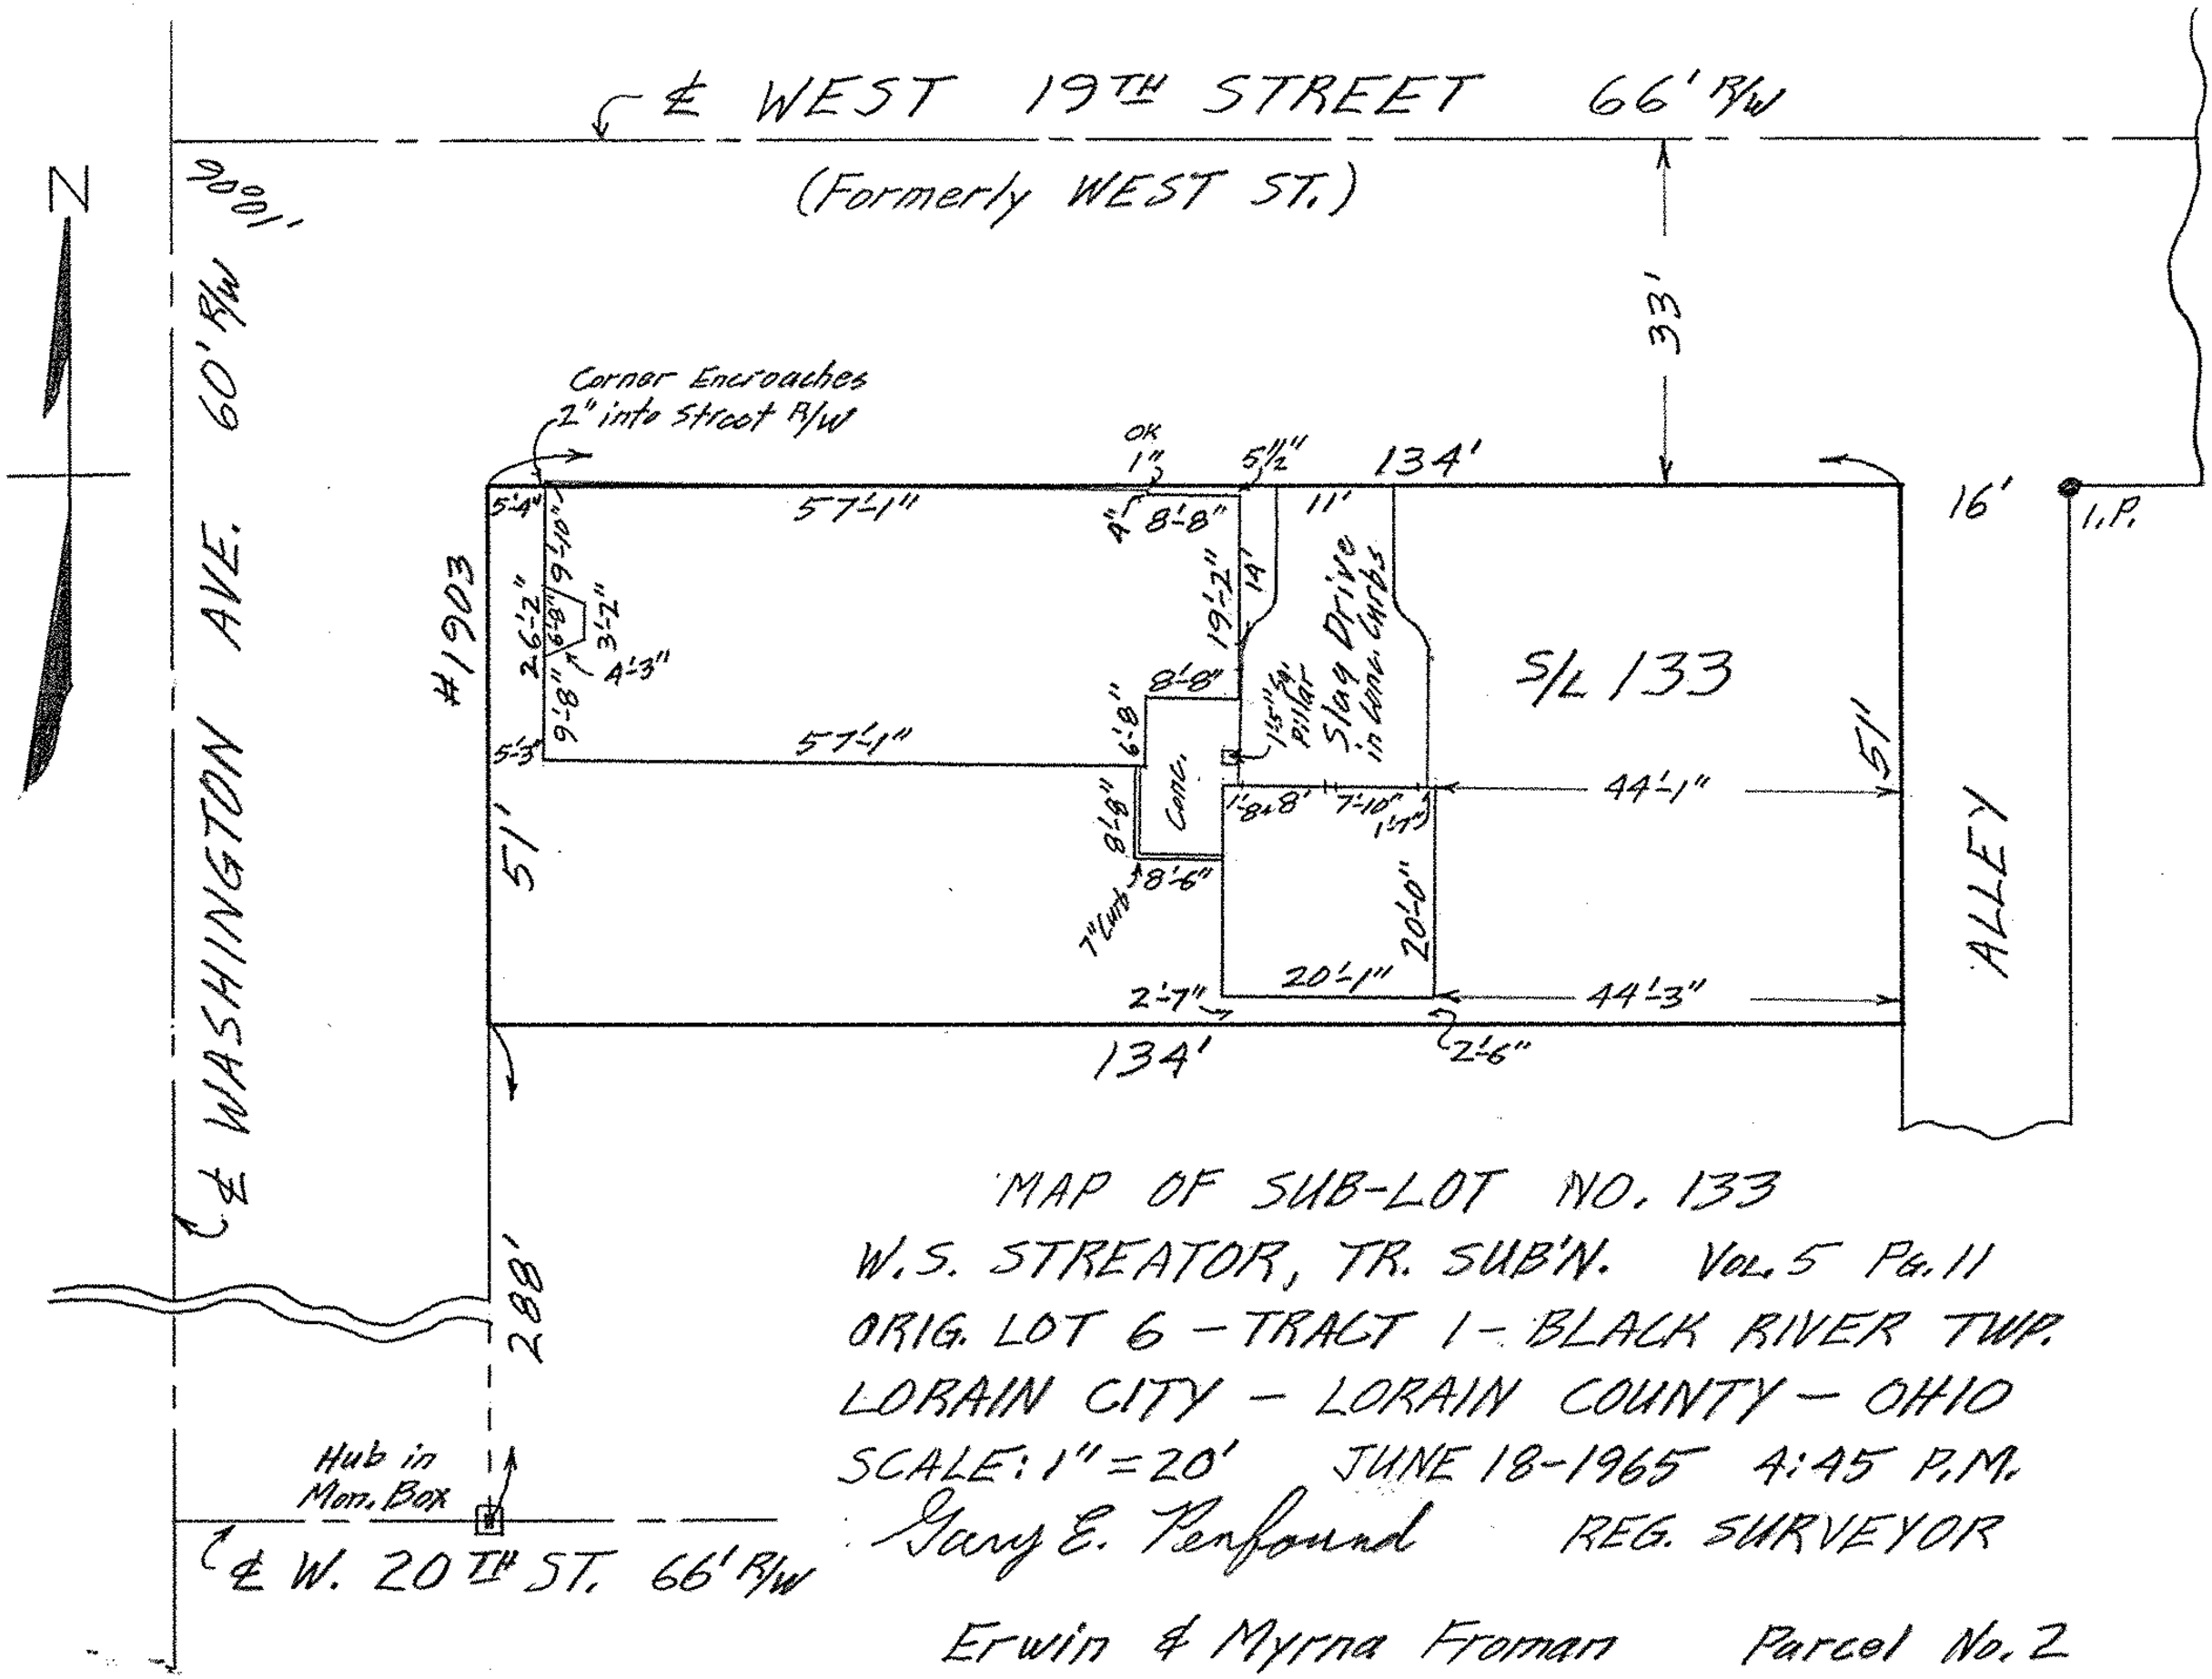

MAP OF SUB-LOT NO. 133
W.S. STREATOR, TR. SUB'N. VOL. 5 PG. 11
ORIG. LOT 6 - TRACT 1 - BLACK RIVER TWP.
LORAIN CITY - LORAIN COUNTY - OHIO
SCALE: 1" = 20' JUNE 18-1965 4:45 P.M.
Gary E. Penfound REG. SURVEYOR

Erwin & Myrna Froman Parcel No. 2

02-01-006 BH