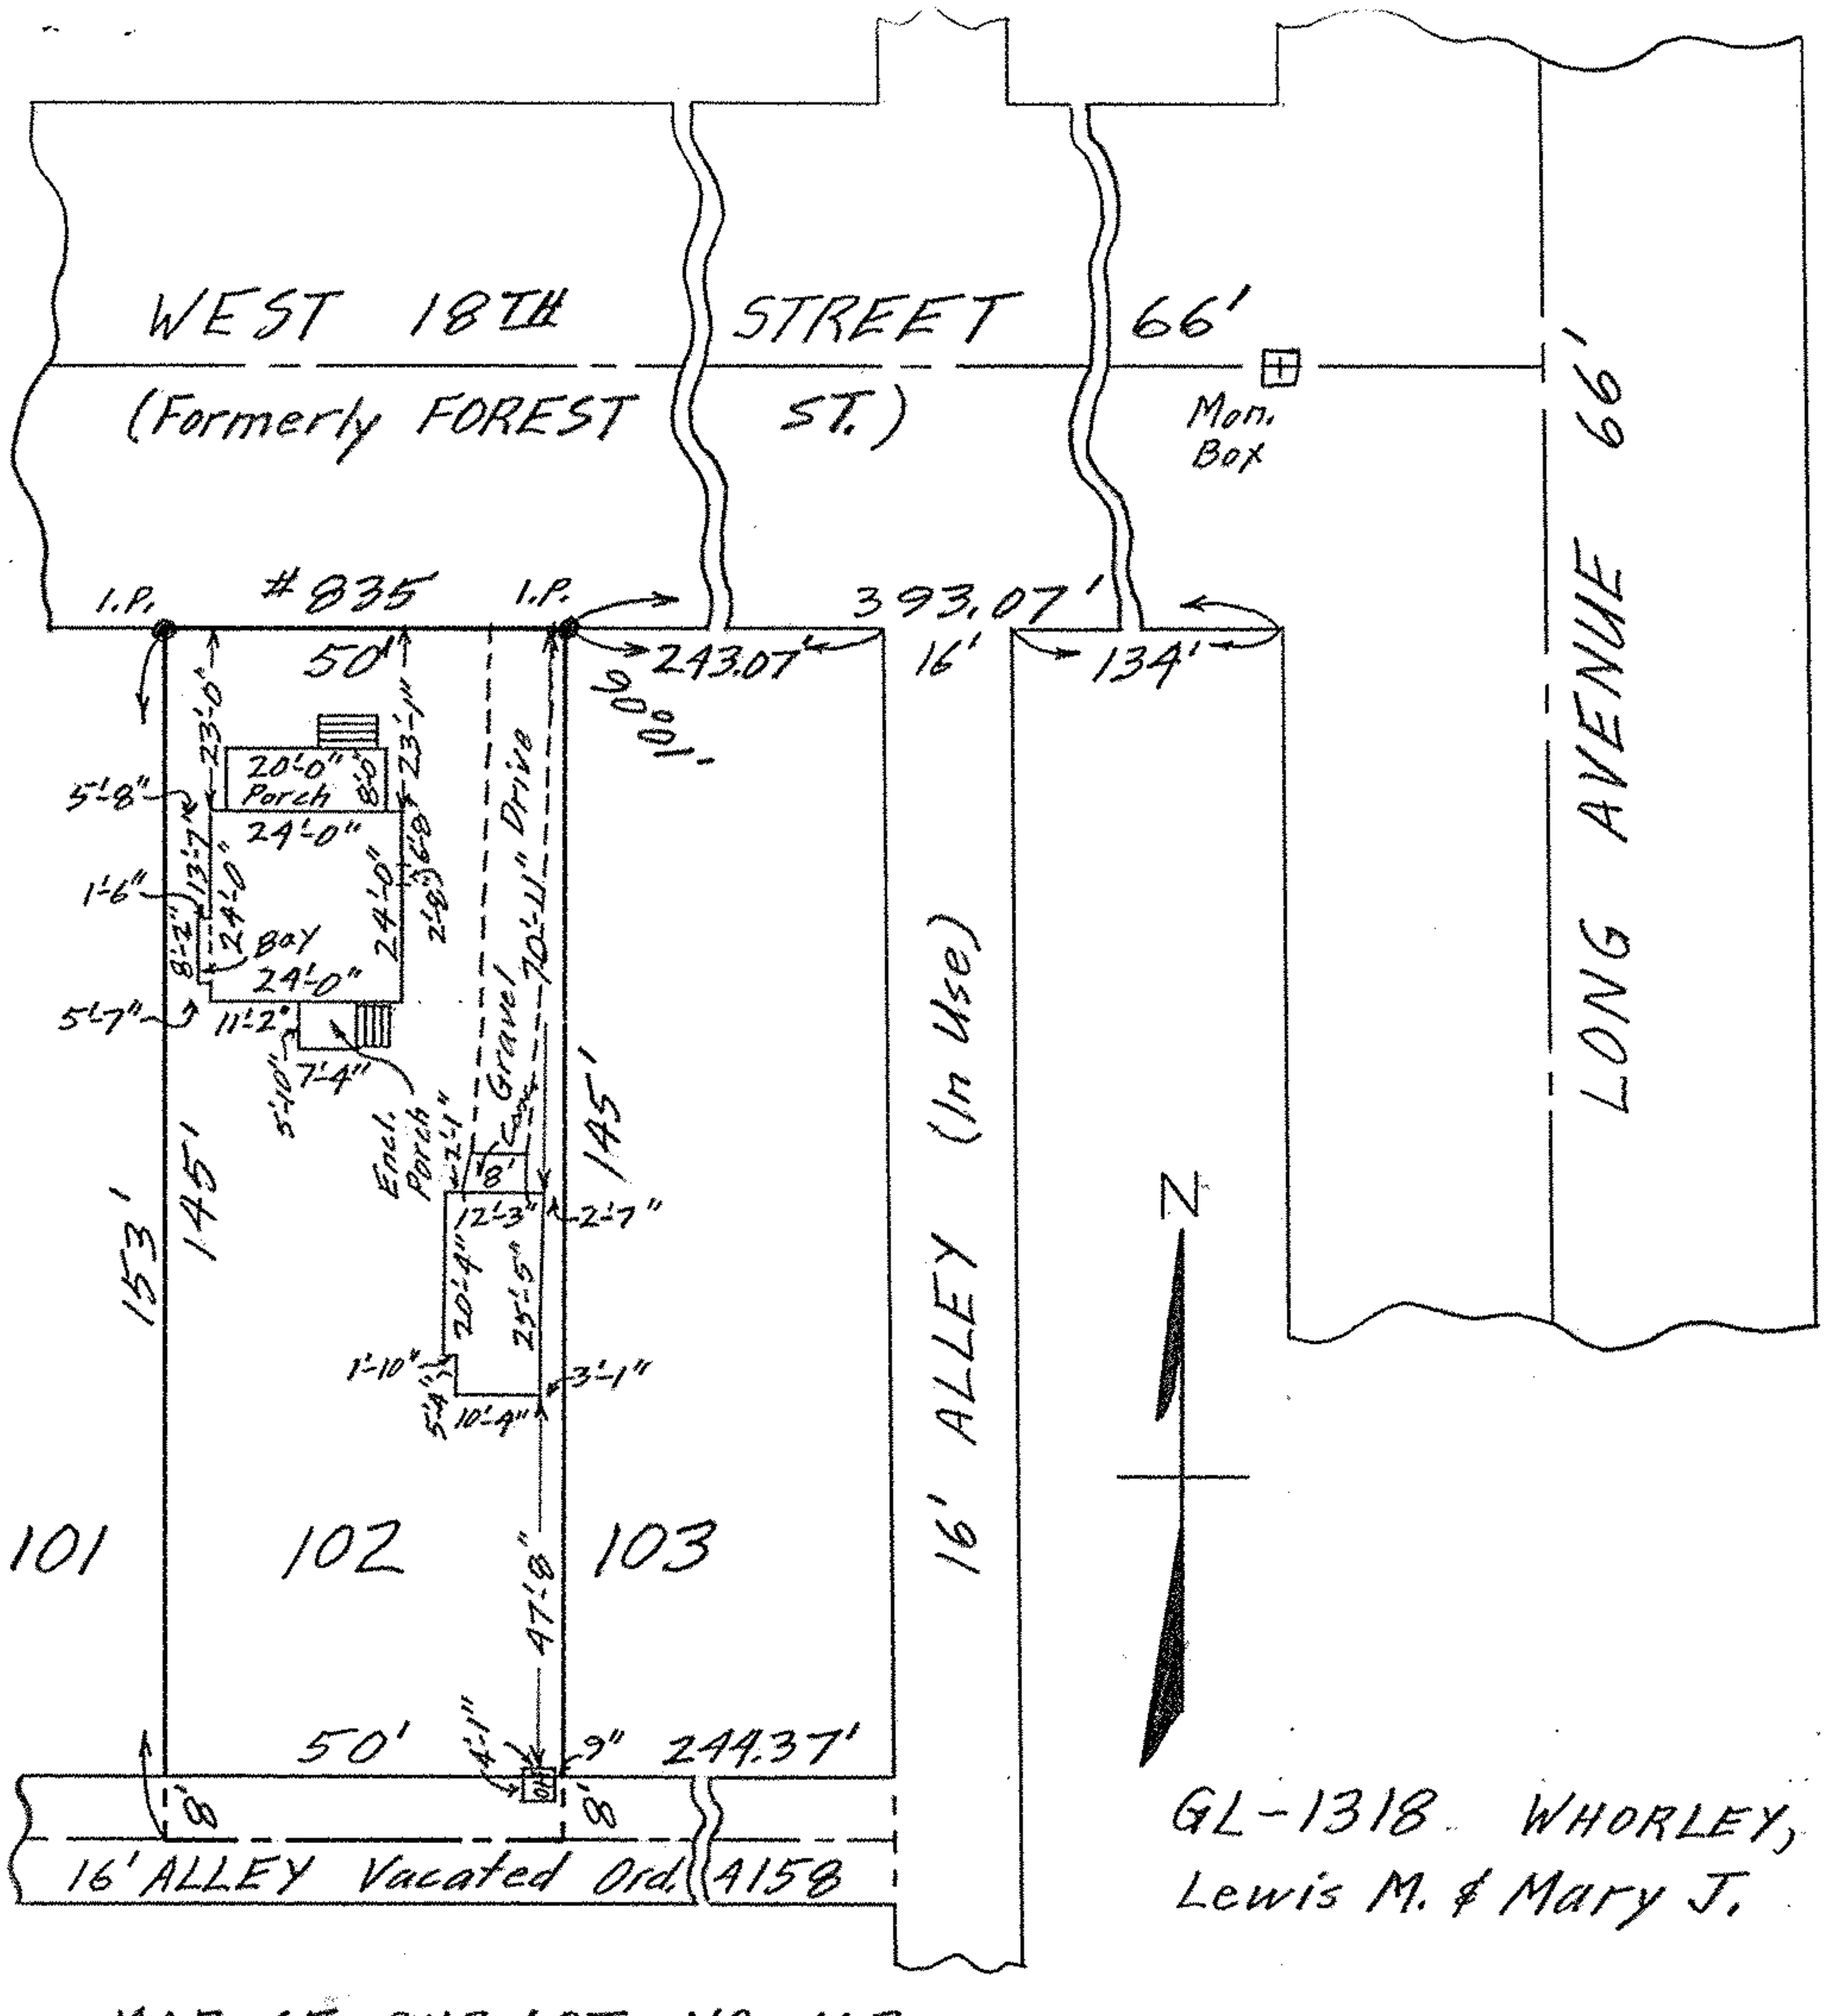

GL-1318 WHORLEY, Lewis M. & Mary J.

MAP OF SUB-LOT NO. 102
W. S. STREATOR, TR. SUB'N. VOL. 5 PG. 11
ORIG. LOT 6 - TRACT 1 - BLACK RIVER TWP.
LORAIN CITY - LORAIN COUNTY - OHIO
SCALE: 1" = 30' OCT. 14-1965 3:45 P.M.
Gary E. Penfound
for C.E. Penfound REG. SURVEYORS

02-01-006