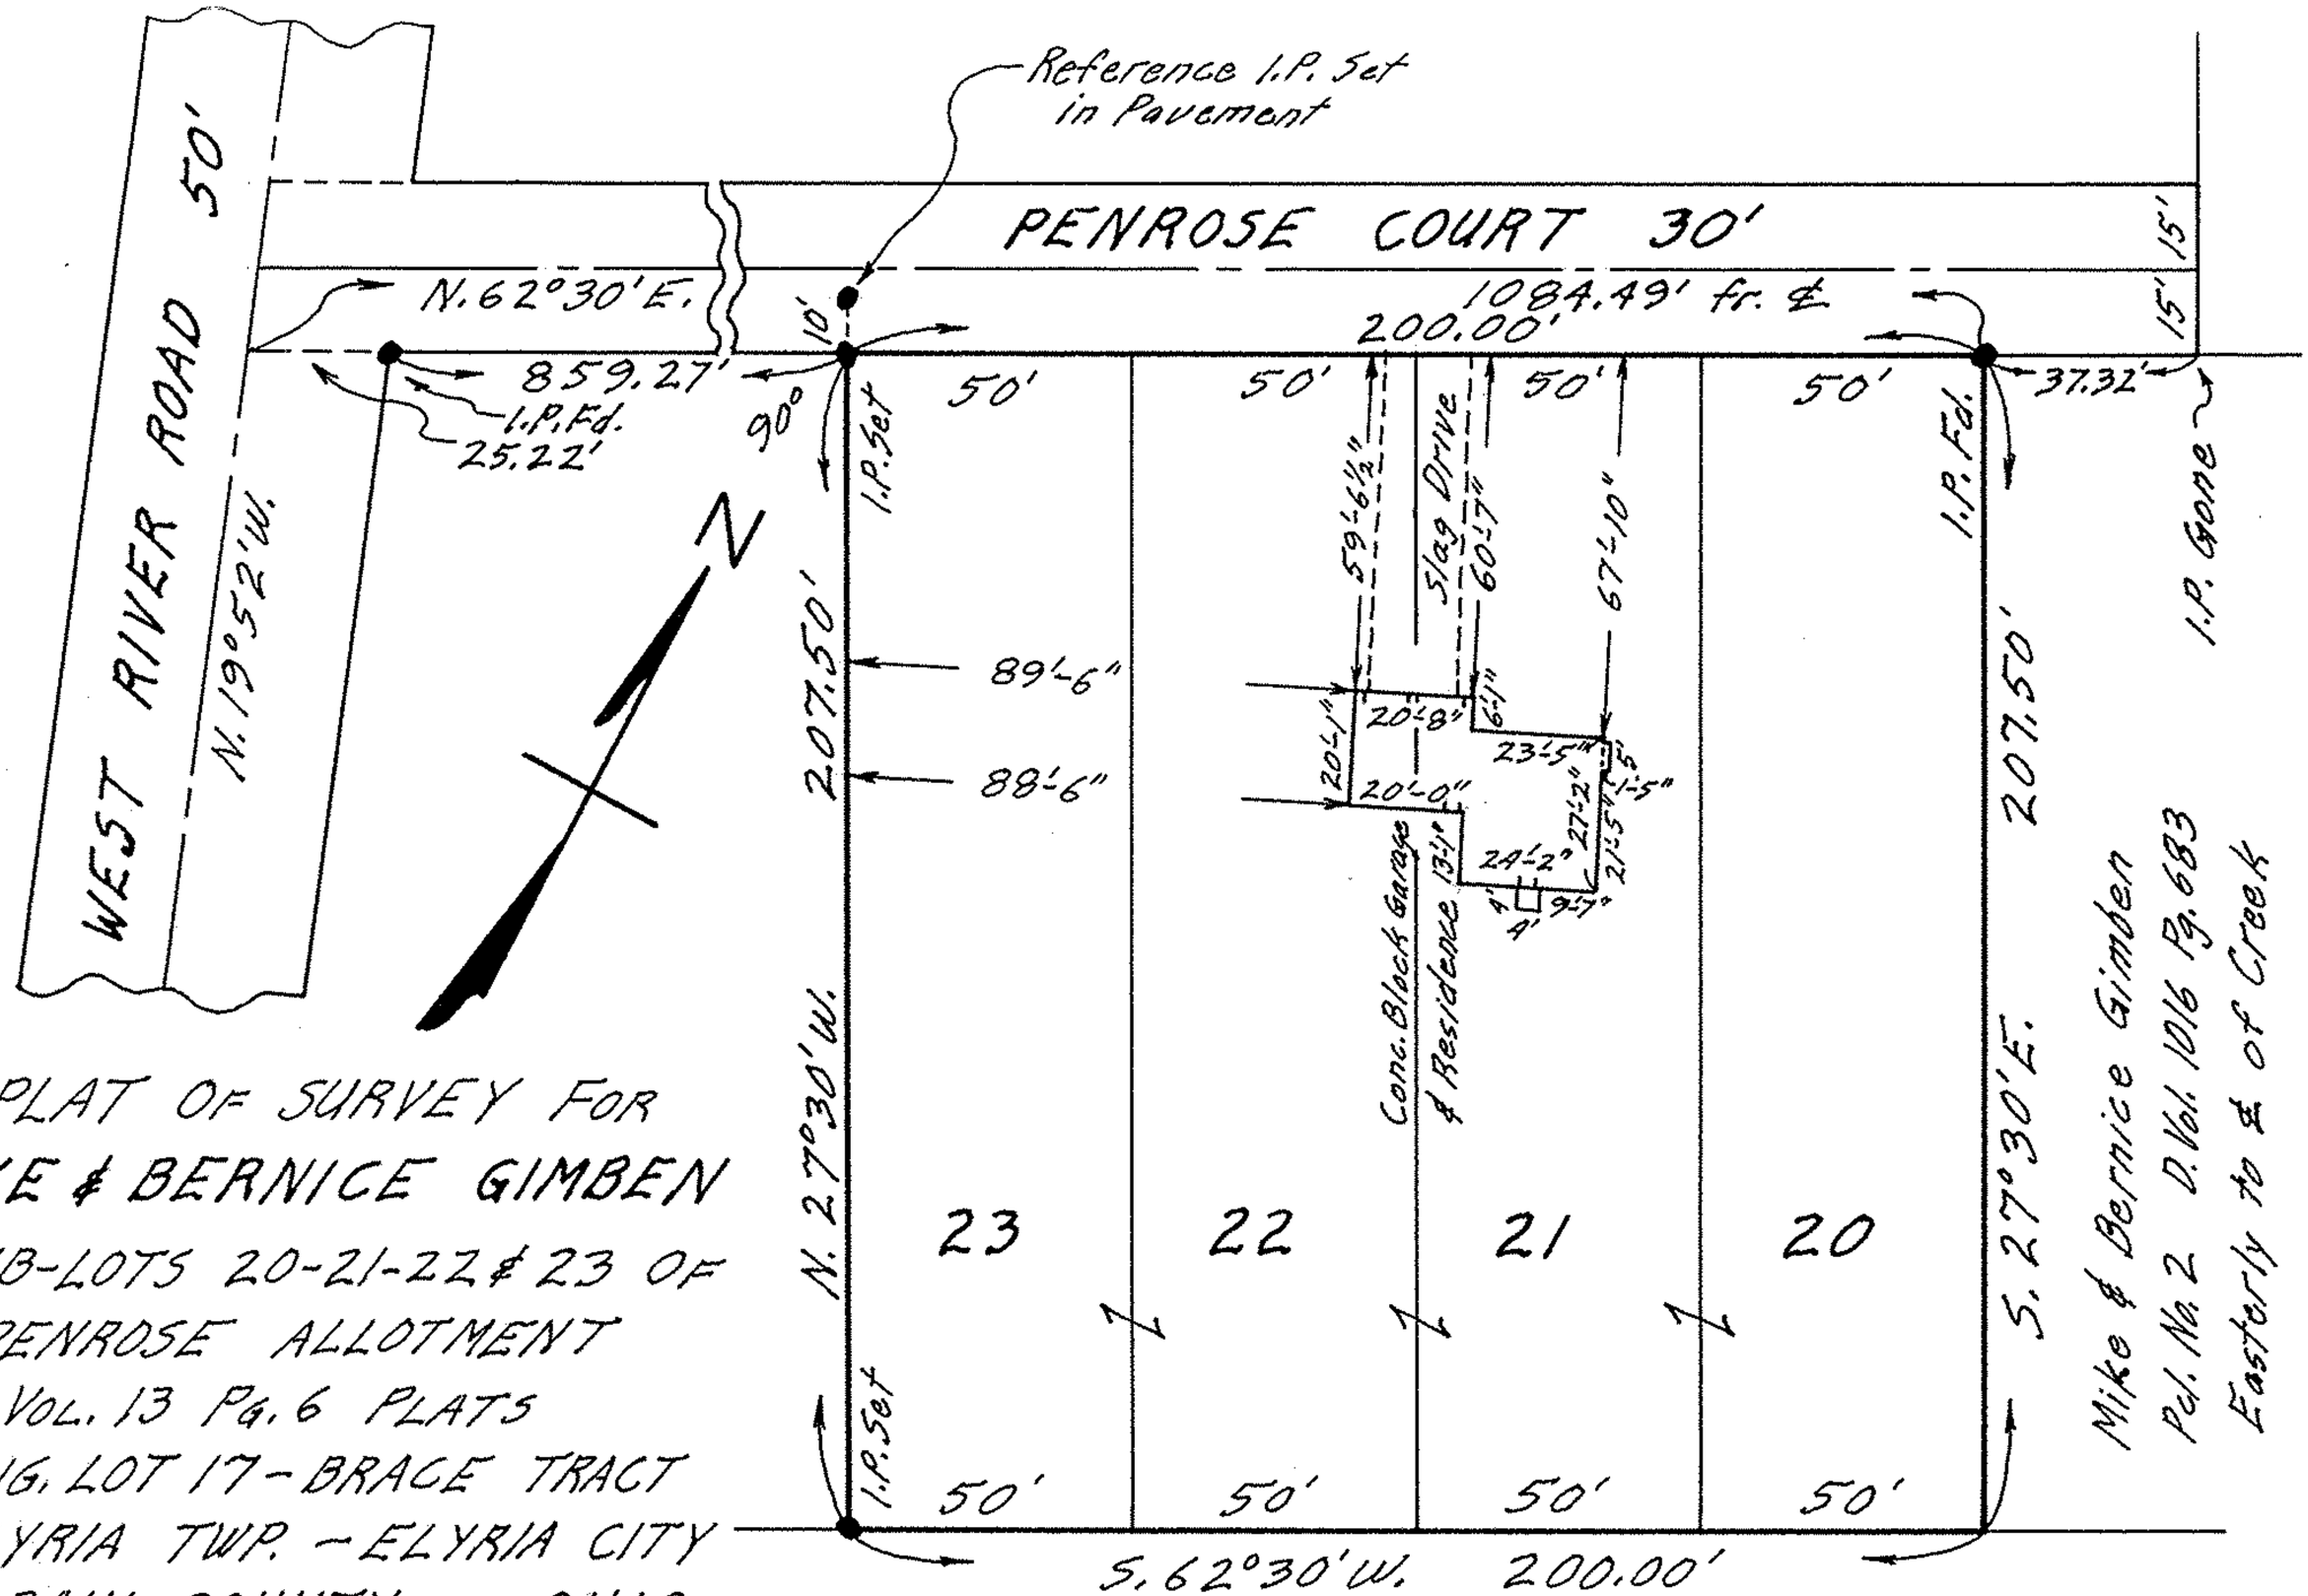


PLAT OF SURVEY FOR

MIKE & BERNICE GIMBEN

SUB-LOTS 20-21-22 & 23 OF
PENROSE ALLOTMENT
VOL. 13 PG. 6 PLATS
ORIG. LOT 17 - BRACE TRACT
ELYRIA TWP. - ELYRIA CITY
LORAIN COUNTY - OHIO
SCALE 1"=40' JAN. 16-1973

Gary E. Penfound Reg. Surveyor No. 4457