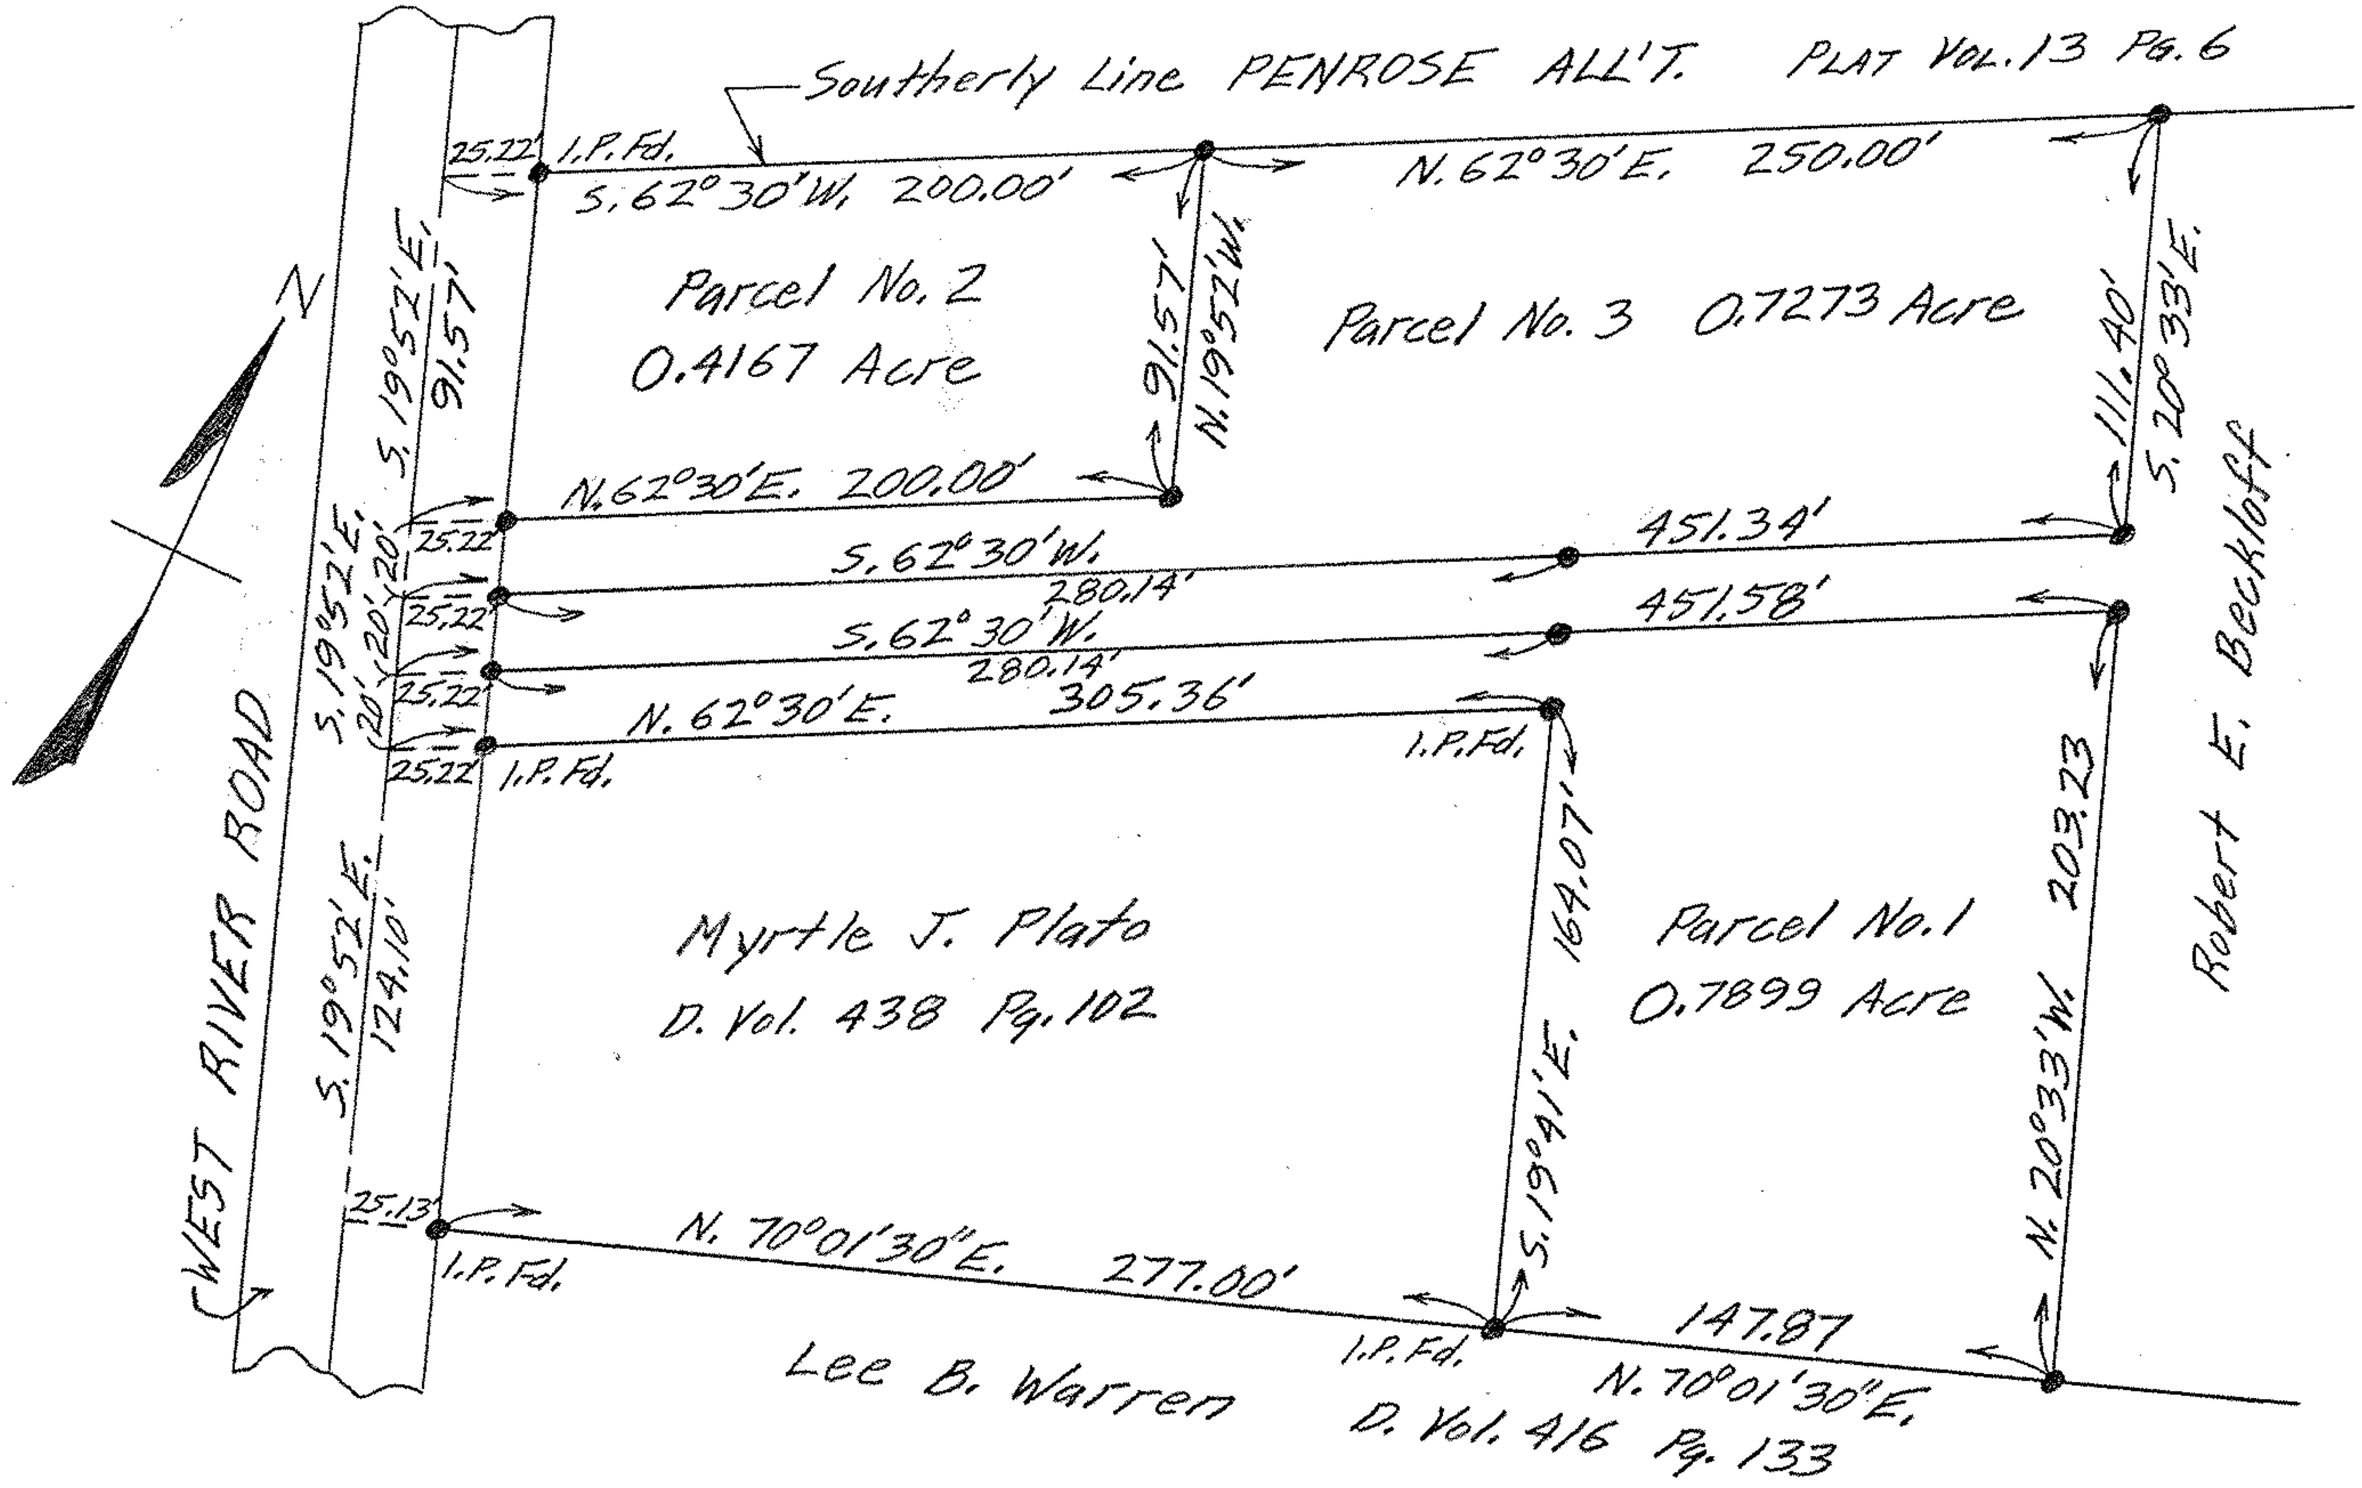

PLAT OF SURVEY FOR SHERWOOD R., JR. & LENORA BYAM

ORIGINAL LOT 17 - BRACE TRACT - ELYRIA TOWNSHIP

ELYRIA CITY LORAIN COUNTY OHIO

SCALE: 1" = 60' AUGUST 31 - 1961

Gary E. Penfound Reg. Surveyor No. 4457

NOTE: ● indicates iron pin set unless otherwise designated.