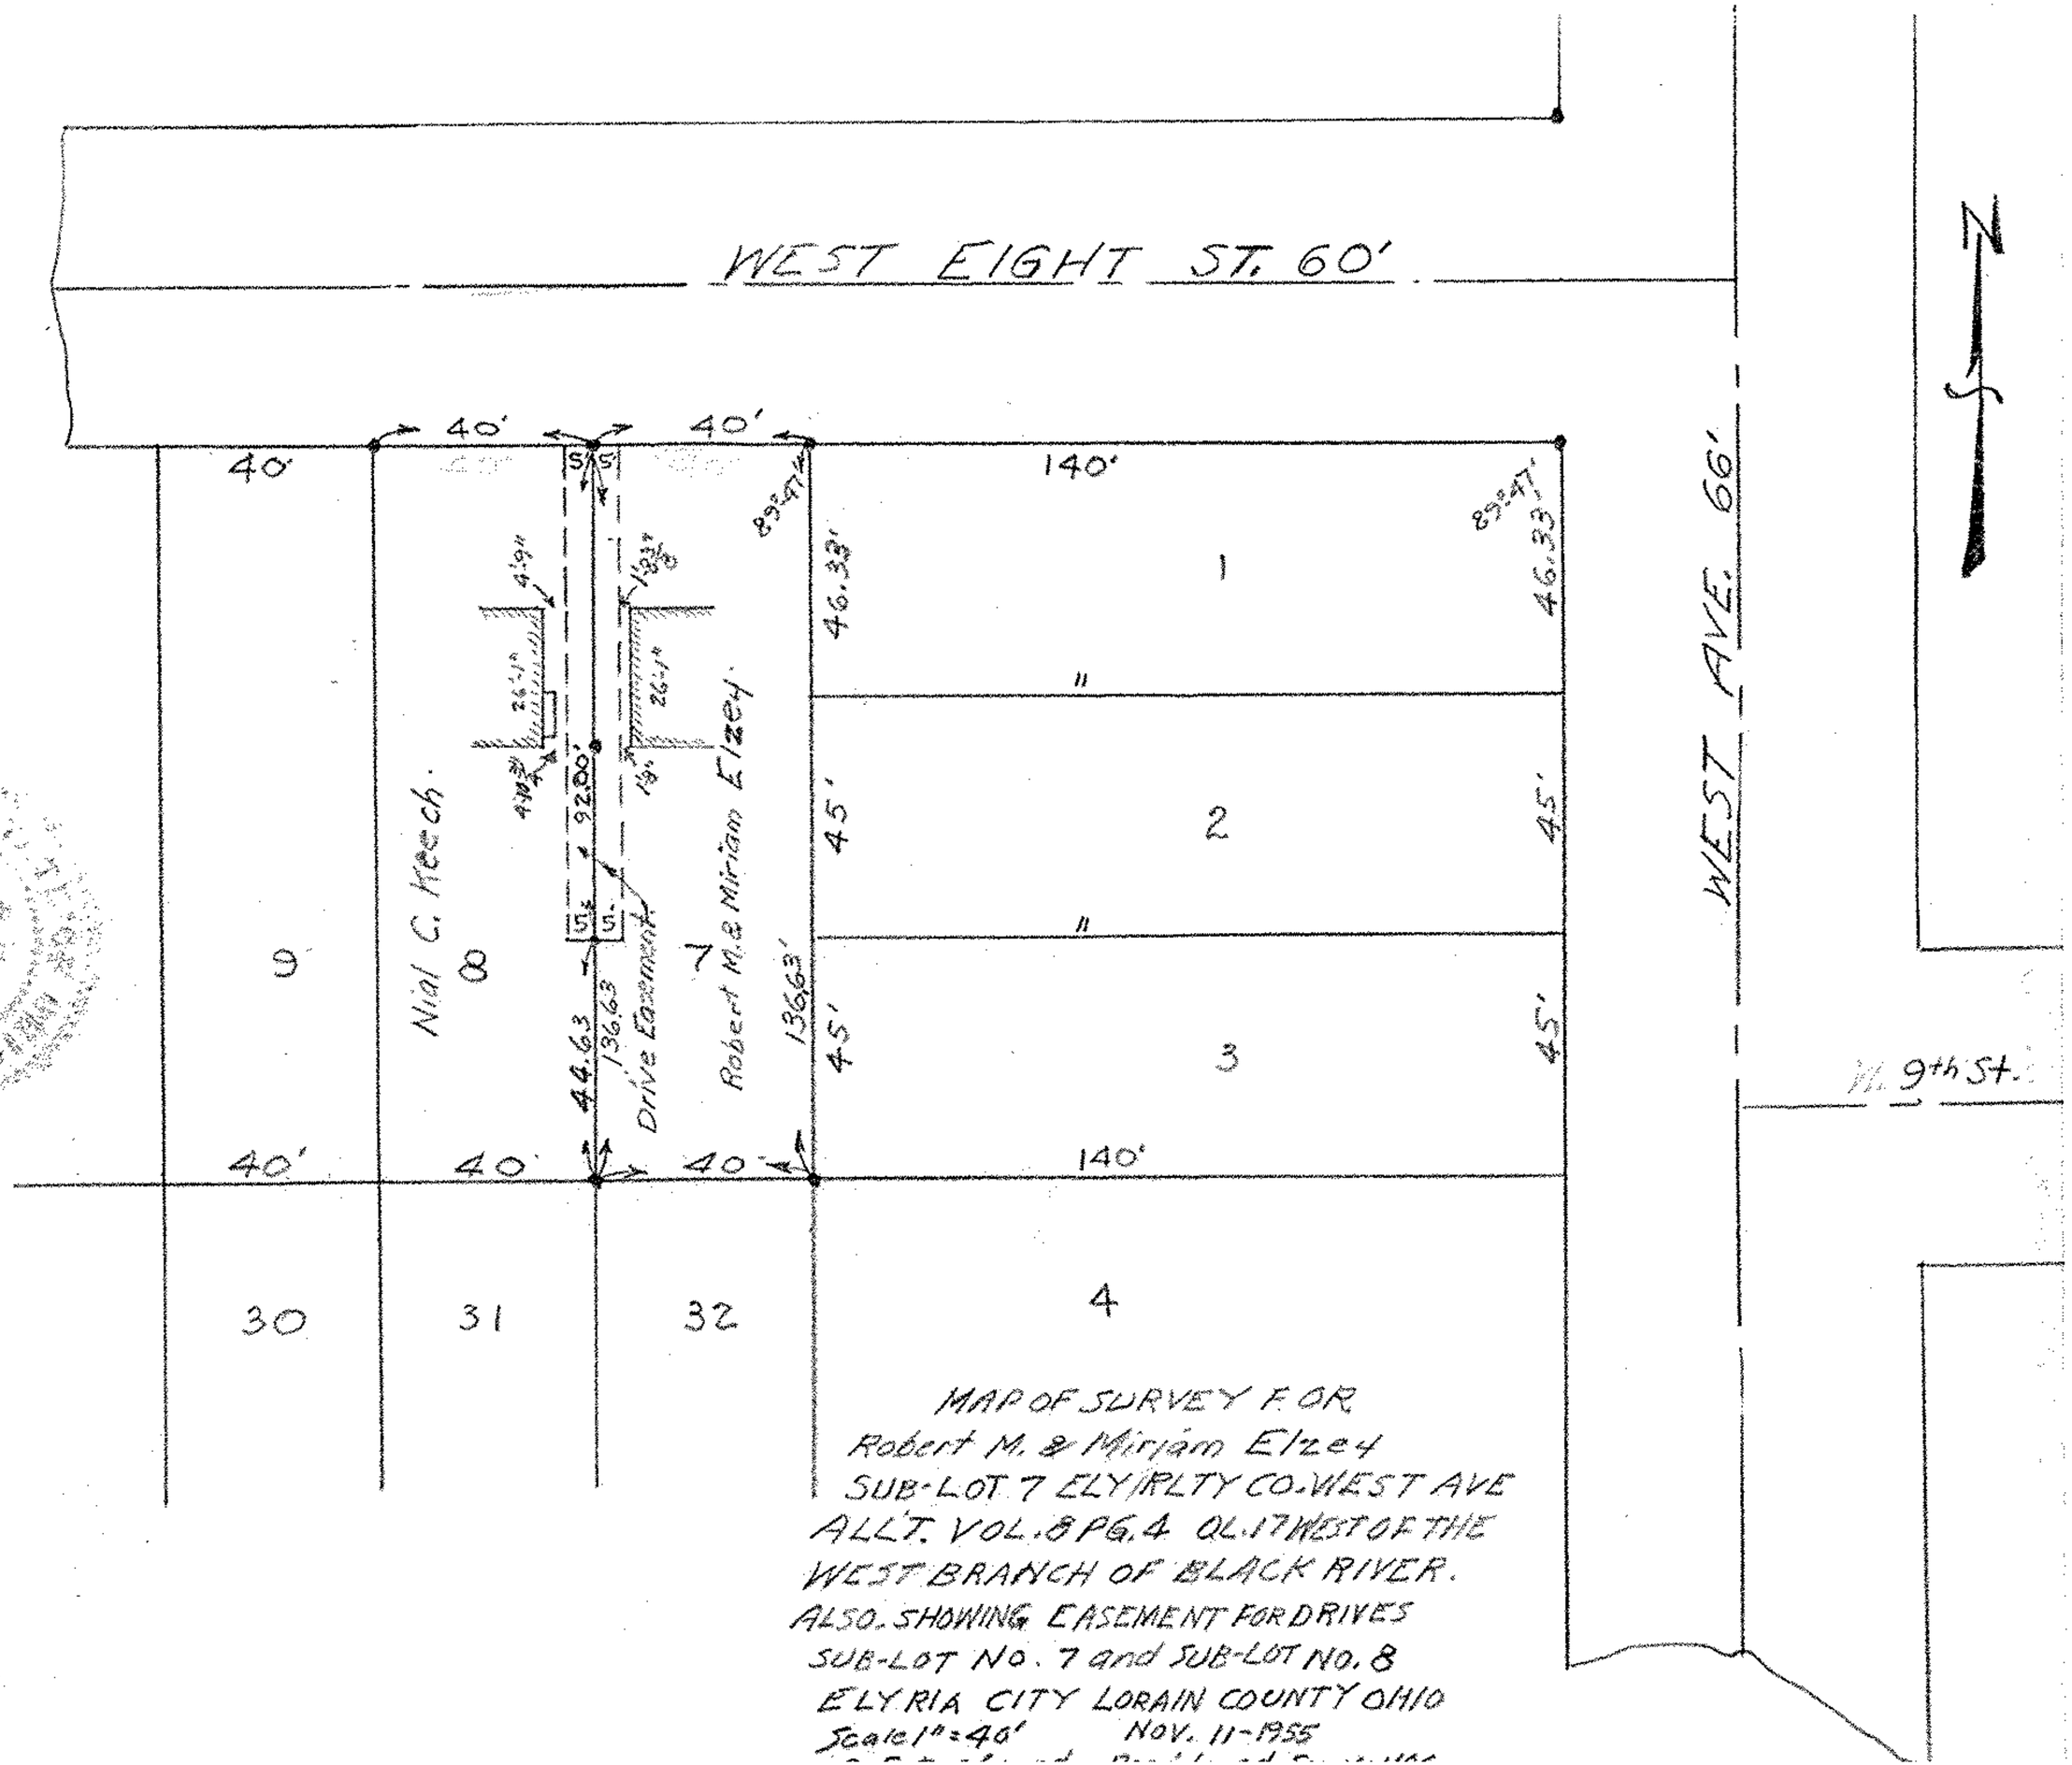

MAP OF SURVEY FOR
Robert M. & Miriam Elzey
SUB-LOT 7 ELY RLTY CO. WEST AVE
ALL'T. VOL. 8 PG. 4 OL. 17 WEST OF THE
WEST BRANCH OF BLACK RIVER.
ALSO. SHOWING EASEMENT FOR DRIVES
SUB-LOT NO. 7 and SUB-LOT NO. 8
ELYRIA CITY LORAIN COUNTY OHIO
Scale 1" = 40' NOV. 11-1955