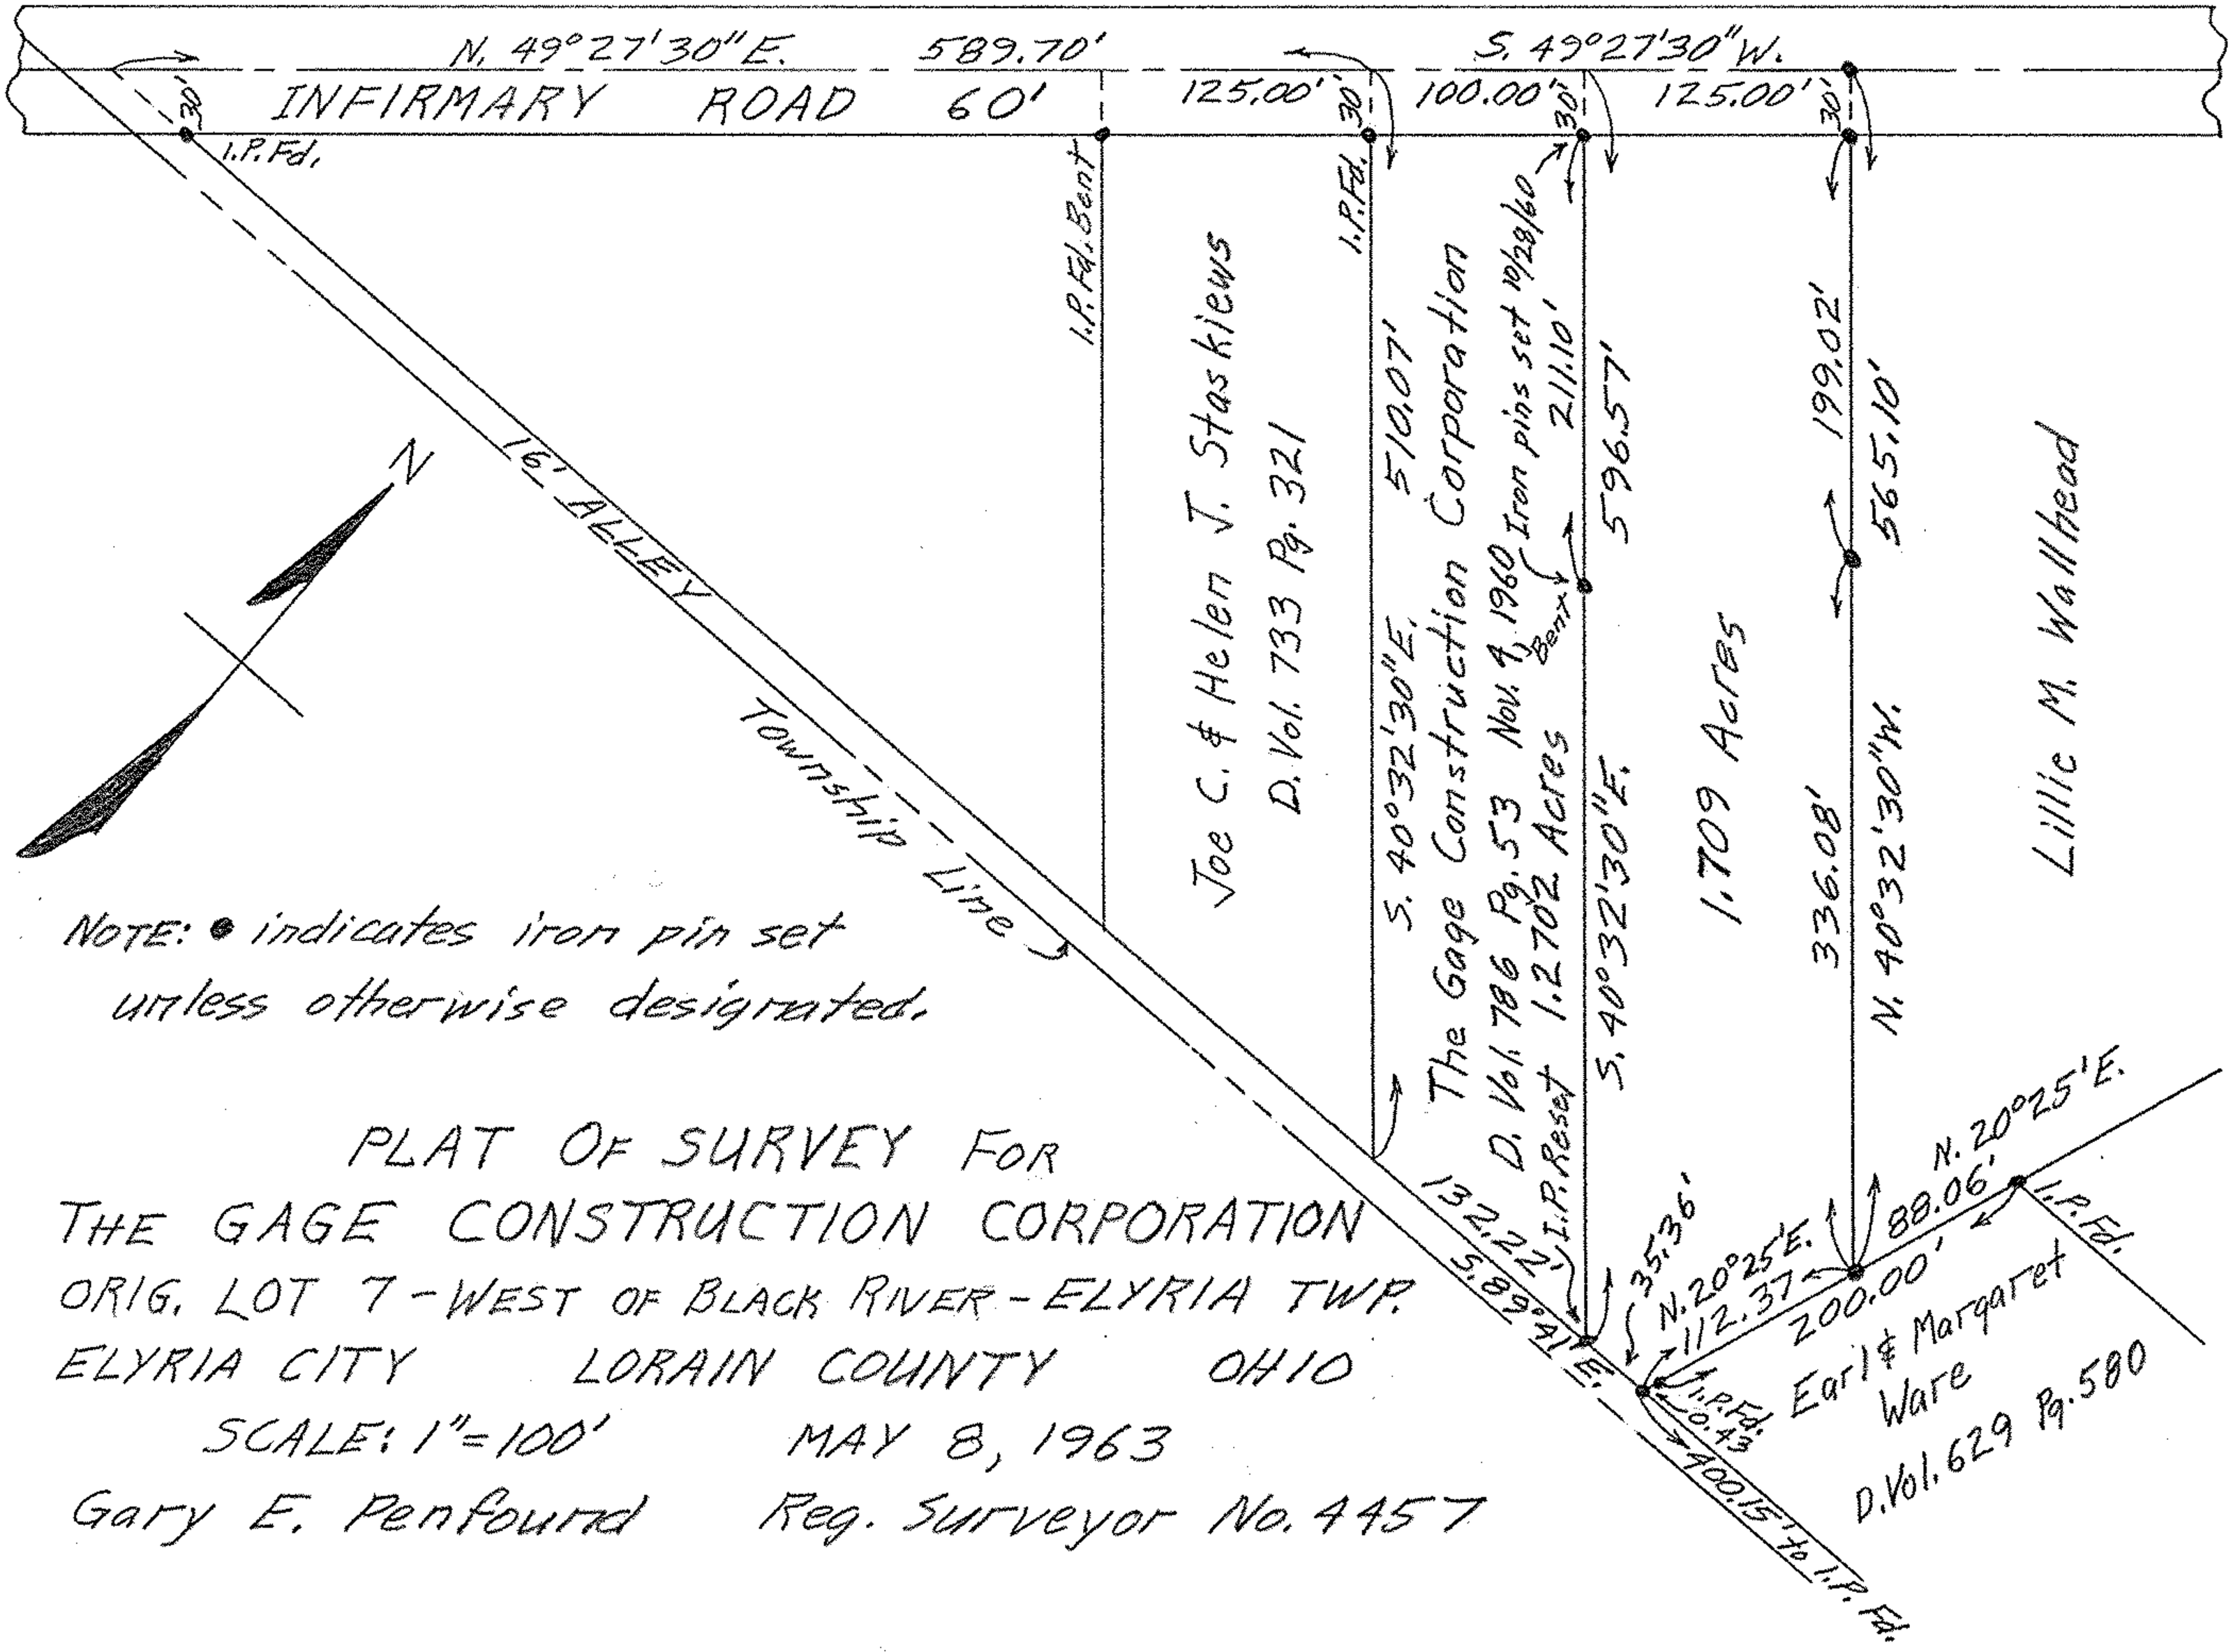

NOTE: ● indicates iron pin set unless otherwise designated.

PLAT OF SURVEY FOR
THE GAGE CONSTRUCTION CORPORATION
ORIG. LOT 7 - WEST OF BLACK RIVER - ELYRIA TWP.
ELYRIA CITY LORAIN COUNTY OHIO
SCALE: 1" = 100' MAY 8, 1963
Gary E. Penfound Reg. Surveyor No. 4457