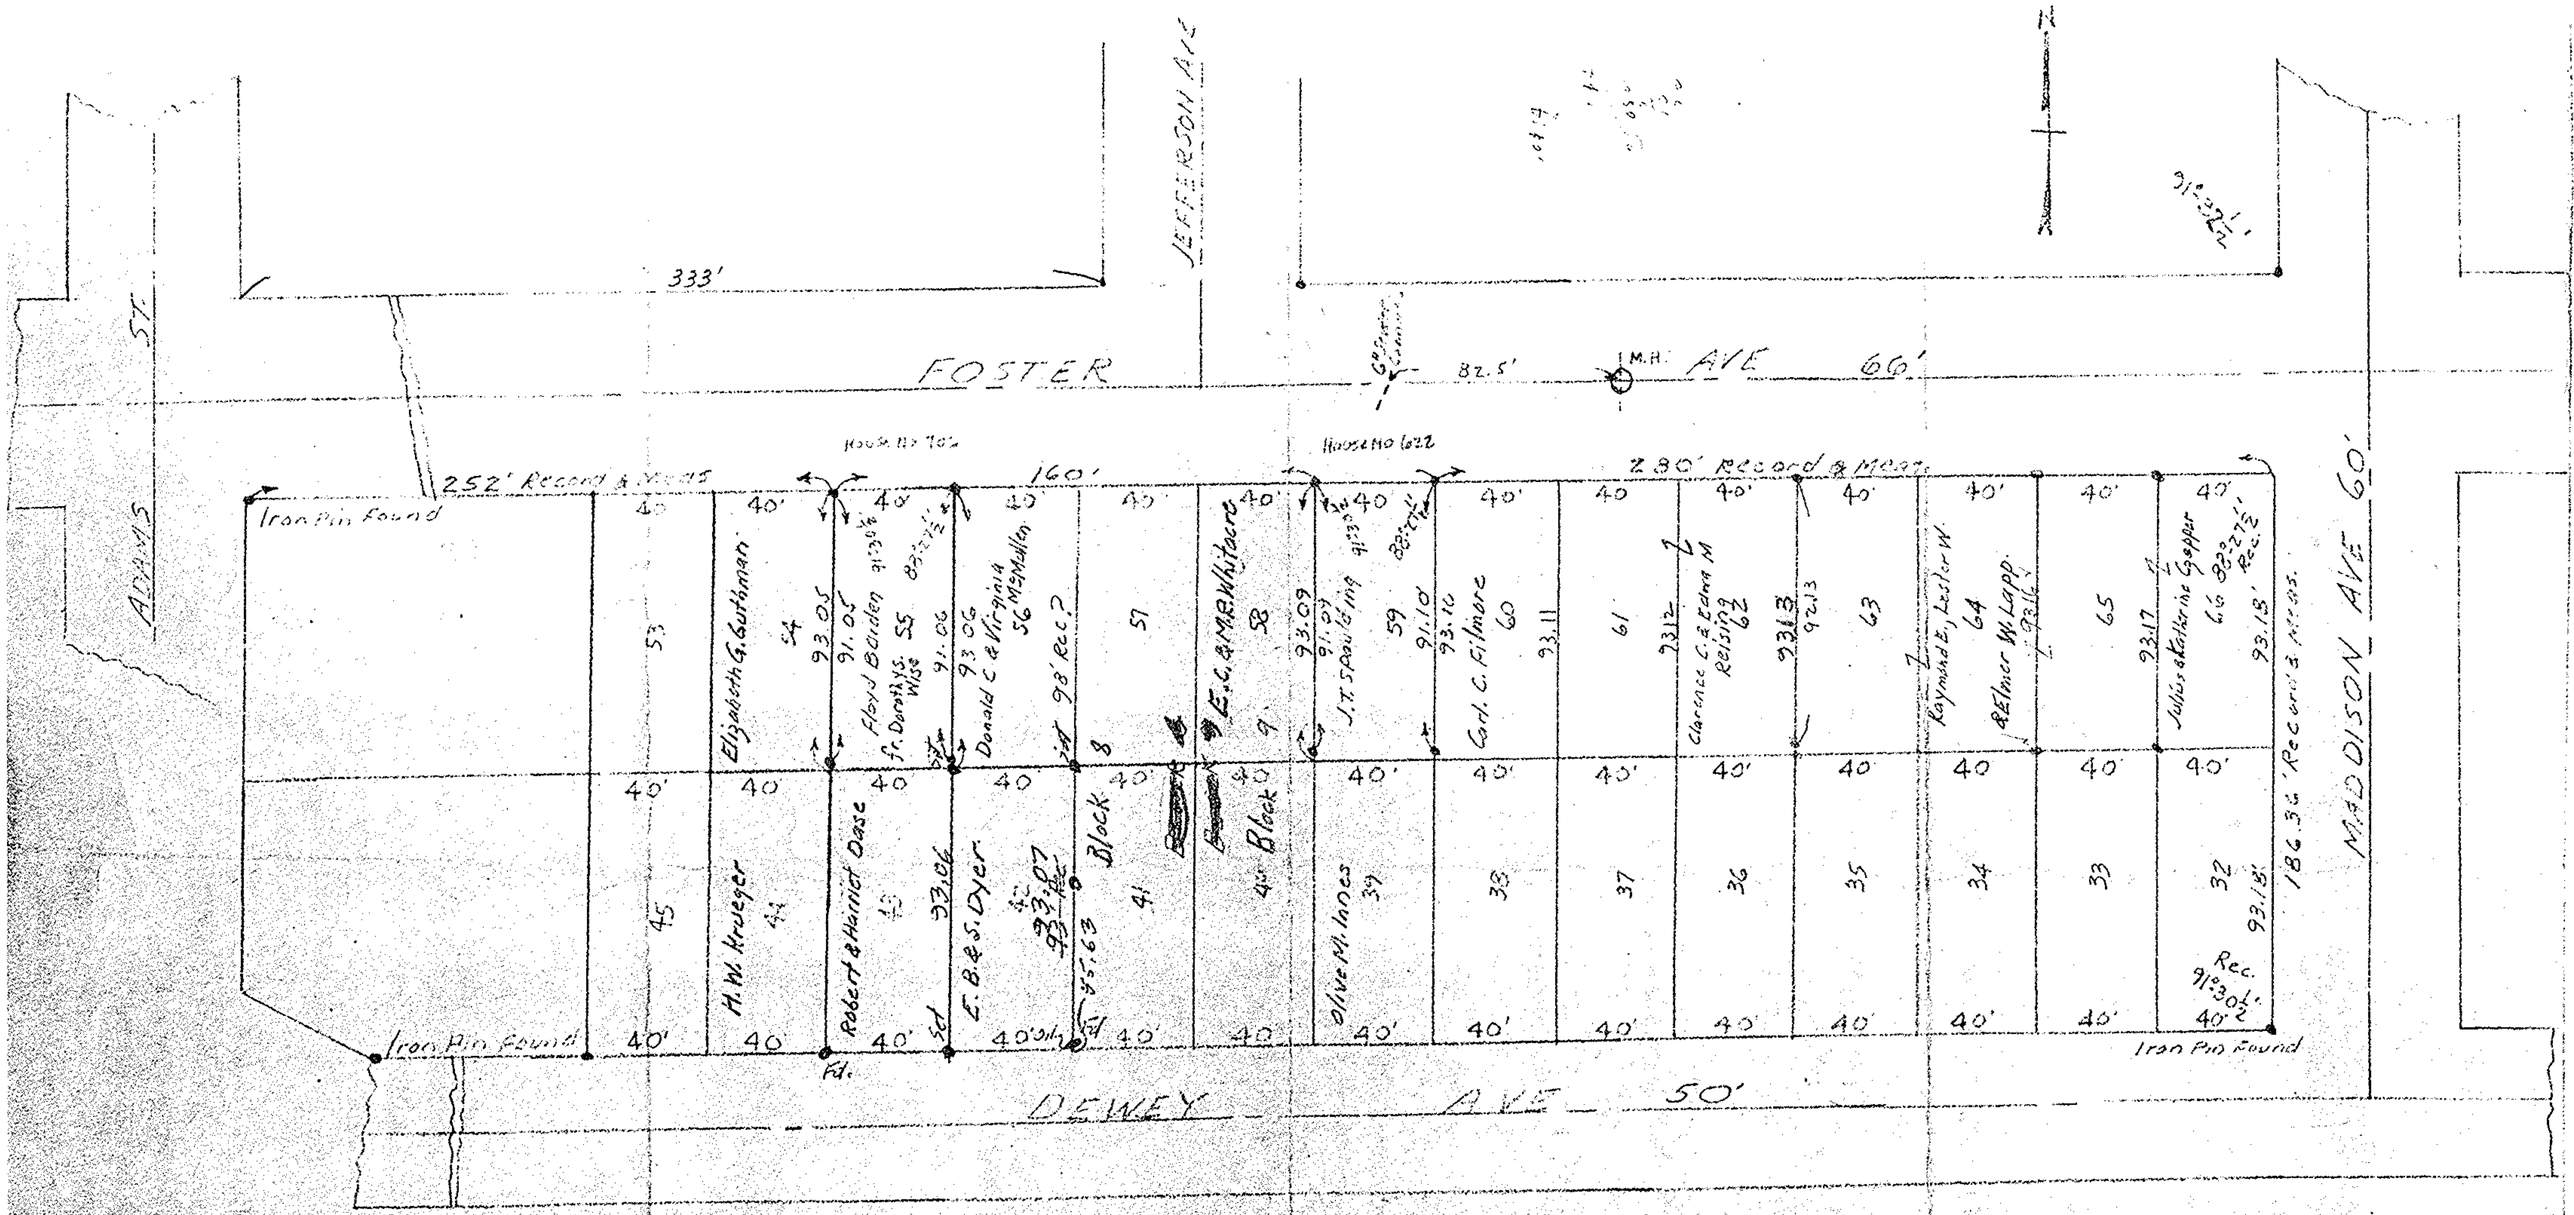

MAP OF SURVEY FOR
J.T. SPAULDING & FLOYD BARDEN
SUB LOT 59 B SUB LOT 55
FOSTER'S ADD'N VOL. 5 PG 7
O.L. 66 WEST OF WEST BRANCH OF BLACK RIVER
ELYRIA CITY LORAIN CO OHIO
Scale 1" = 50 FT. June 17 1950
C.E. Penfound Registered Surveyor

(12)