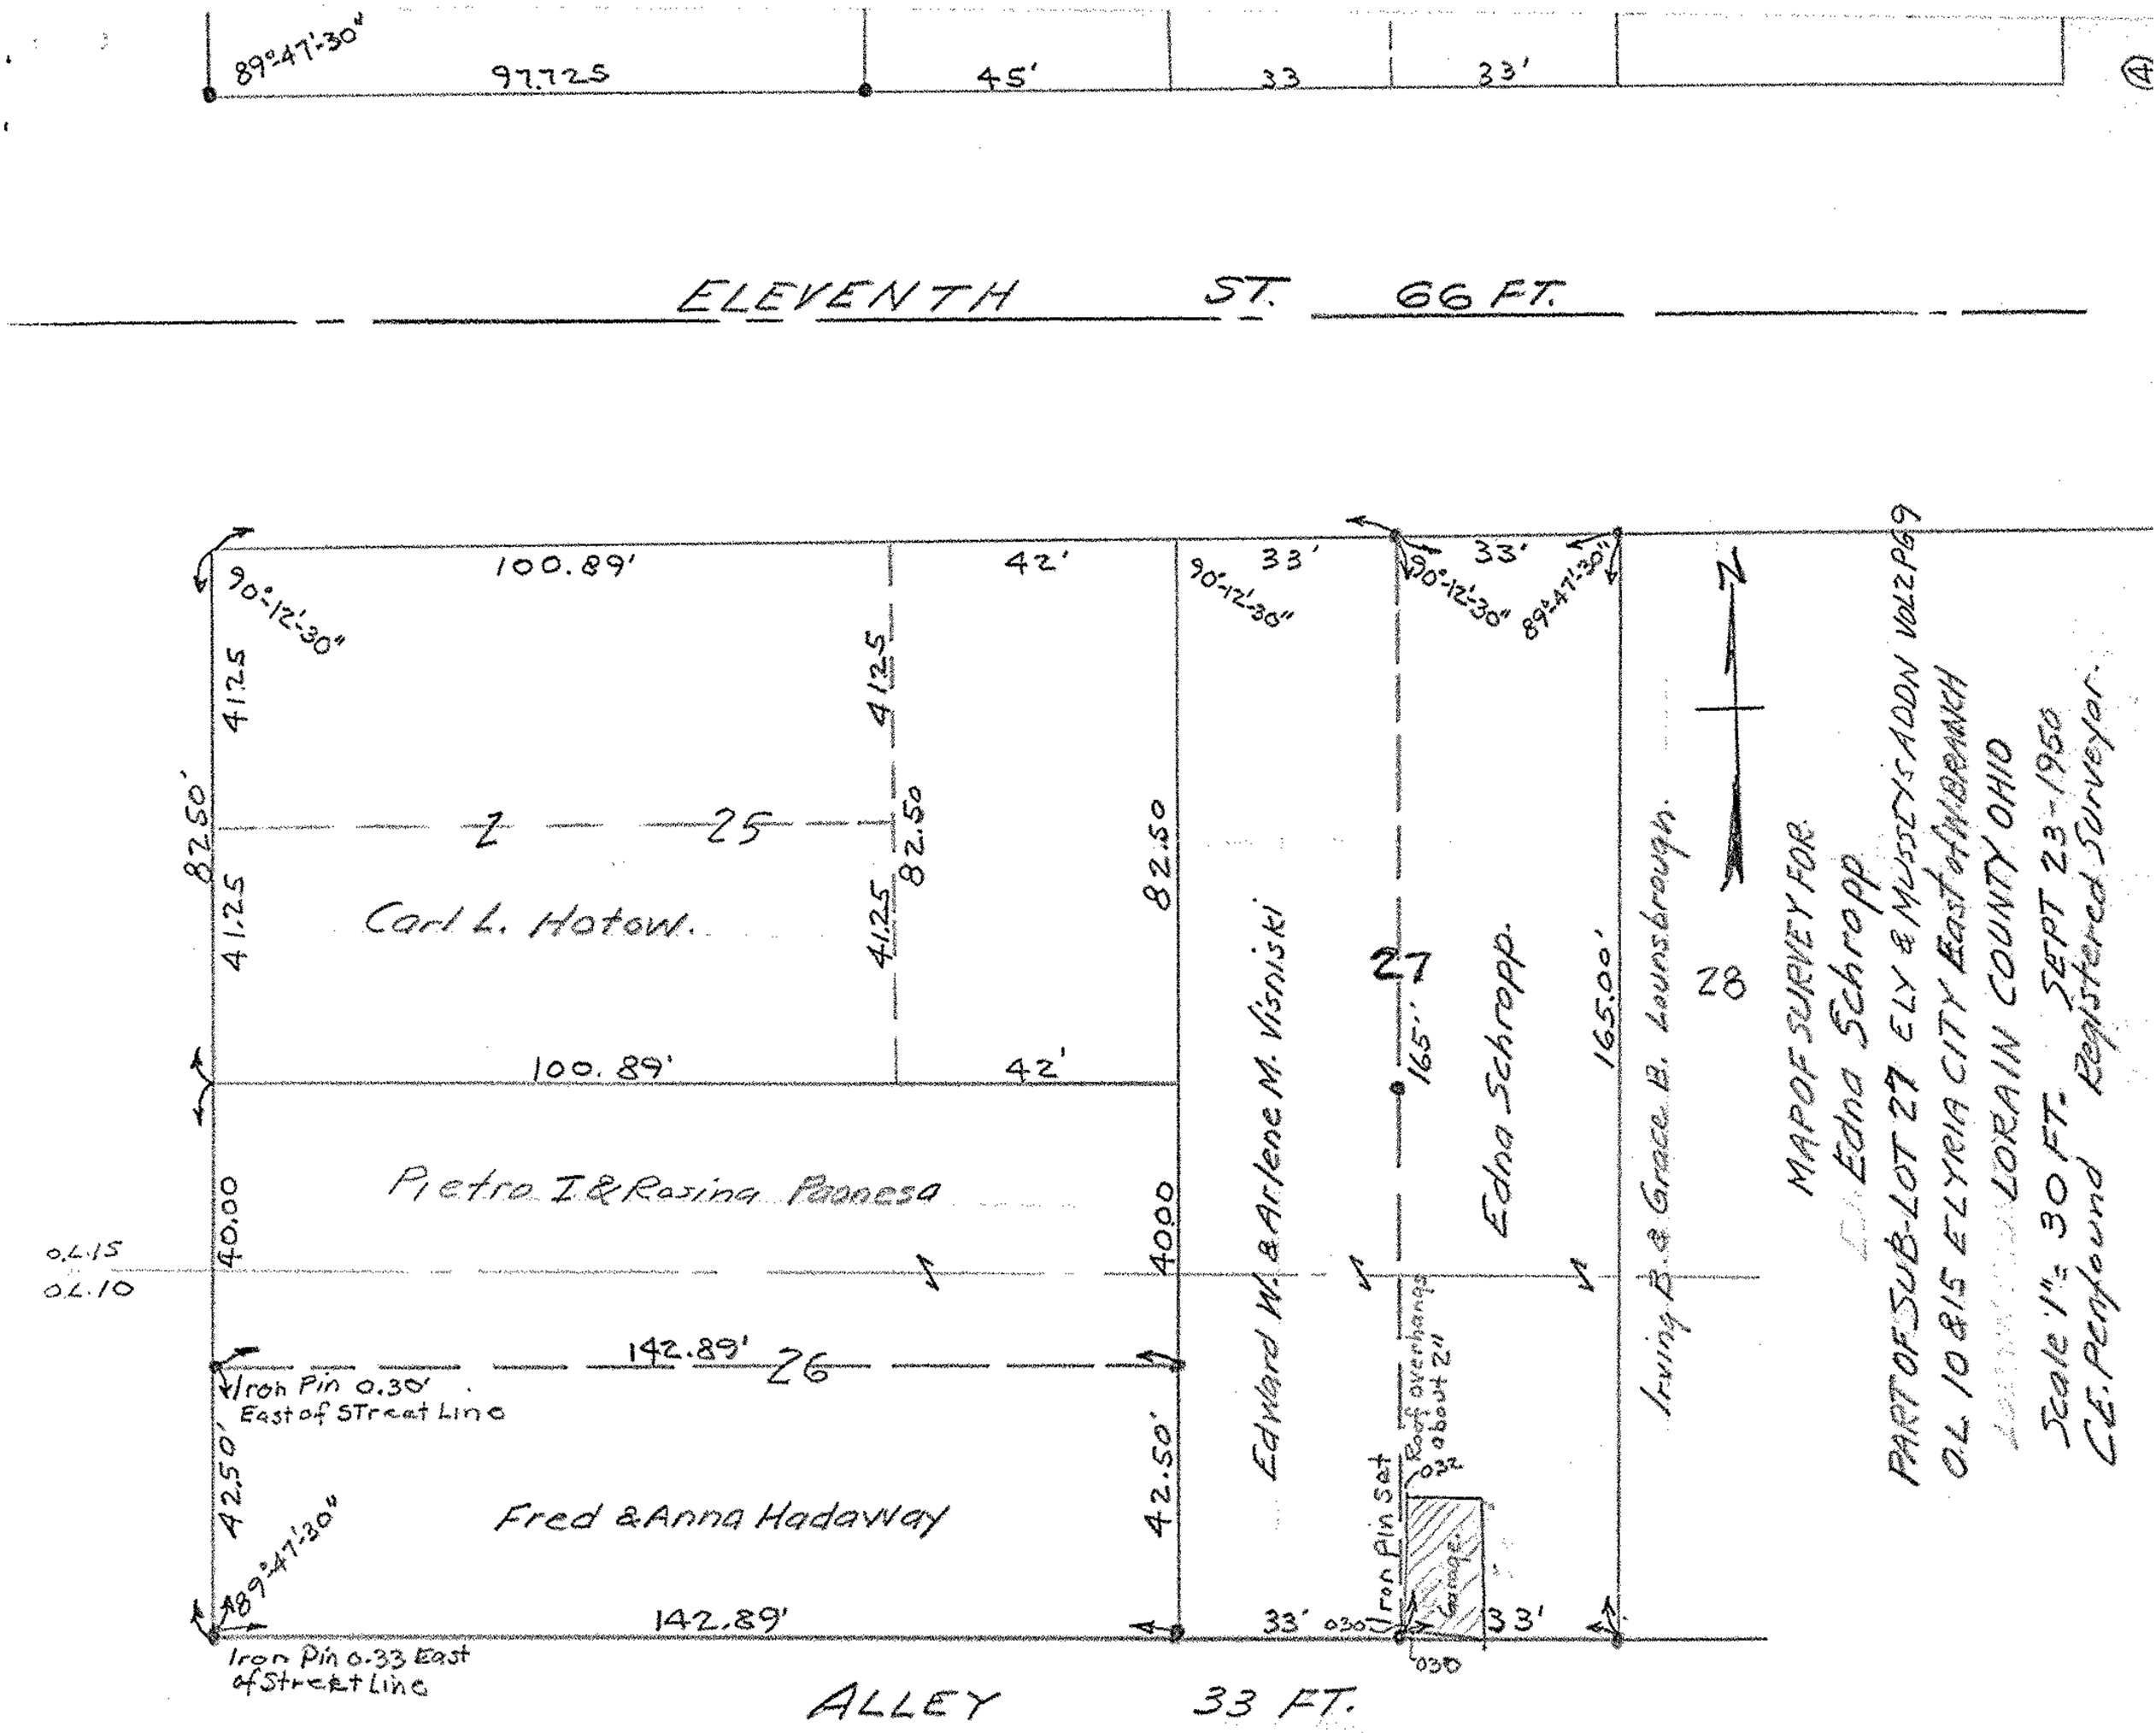

89°47'30"
97.725
45'
33
33'
ELEVENTH ST. 66 FT.
100.89'
42'
33'
33'
90°12'30"
90°12'30"
90°12'30"
89°47'30"
N
41.25
41.25
82.50'
82.50
82.50
41.25
41.25
2
25
Carl L. Hotow.
100.89'
42'
Pietro I & Rosina Paonesa
40.00
40.00
O.L.15
O.L.10
142.89'
26
Iron Pin 0.30' East of Street Line
42.50'
42.50'
89°47'30"
Fred & Anna Hadaway
142.89'
Iron Pin 0.33 East of Street Line
Edward W. & Arlene M. Visniski
27
165'
Edna Schropp.
165.00'
Irving B. & Grace B. Lounsbrough.
28
Roof overhangs about 2"
032
Iron Pin Set
Garage
33'
030
33'
030
ALLEY 33 FT.
MAP OF SURVEY FOR
Edna Schropp
PART OF SUB-LOT 27 ELY & MUSSEY'S ADDN VOL 2 PG 9
O.L. 10 & 15 ELYRIA CITY East of W. BRANCH
LORAIN COUNTY OHIO
Scale 1" = 30 FT. SEPT 23-1950
C.E. Penfound Registered Surveyor.