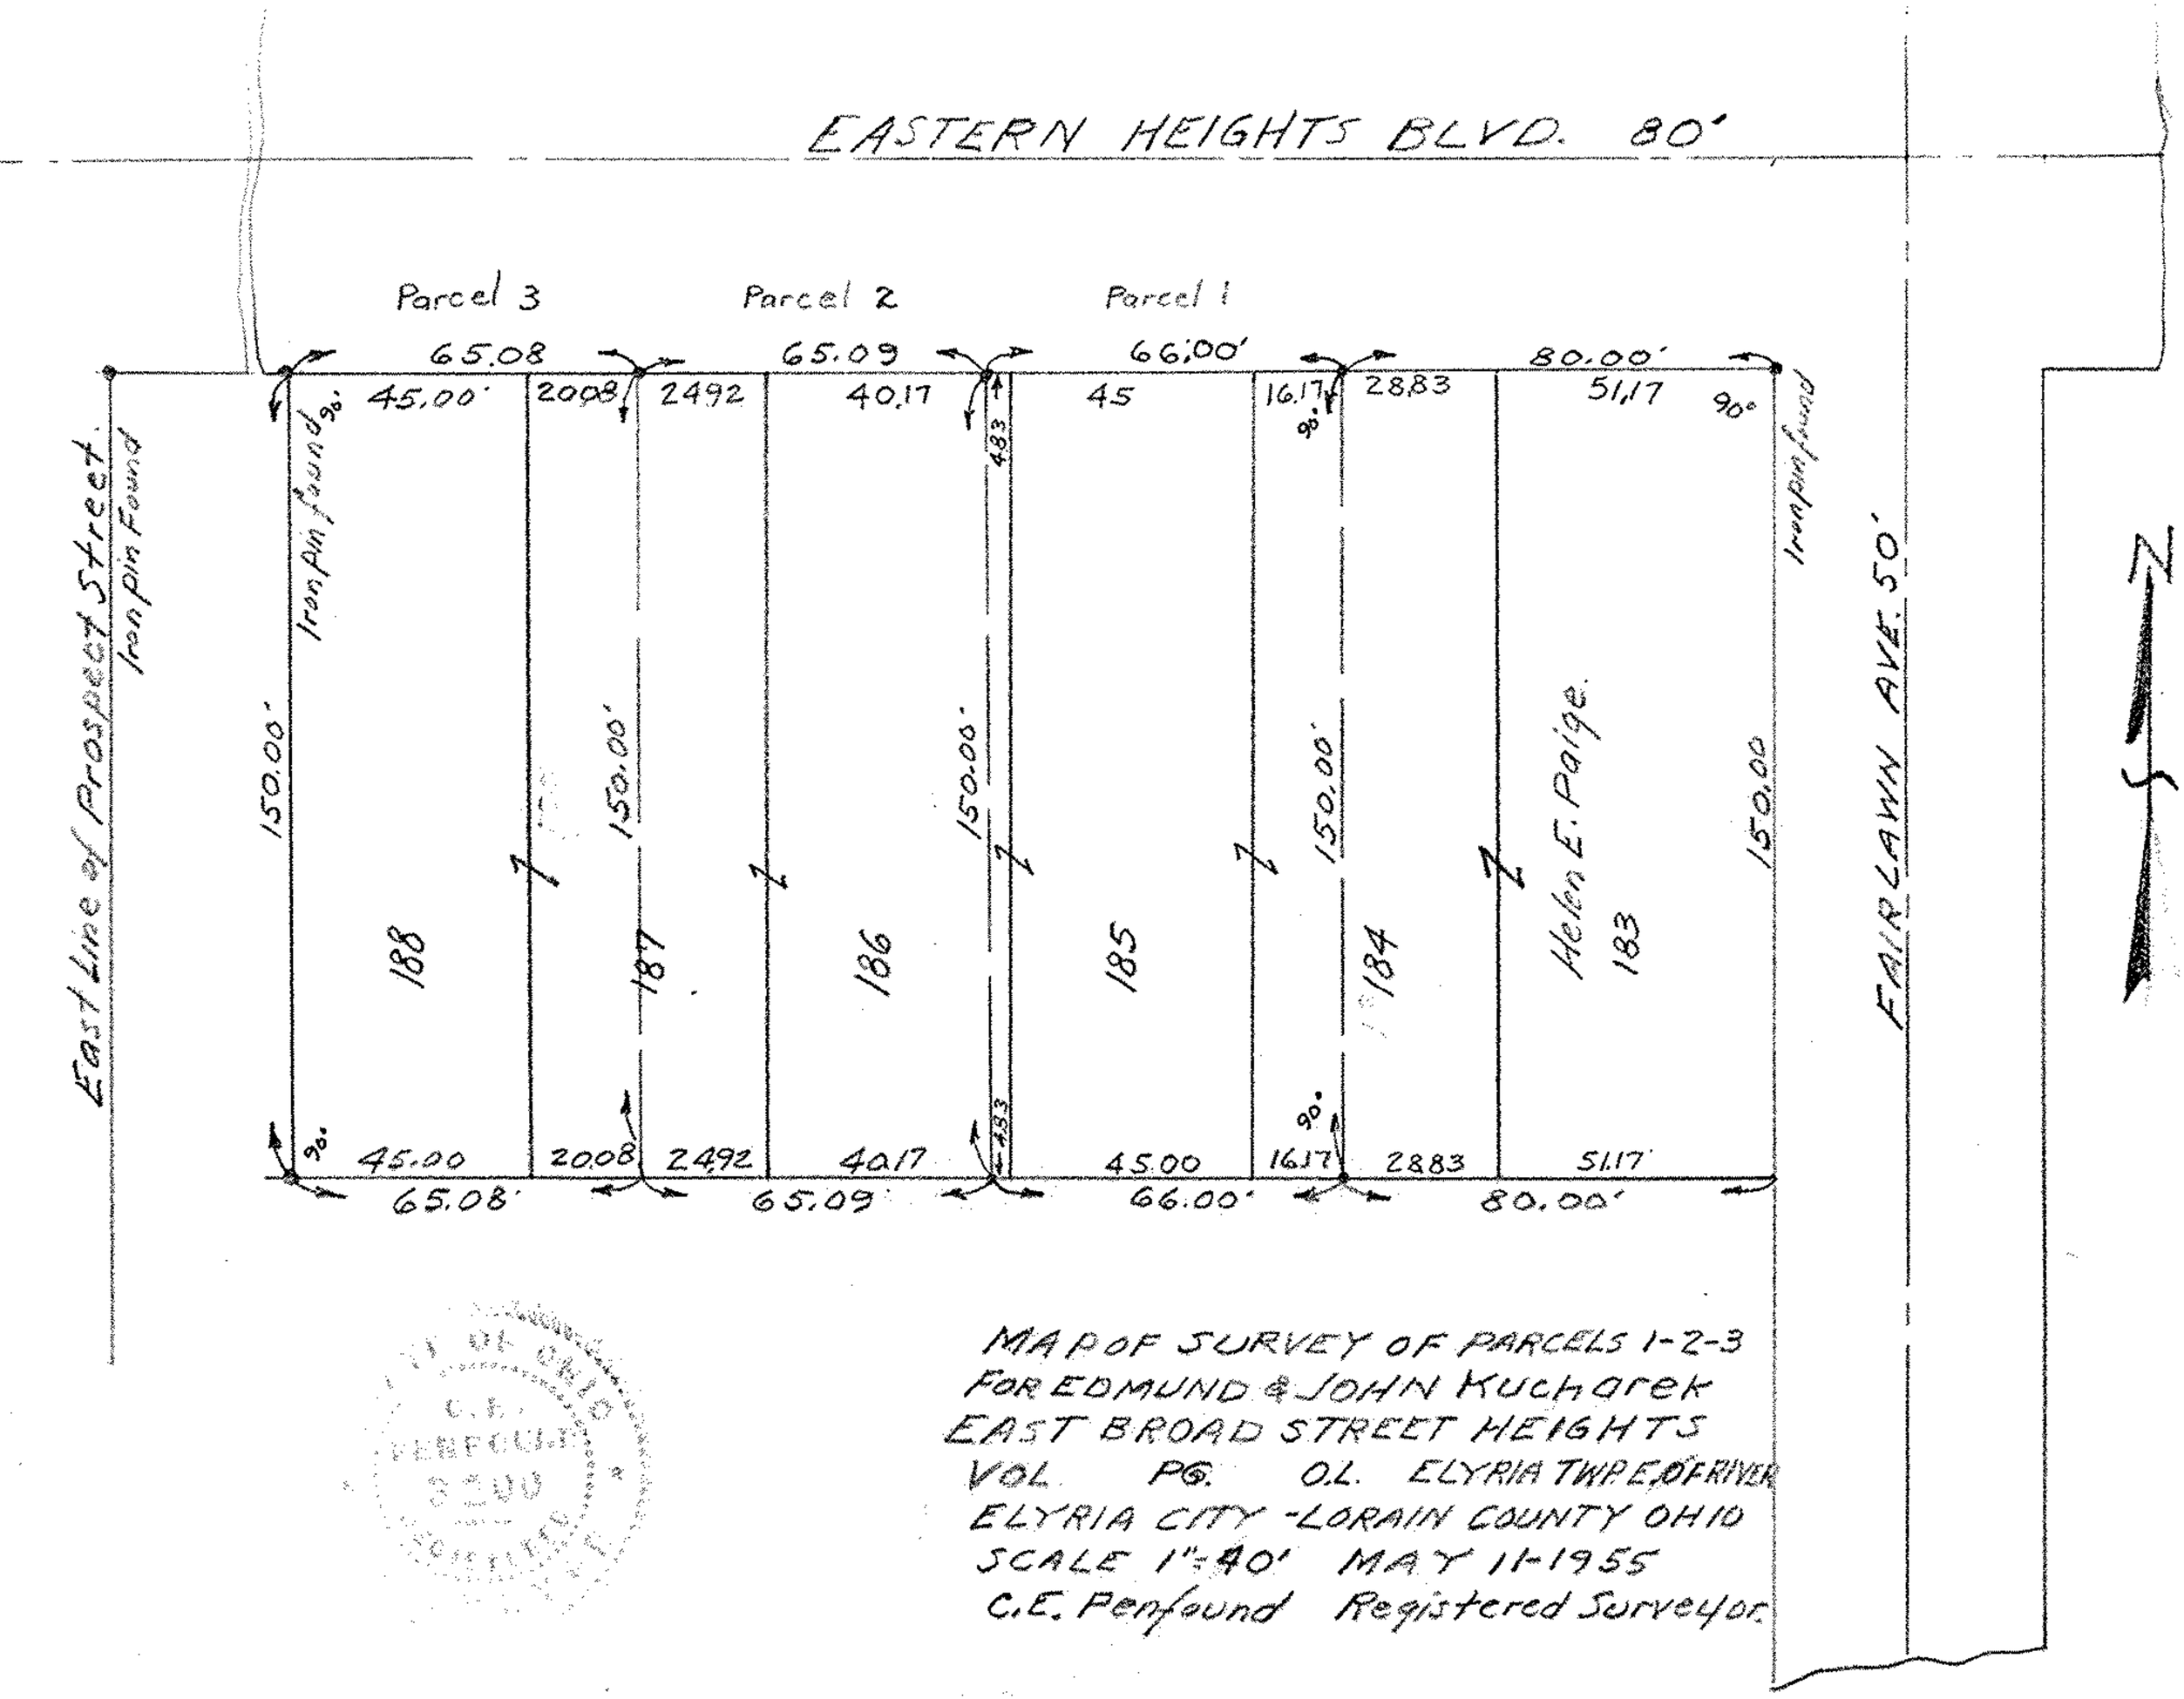

MAP OF SURVEY OF PARCELS 1-2-3
FOR EDMUND & JOHN Kucharek
EAST BROAD STREET HEIGHTS
VOL. PG. O.L. ELYRIA TWP. E. OF RIVER
ELYRIA CITY - LORAIN COUNTY OHIO
SCALE 1"=40' MAY 11-1955
C.E. Penfound Registered Surveyor.