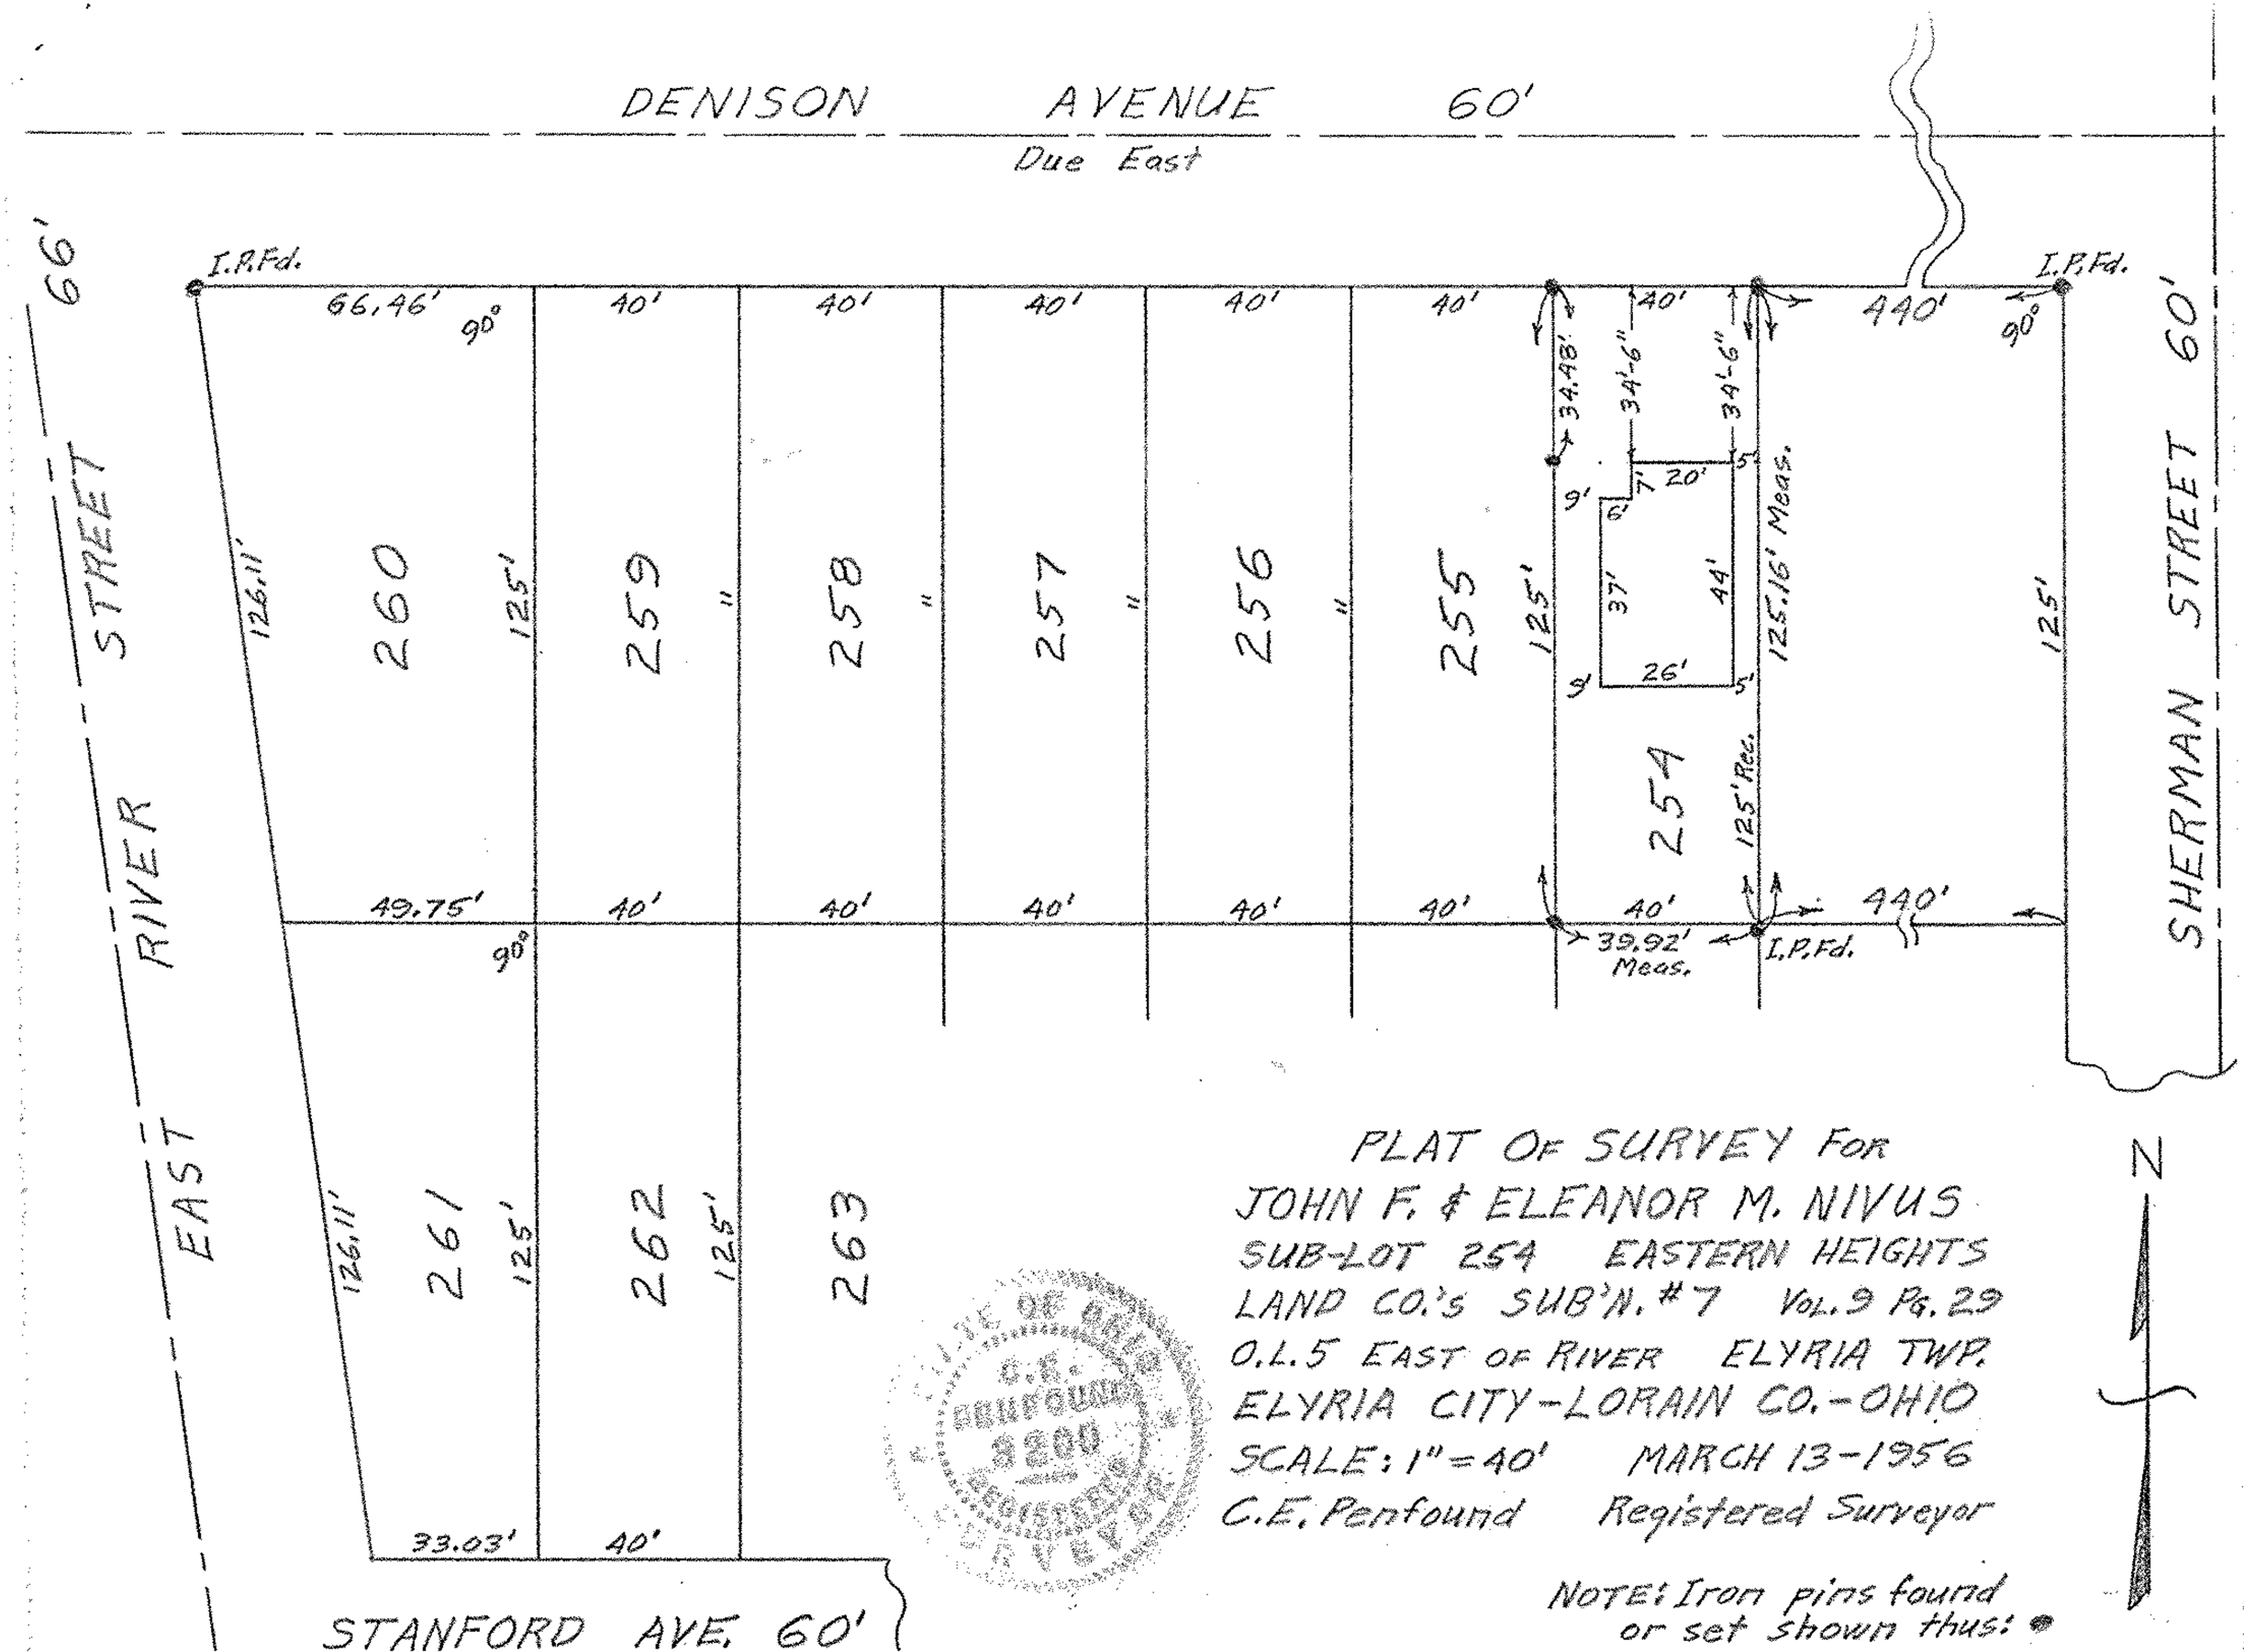

PLAT OF SURVEY FOR
JOHN F. & ELEANOR M. NIVUS
SUB-LOT 254 EASTERN HEIGHTS
LAND CO.'S SUB'N. #7 VOL. 9 PG. 29
O.L. 5 EAST OF RIVER ELYRIA TWP.
ELYRIA CITY-LORAIN CO.-OHIO
SCALE: 1" = 40' MARCH 13-1956
C.E. Penfound Registered Surveyor

NOTE: Iron pins found or set shown thus: ●