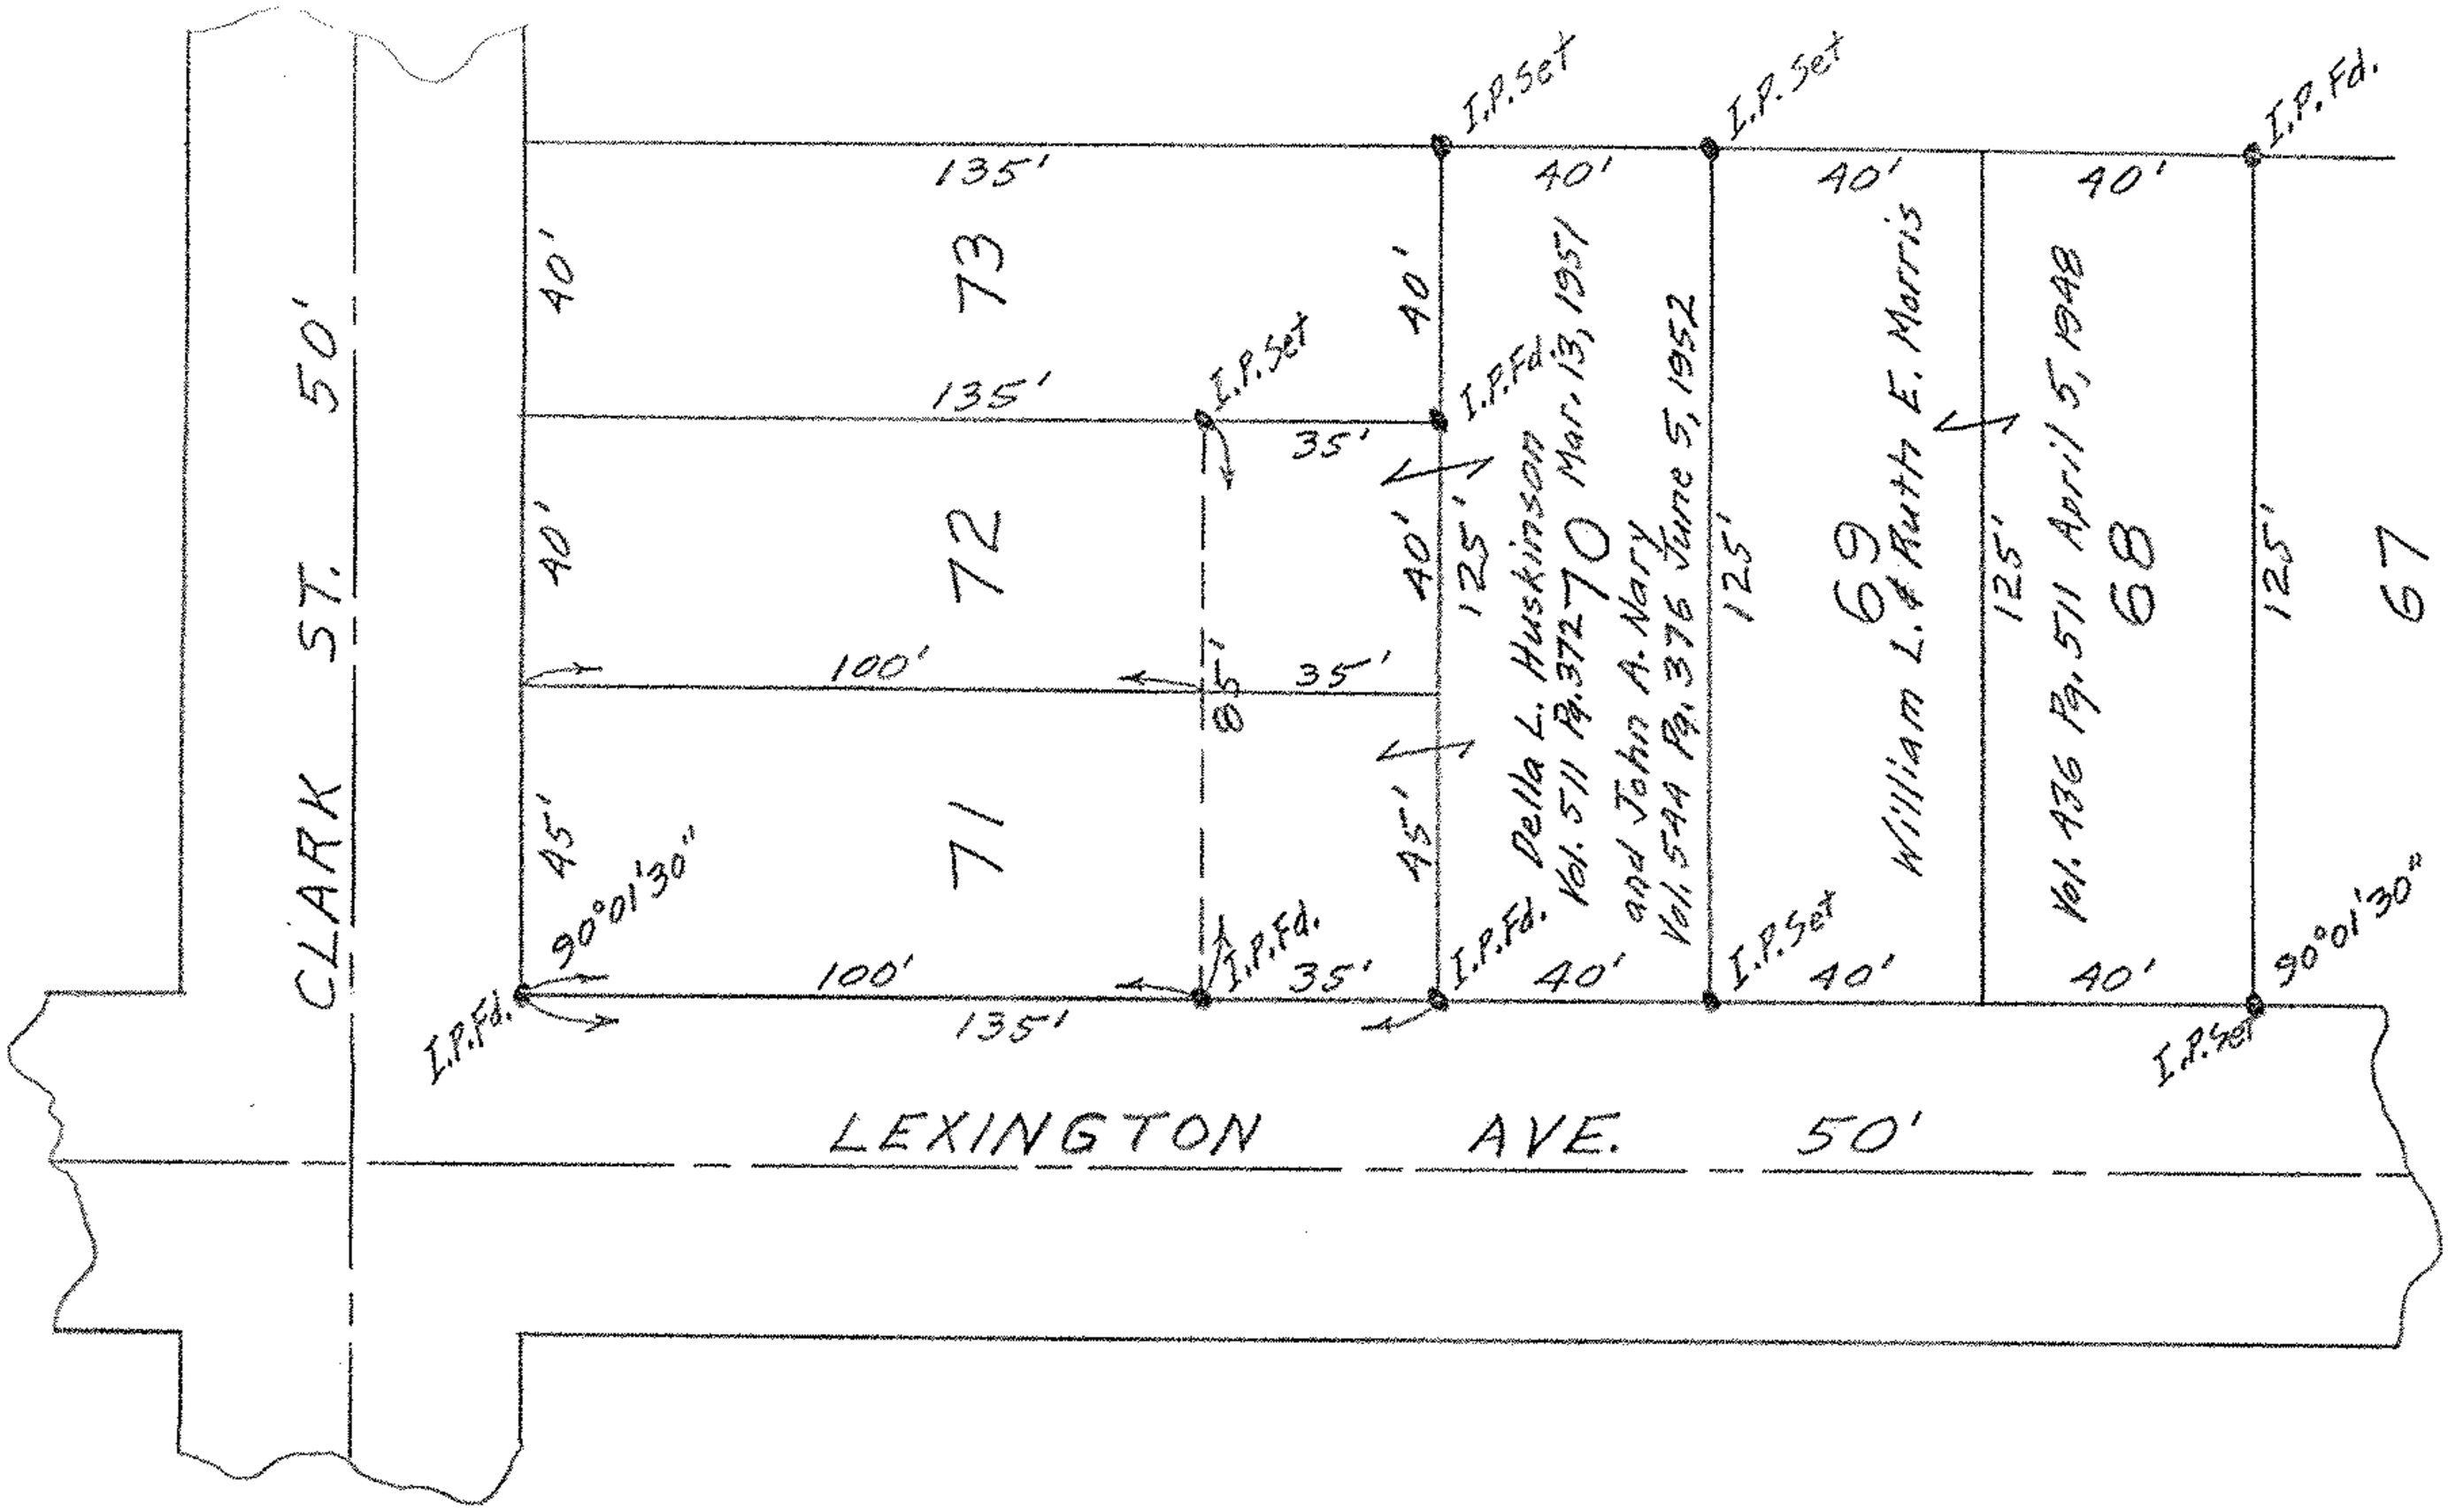

PLAT OF SURVEY FOR
WILLIAM L. & RUTH E. MORRIS
AND DELLA L. HUSKINSON & JOHN A. NARY
SUB-LOTS 68-69-70 & PARTS OF 71 & 72
BROADVIEW ALLT. VOL. 9 PG. 19 PLAT RECORDS
ORIG. LOT 14 EAST OF RIVER ELYRIA TWP.
LORAIN COUNTY—OHIO

SCALE: 1" = 40' DECEMBER 29, 1955

C.E. Penfound Registered Surveyor

NOTE: Iron pins found or set shown thus: ●