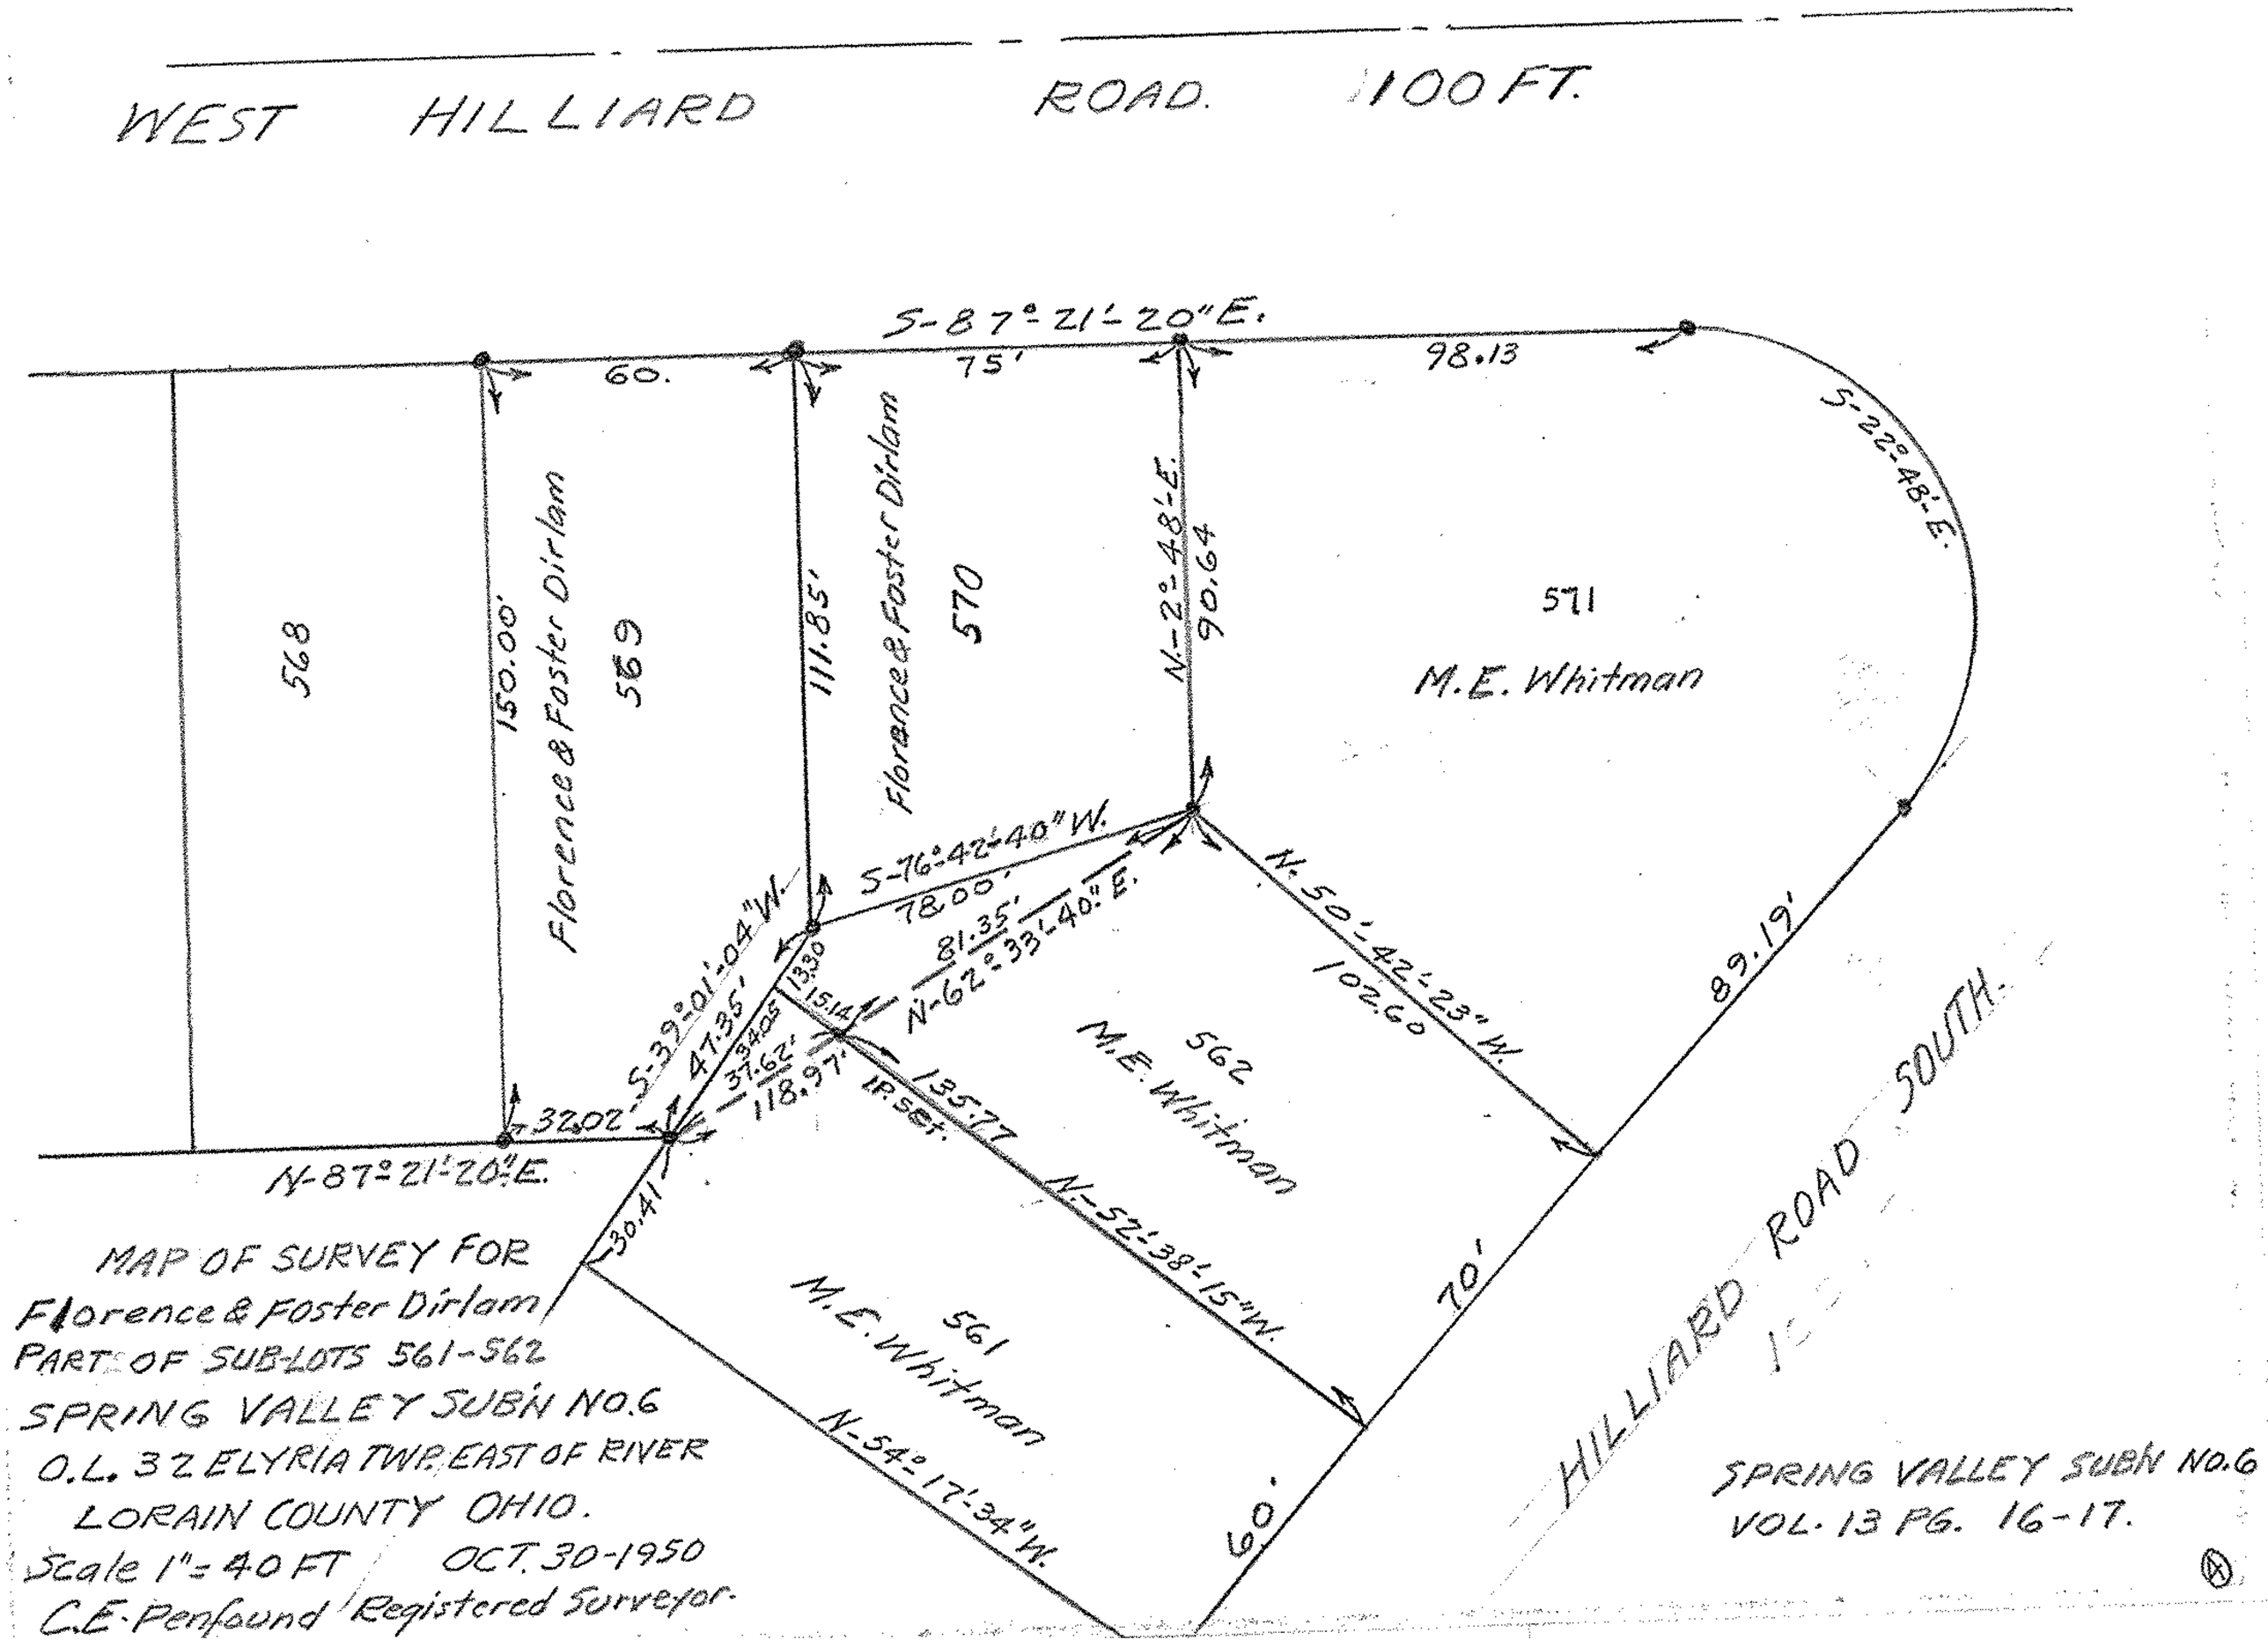
WEST HILLIARD ROAD. 100 FT.
S-87°-21'-20"E.
60.
75'
98.13
S-22°-48'-E.
568
150.00'
Florence & Foster Dirlam
569
111.85'
Florence & Foster Dirlam
570
N-2°-48'-E.
90.64
571
M.E. Whitman
S-76°-42'-40"W.
78.00'
81.35'
N-62°-33'-40"E.
N-50°-42'-23"W.
102.60
89.19'
S-39°-01'-04"W.
47.35'
13.30
15.14
34.05
37.62'
118.97'
135.77
IP. set.
562
M.E. Whitman
32.02'
N-87°-21'-20"E.
30.41
N-52°-38'-15"W.
70'
561
M.E. Whitman
N-54°-17'-34"W.
60'
HILLIARD ROAD SOUTH.
MAP OF SURVEY FOR
Florence & Foster Dirlam
PART OF SUB-LOTS 561-562
SPRING VALLEY SUB'N NO.6
O.L. 32 ELYRIA TWP. EAST OF RIVER
LORAIN COUNTY OHIO.
Scale 1" = 40 FT OCT. 30-1950
C.E. Penfound Registered Surveyor.
SPRING VALLEY SUB'N NO.6
VOL. 13 PG. 16-17.