


1"=20'

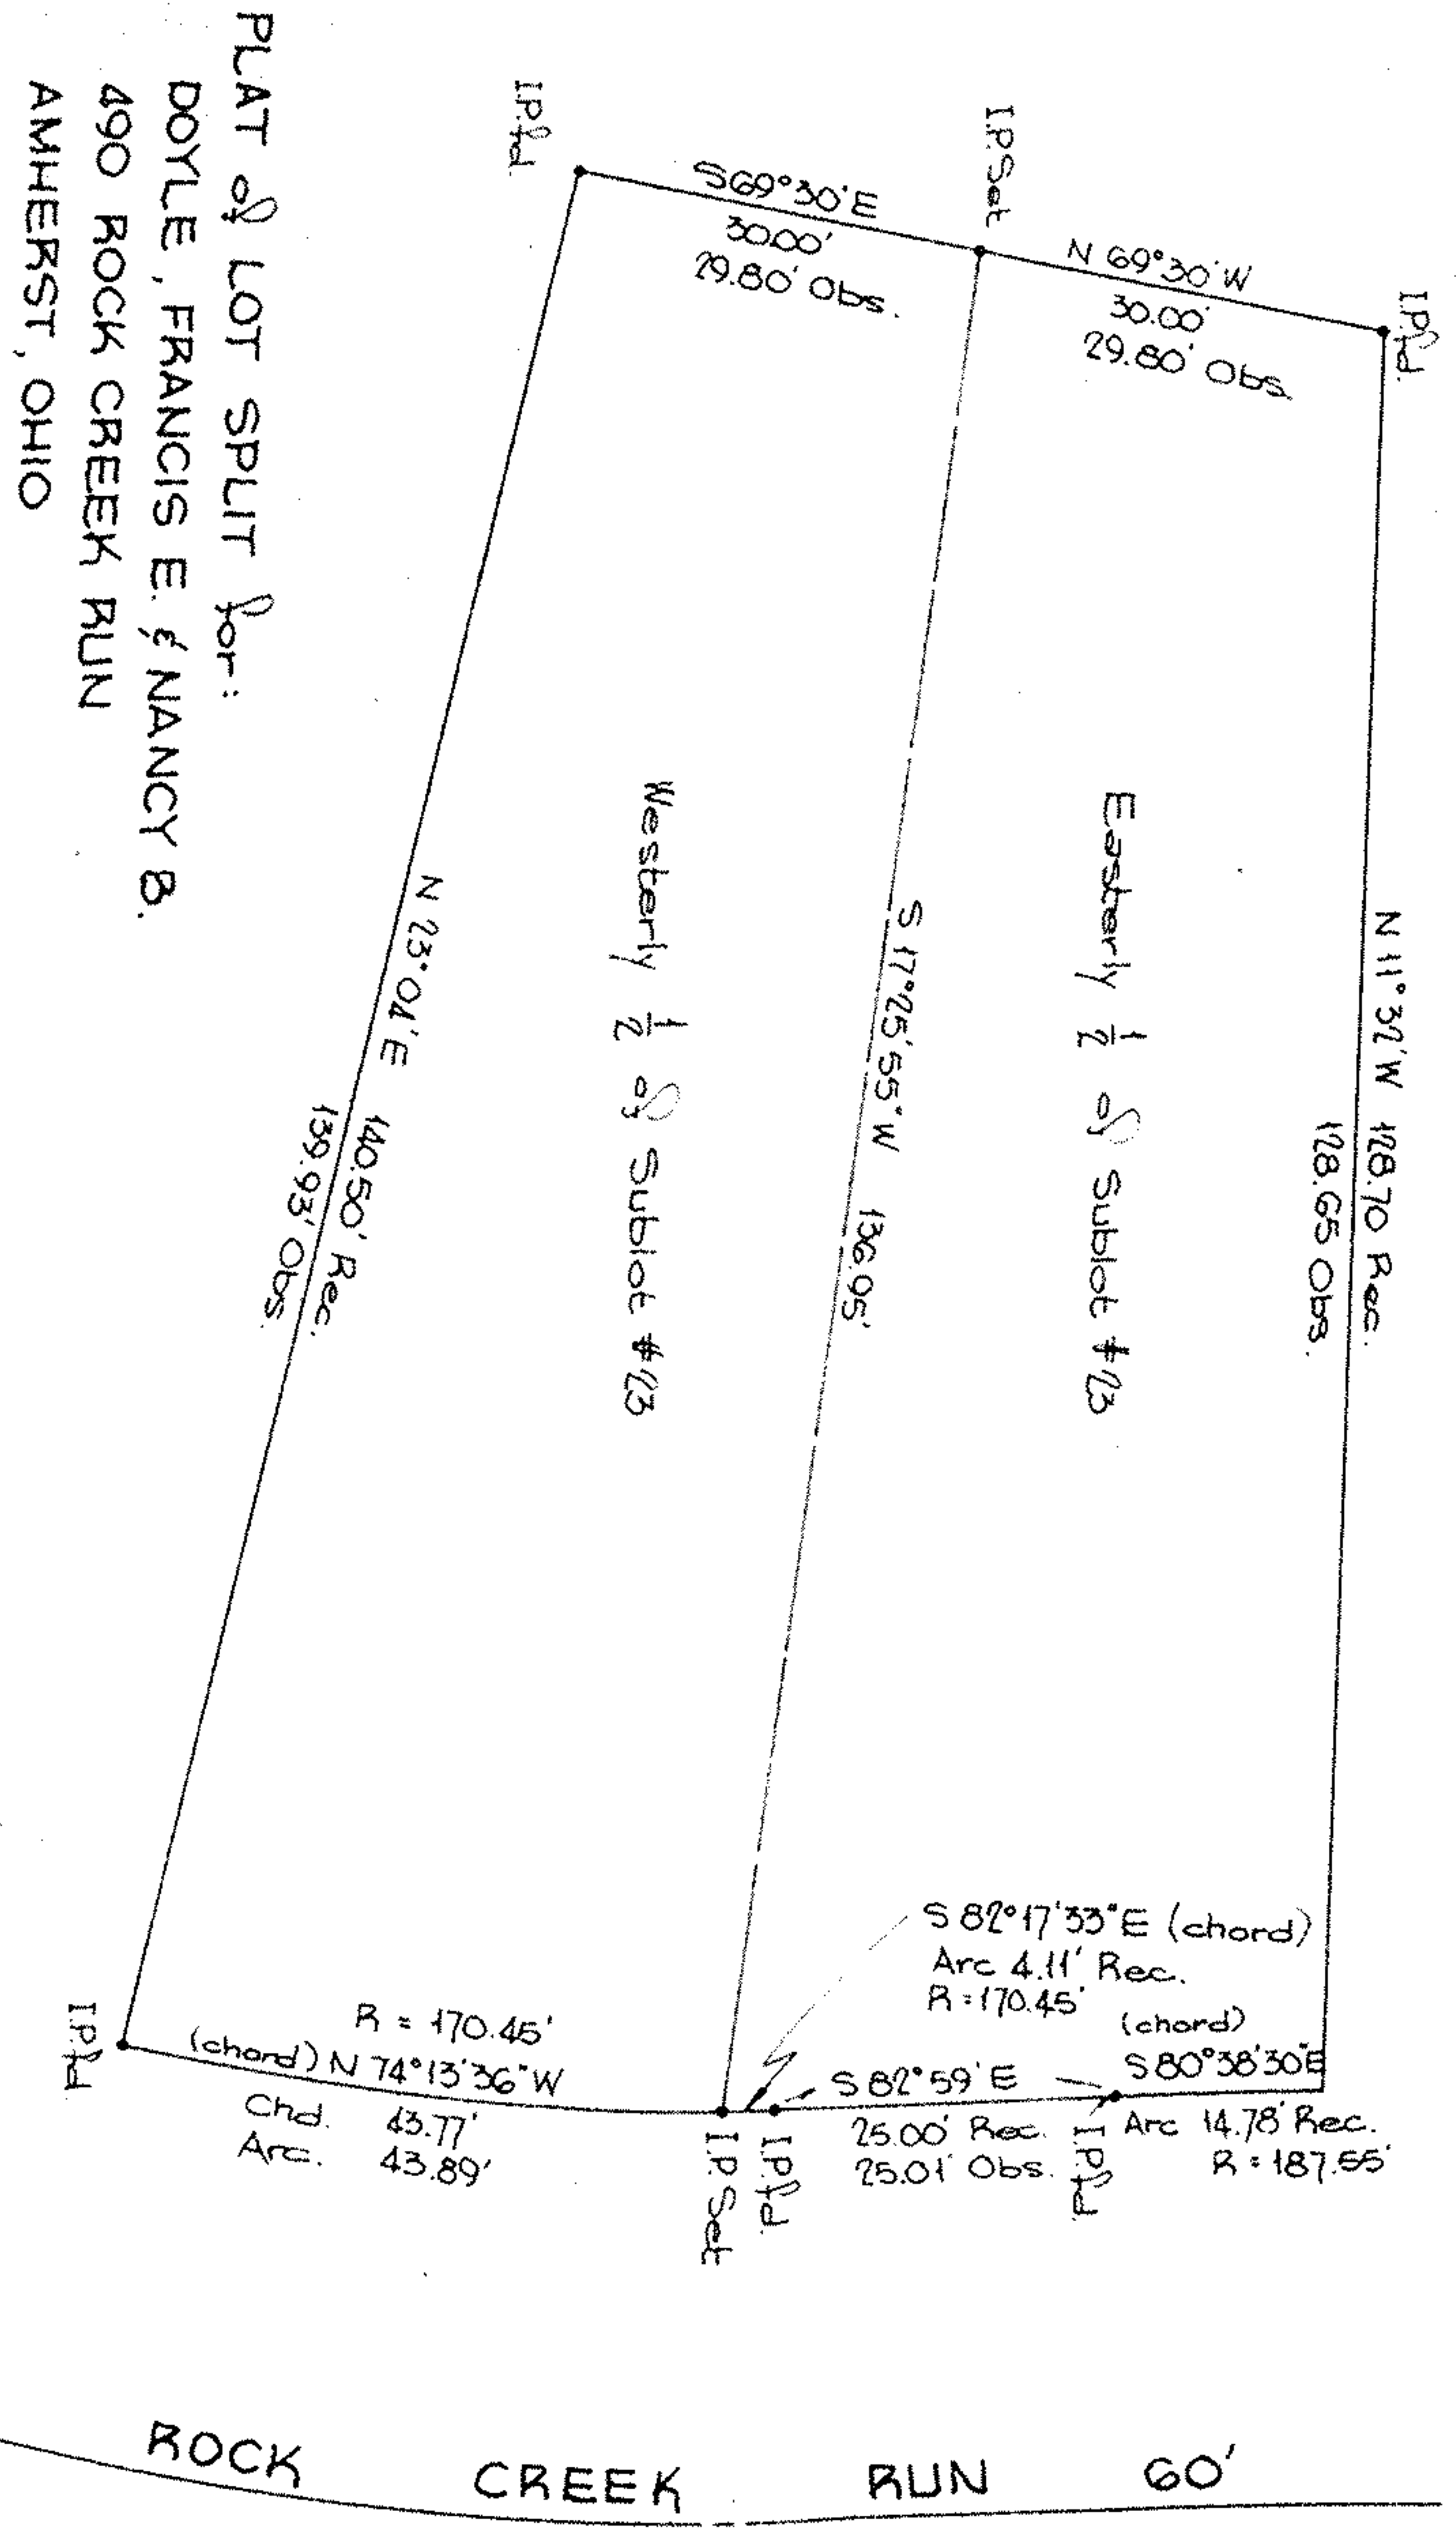

PLAT of LOT SPLIT for:  
 DOYLE, FRANCIS E. & NANCY B.  
 490 ROCK CREEK RUN  
 AMHERST, OHIO

SUBLOT # 23 of ROCK CREEK SUBDIVISION  
 PLAT VOL. 21, Pg. 32. PART of ORIG. AMHERST  
 TWP. LOTS 41 and 42  
 NOW IN CITY of AMHERST, OHIO

McGLINCHY and ASSOCIATES  
 PROFESSIONAL ENGINEERS & SURVEYORS  
 538 WEST BROAD STREET - ELYRIA, OH.