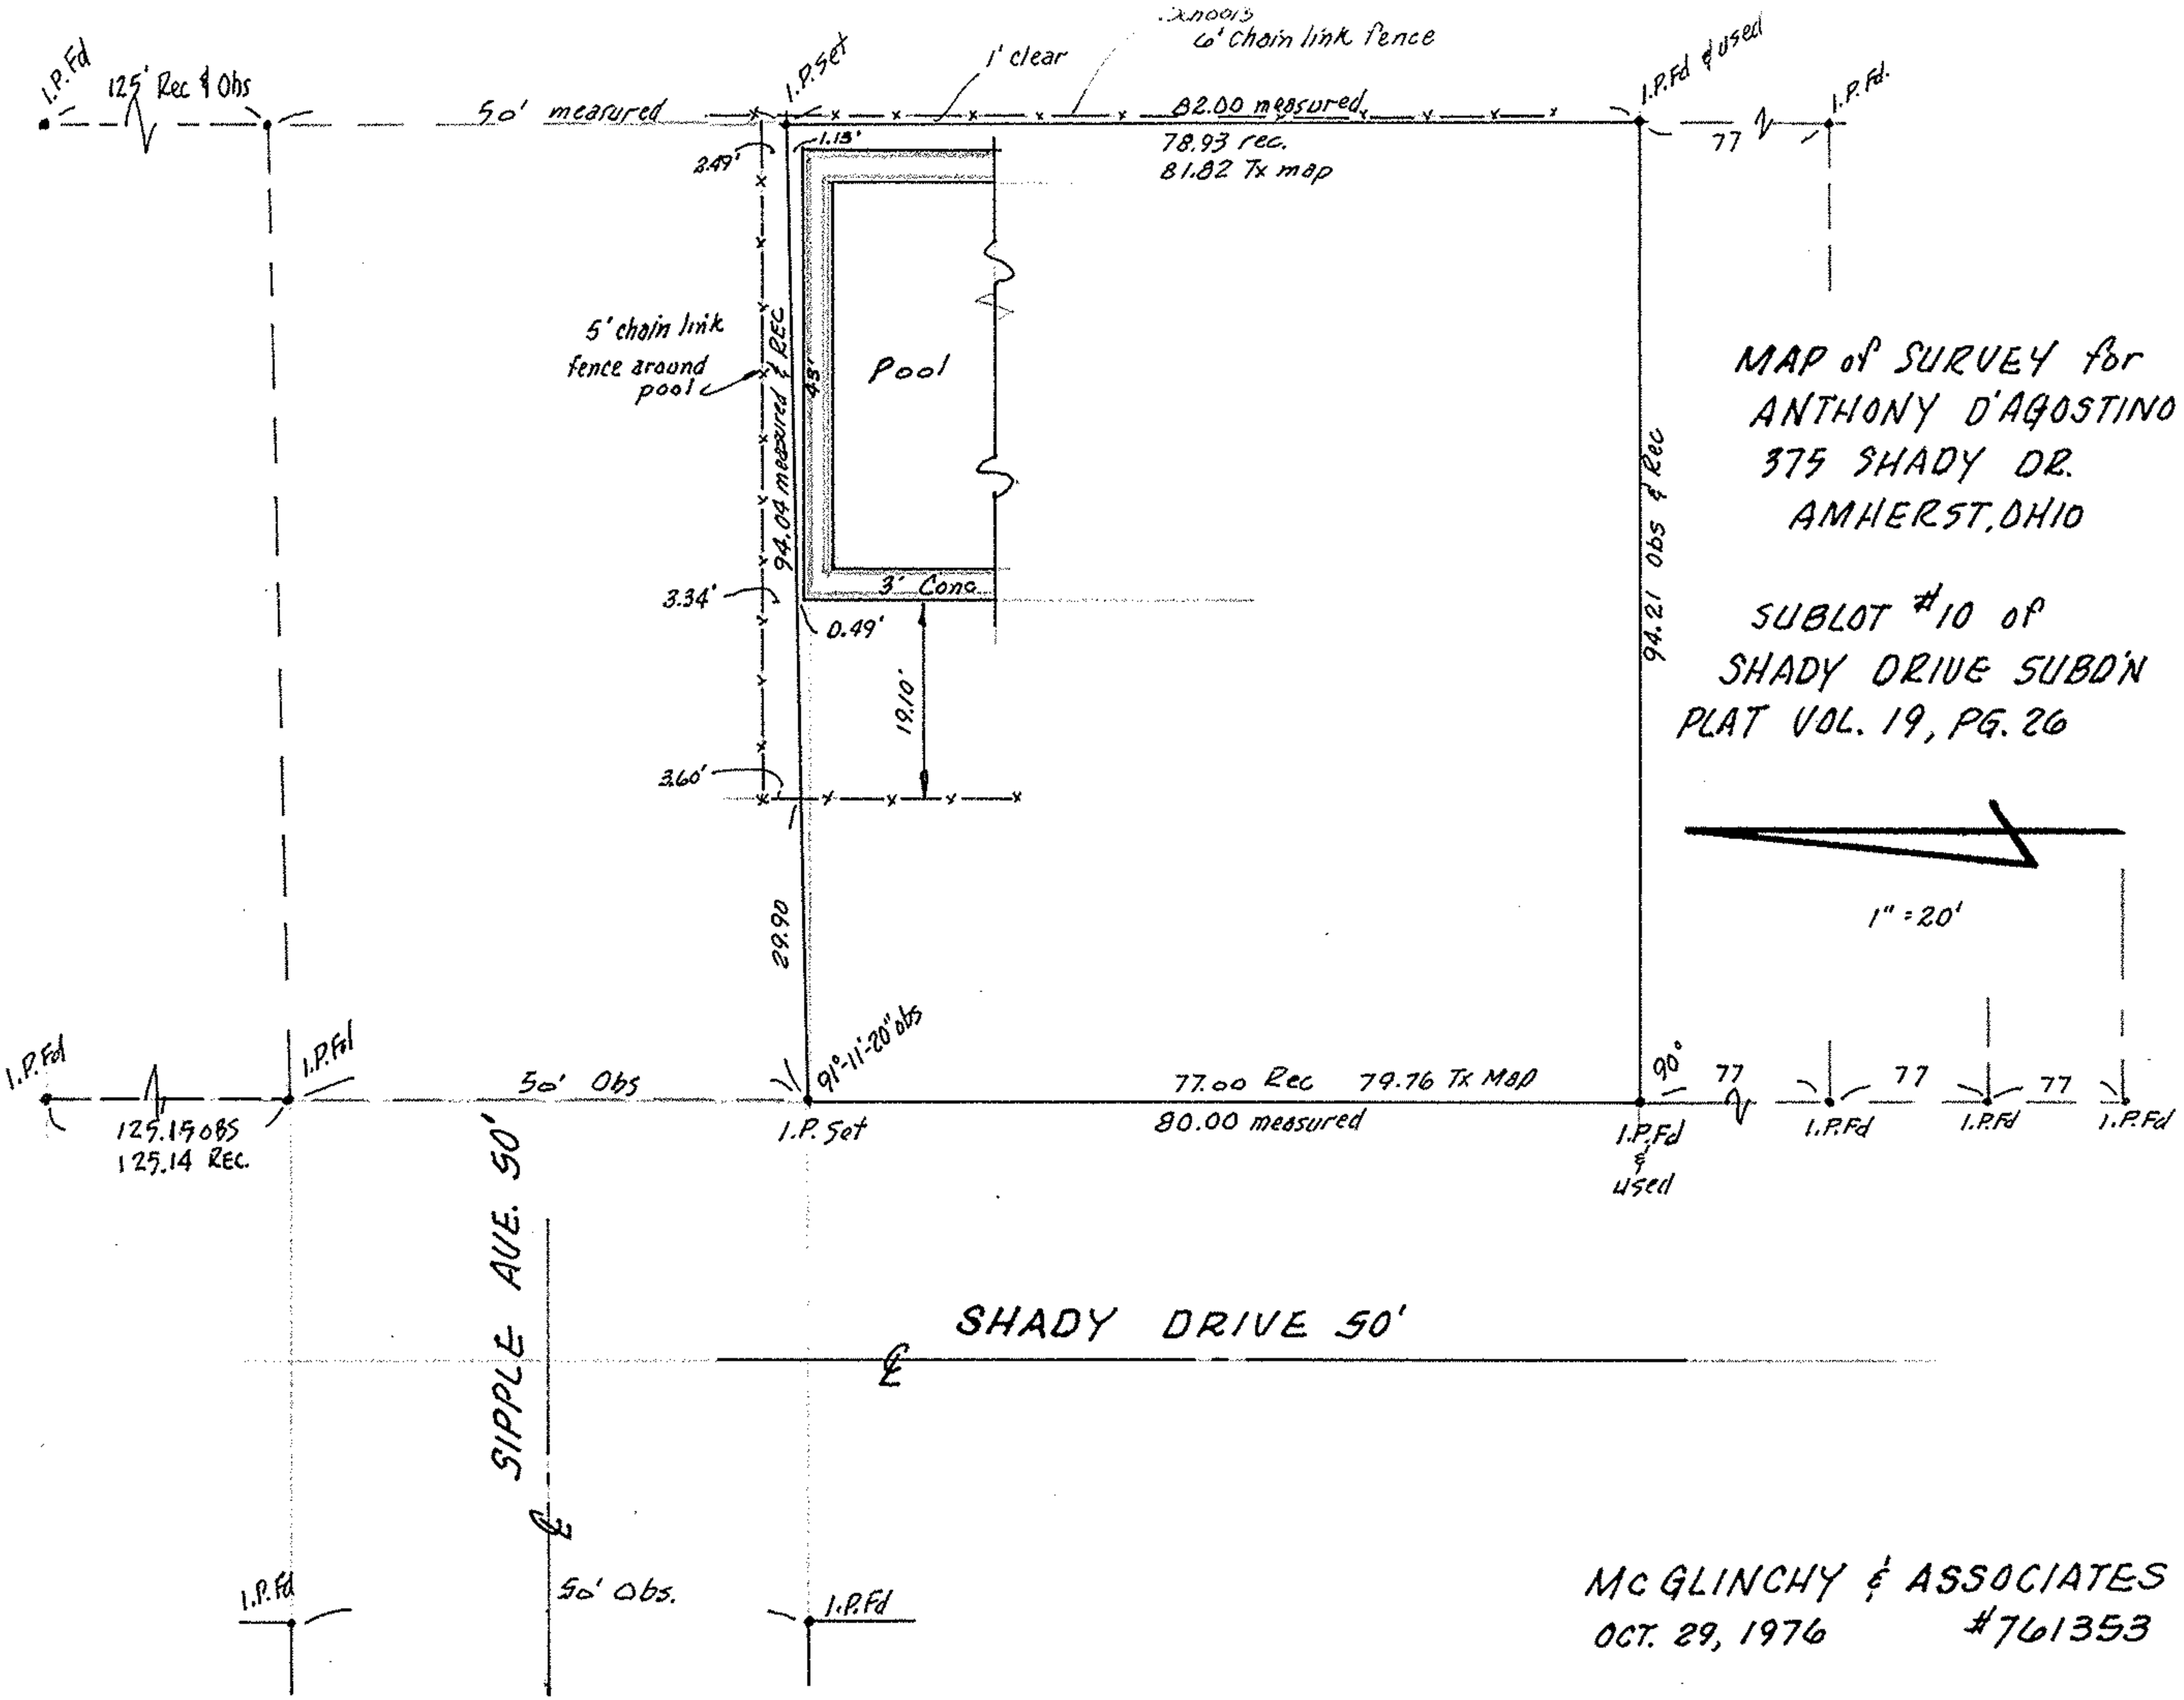

MAP of SURVEY for
ANTHONY D'AGOSTINO
375 SHADY DR.
AMHERST, OHIO

SUBLOT #10 of
SHADY DRIVE SUBD'N
PLAT VOL. 19, PG. 26

1" = 20'

McGLINCHY & ASSOCIATES
OCT. 29, 1976 #761353