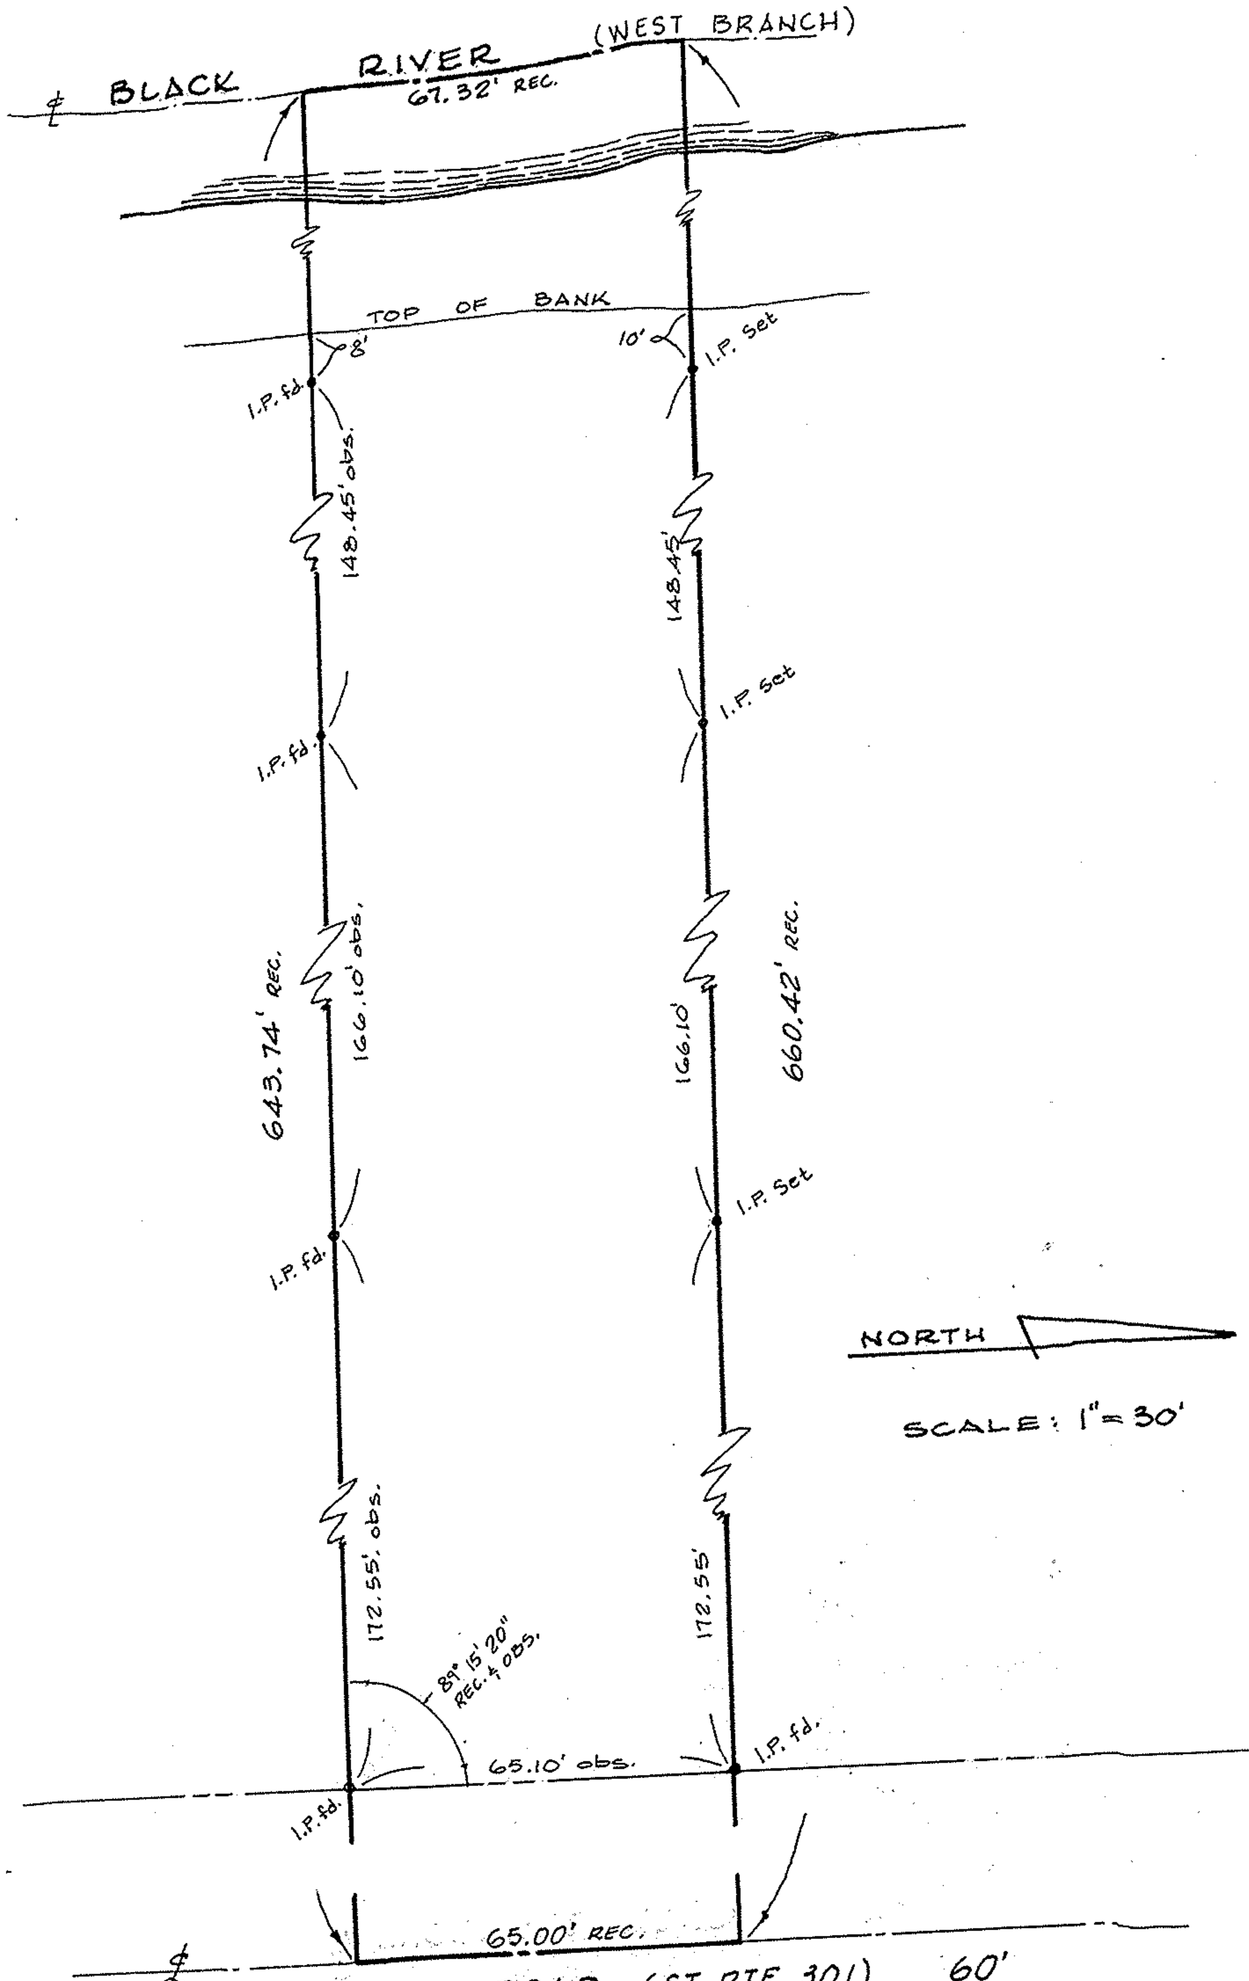

MAP OF SURVEY

PART OF ORIGINAL SECTION No. 8
CARLISLE TWP., LORAIN COUNTY, OHIO
JANUARY 20, 1977

McGLINCHY & ASSOCIATES
538 WEST BROAD STREET
ELYRIA, OHIO 44035
JOB NO. 761502