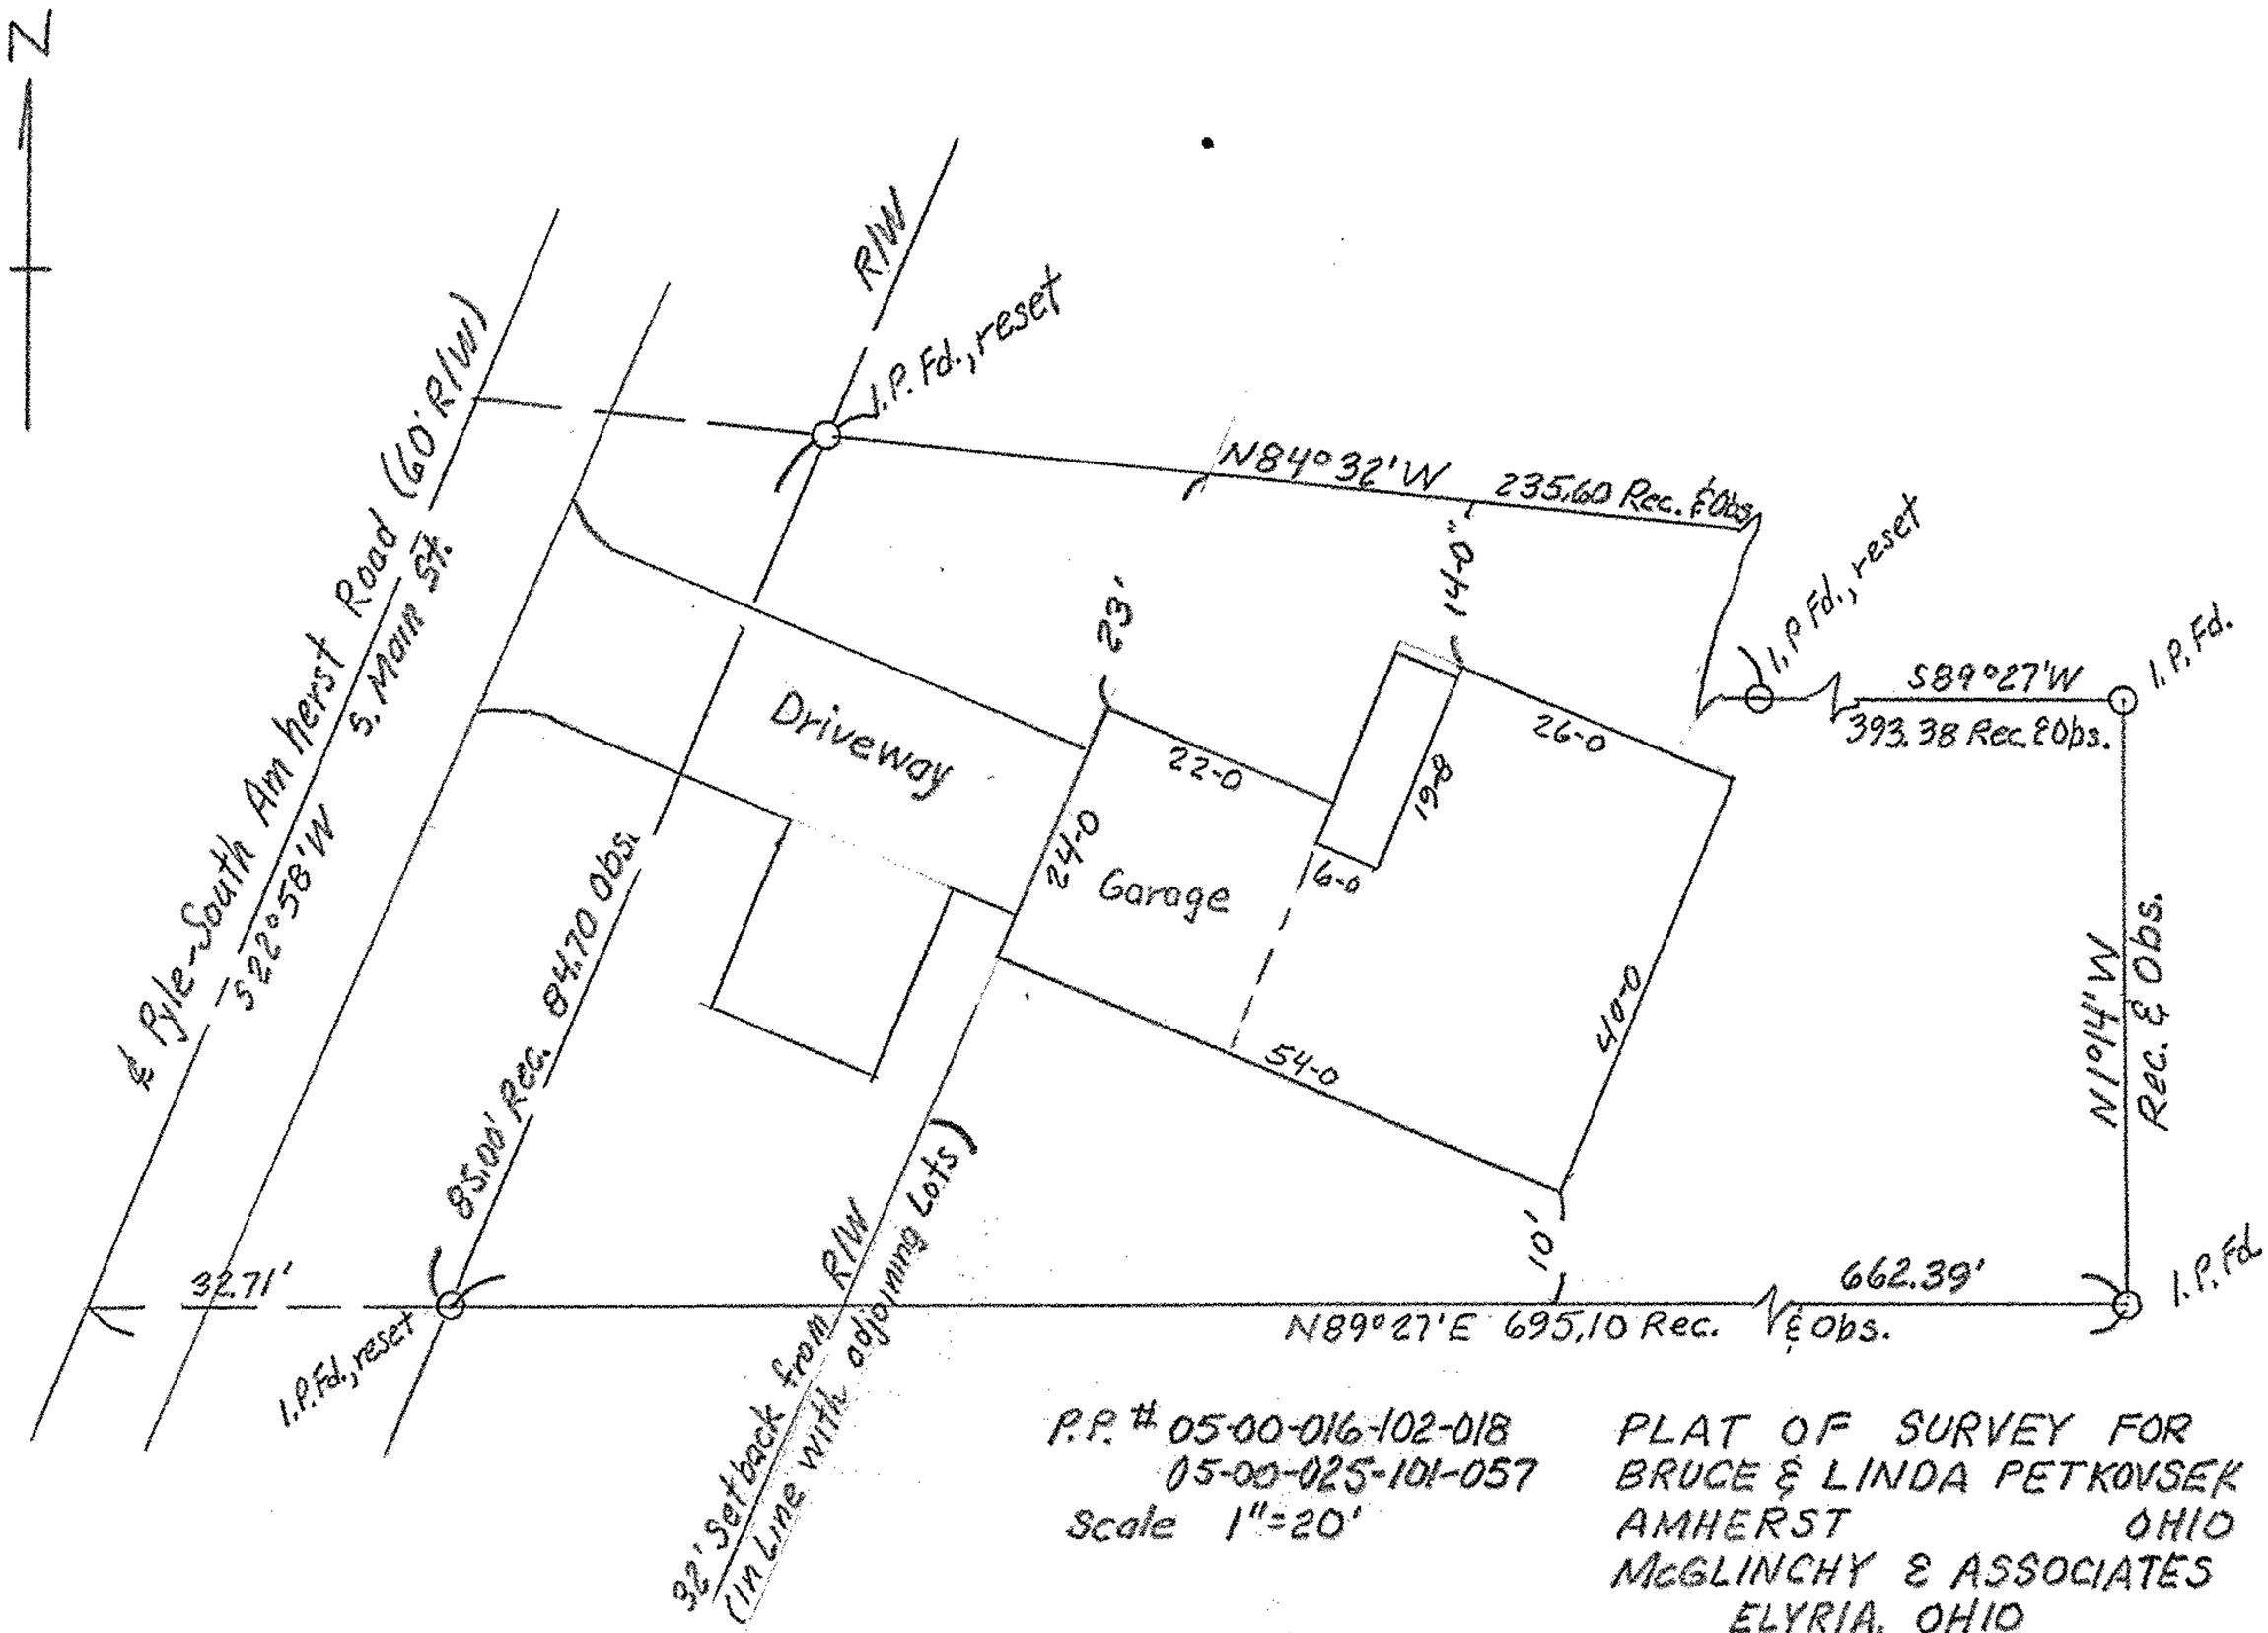

P.P. # 05-00-016-102-018
05-00-025-101-057
Scale 1"=20'

PLAT OF SURVEY FOR
BRUCE & LINDA PETKOVSEK
AMHERST OHIO
McGLINCHY & ASSOCIATES
ELYRIA, OHIO
837798A