


VILLAGE OF SOUTH AMHERST

D.V. 237 P. 249

MAP OF SURVEY
 FOR TRUSTEES OF CEMETARY
 SOUTH AMHERST VILLAGE,
 LORAIN COUNTY, OHIO.
 SCALE 1"=60' JULY 19, 1958
 BY ARNOLD F. KOEPP REG SUR

BEING PART OF O.L. 10
AMHERST TWP.

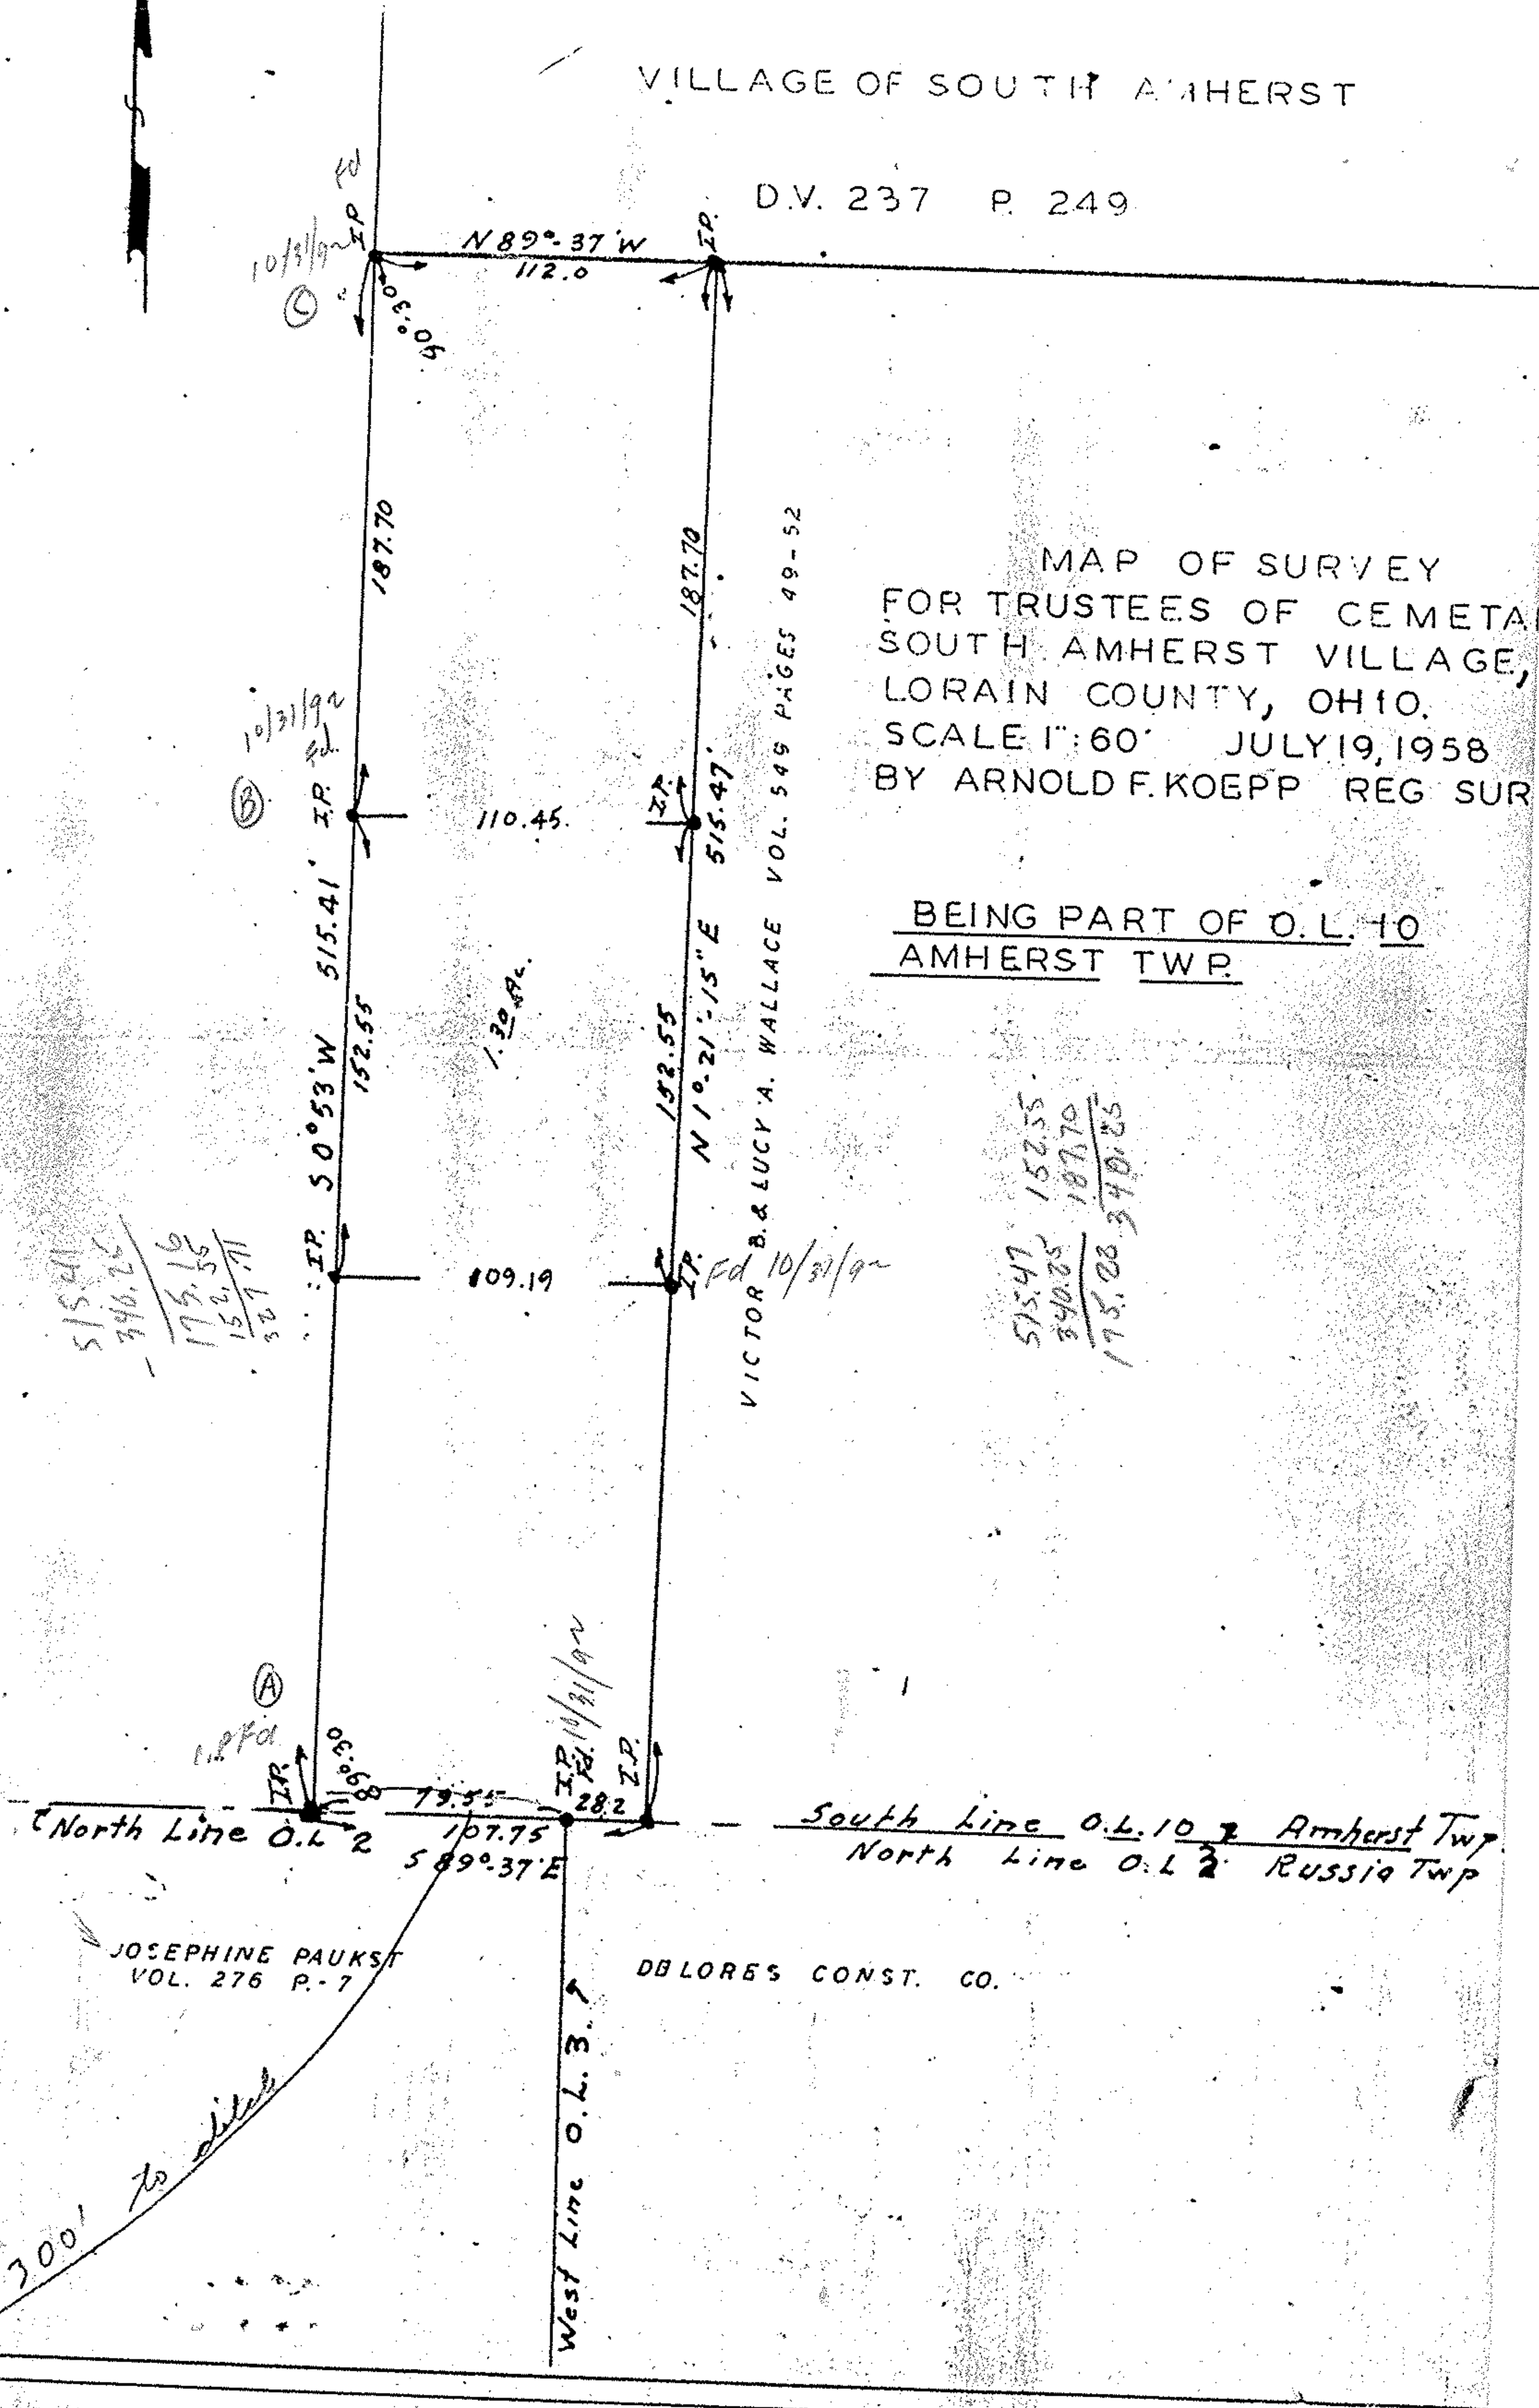

515.41
 - 346.26

 175.16
 152.55

 327.71

515.47
 - 346.26

 175.00
 187.70

 340.25

VICTOR B. & LUCY A. WALLACE VOL. 549 PAGES 49-52

JOSEPHINE PAUKST
 VOL. 276 P. 7

DB LORE'S CONST. CO.

300' to ditch

West Line O.L. 3

South Line O.L. 10 & Amherst Twp
 North Line O.L. 2 & Russia Twp