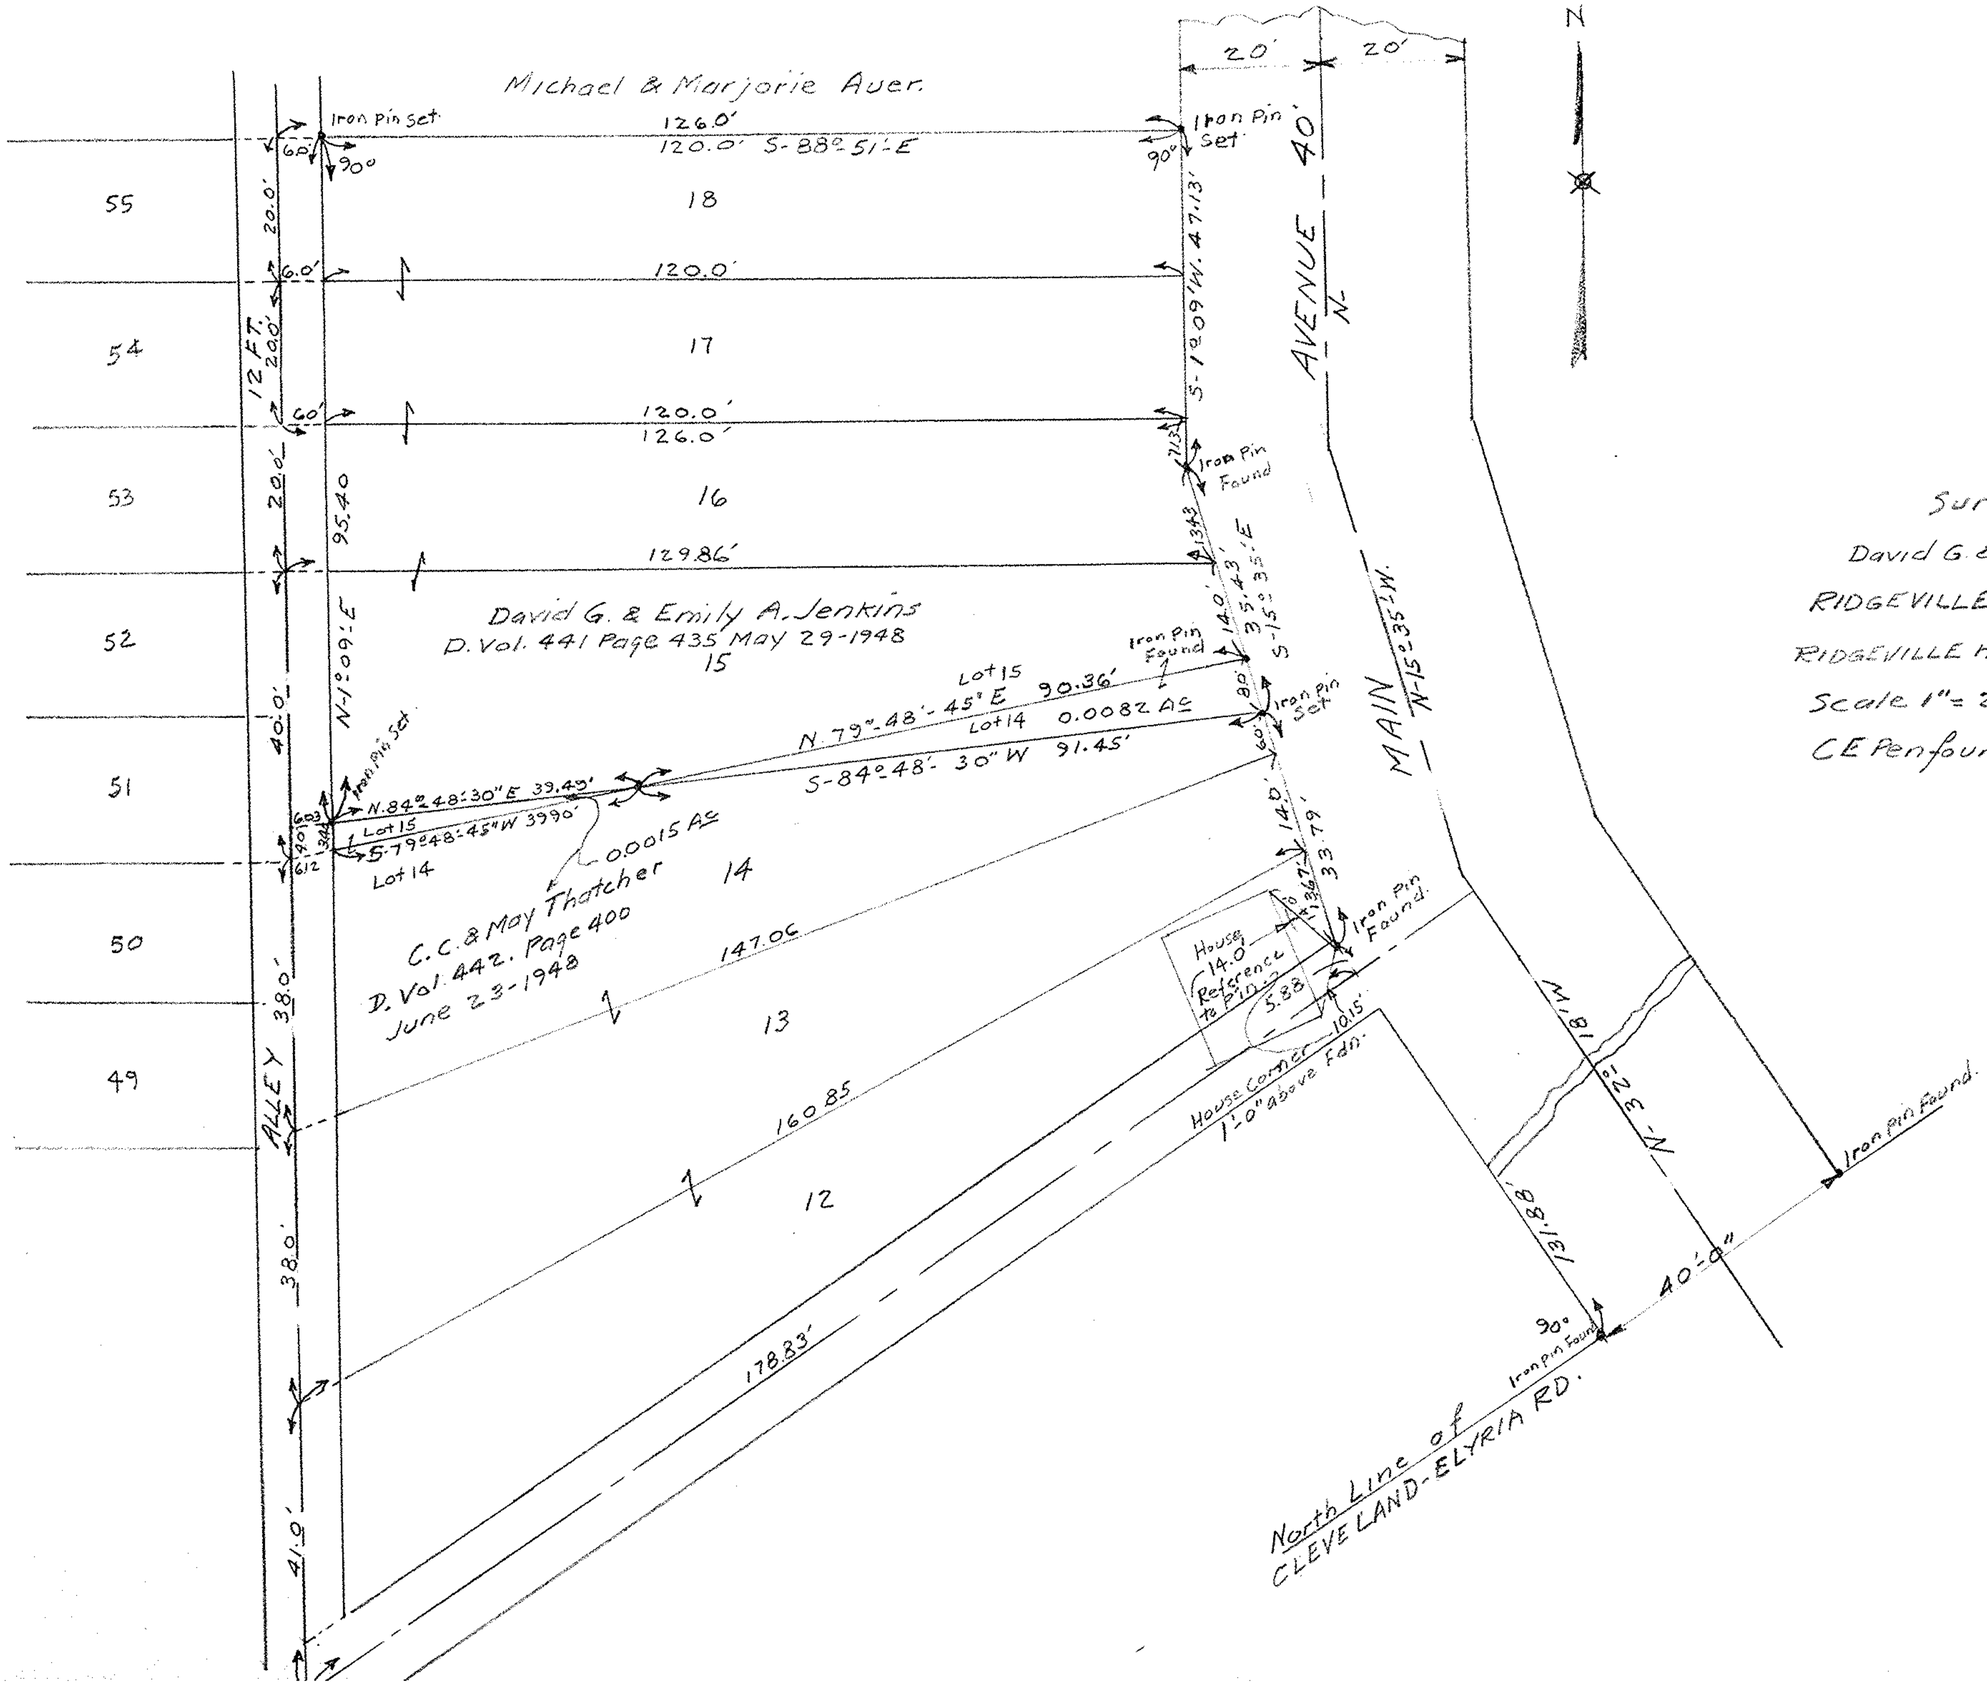

Survey For
David G. & Emily A. Jenkins
RIDGEVILLE TWP. LORAIN CO. OHIO
RIDGEVILLE HEIGTS ALLOT. VOL. 10 Pgs. 11 & 12
Scale 1" = 20 Feet. December 6-1948
CE Penfound Registered Surveyor.

07-00-008

6