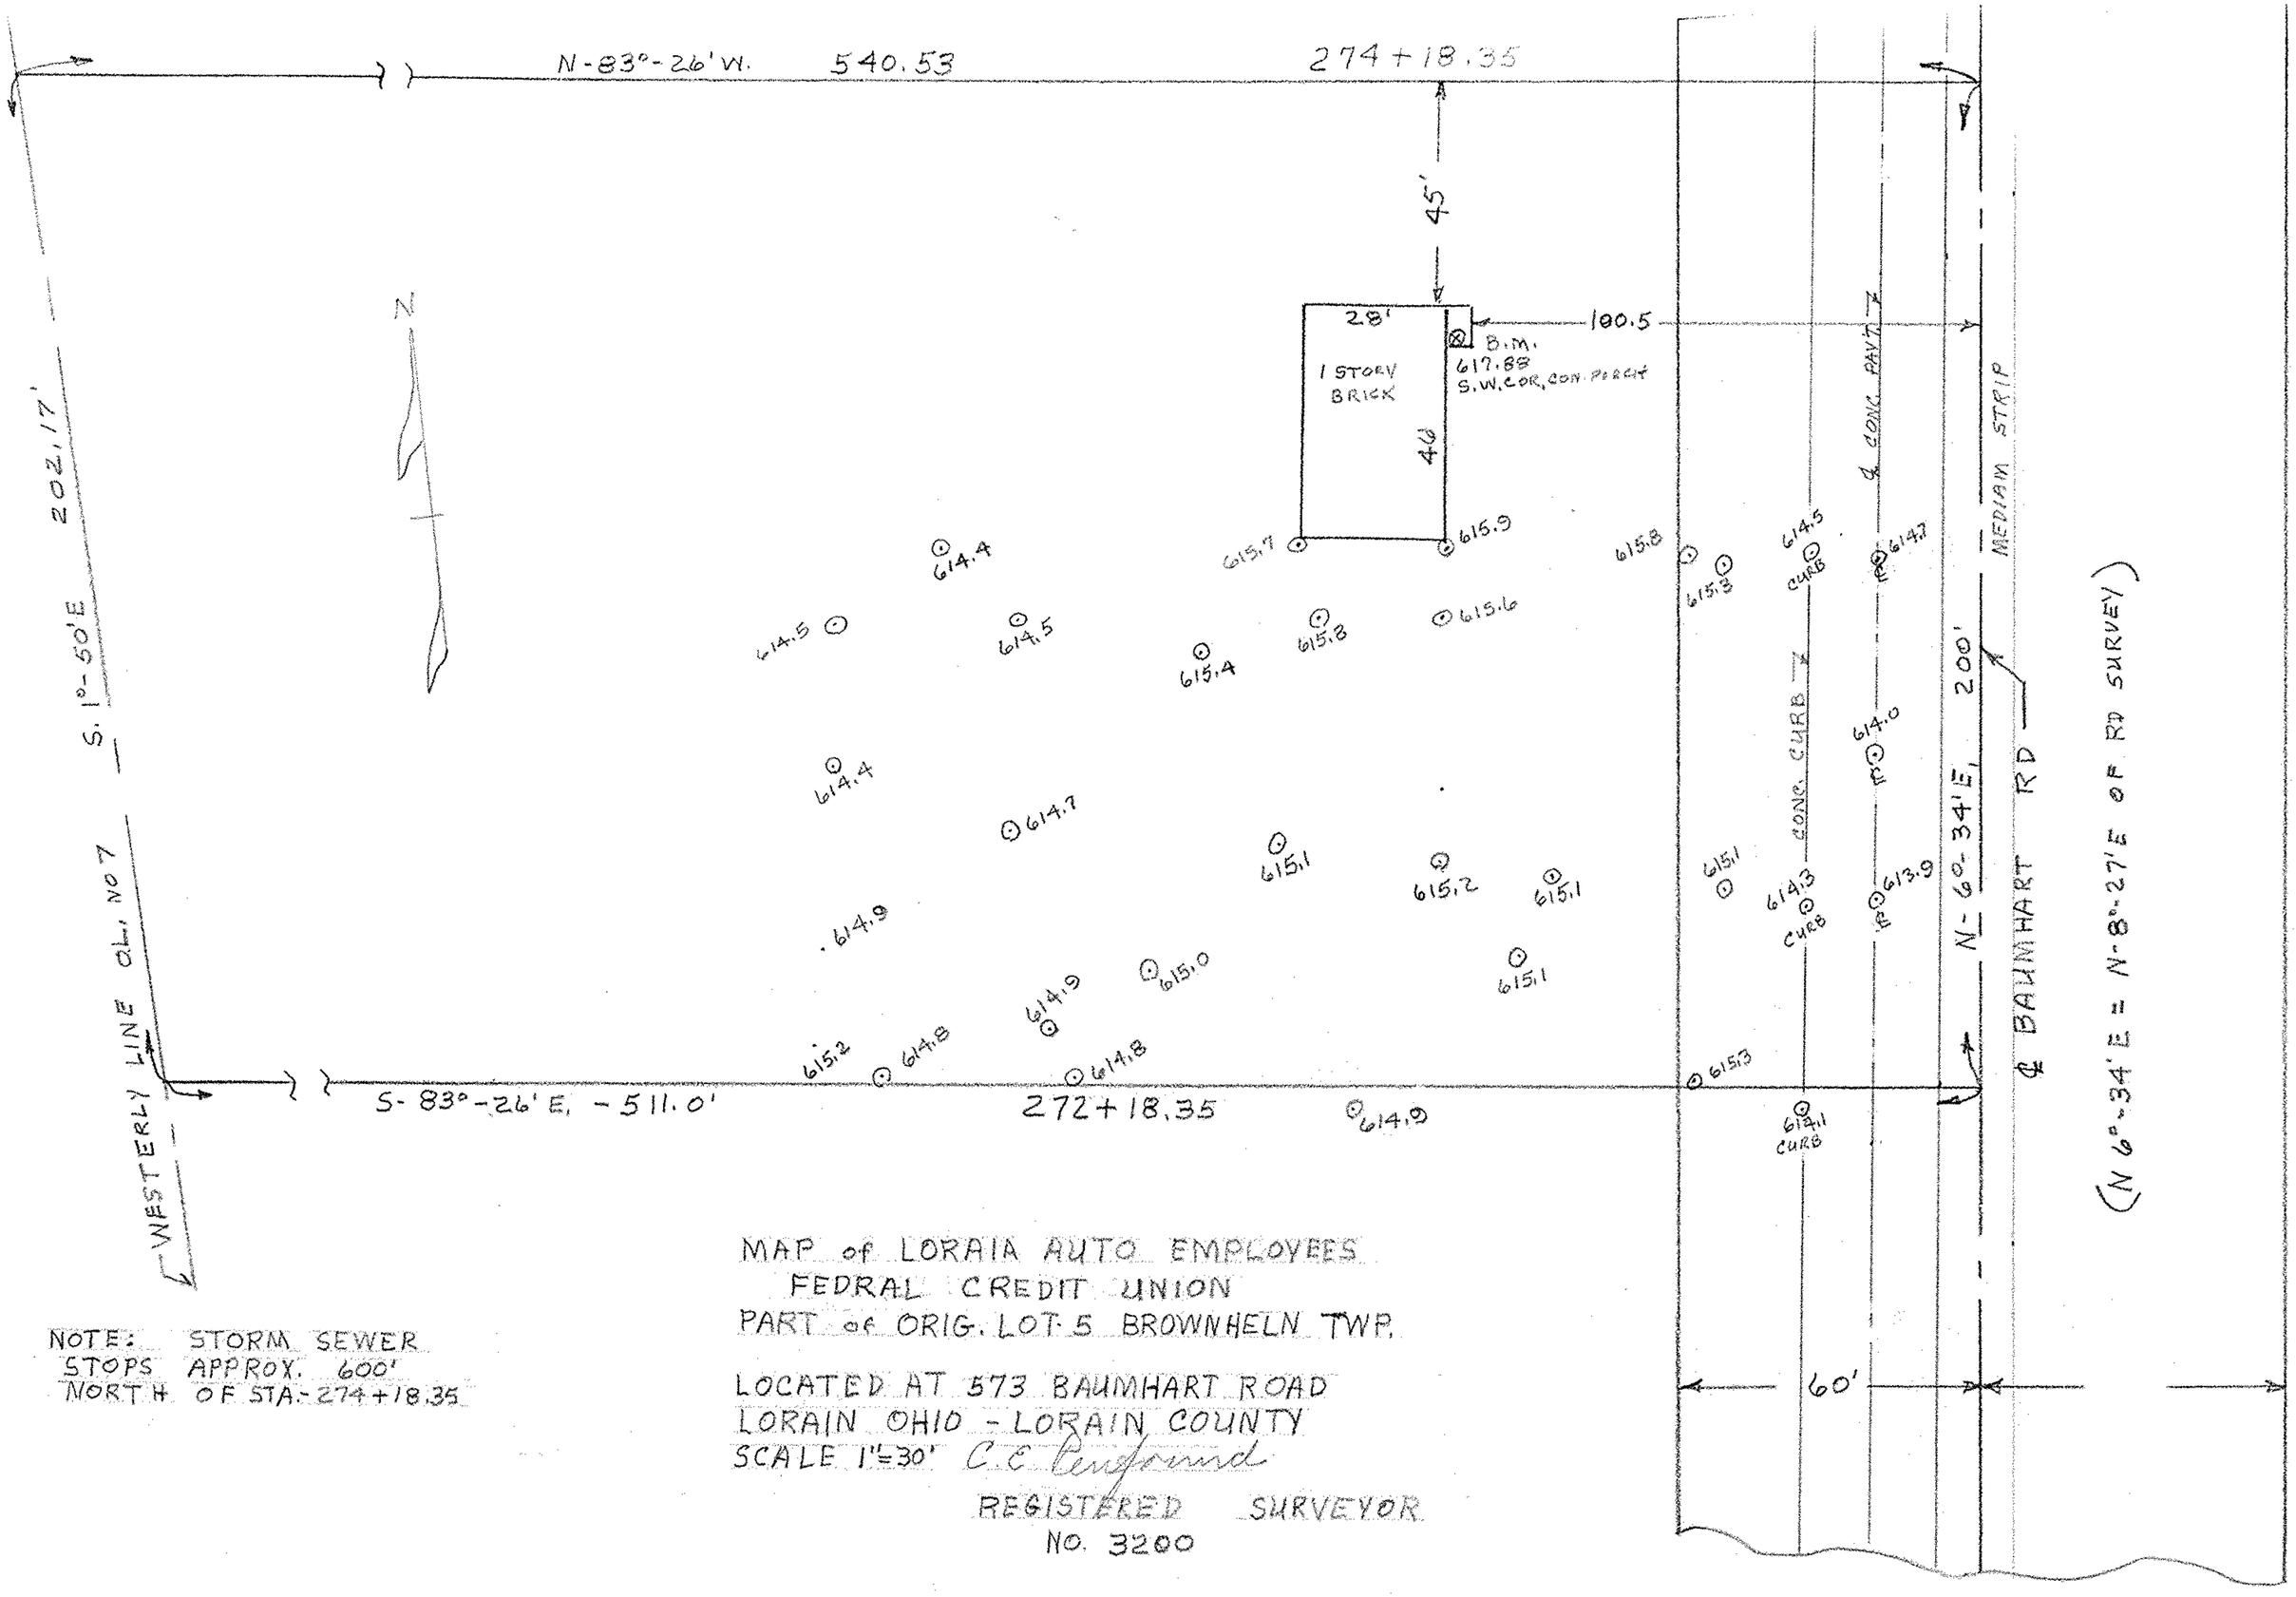

NOTE: STORM SEWER STOPS APPROX. 600' NORTH OF STA.-274+18.35

MAP of LORAIA AUTO EMPLOYEES
FEDRAL CREDIT UNION
PART of ORIG. LOT 5 BROWNHELN TWP.

LOCATED AT 573 BAUMHART ROAD
LORAIN OHIO - LORAIN COUNTY
SCALE 1"=30' C.E. Penfound
REGISTERED SURVEYOR
NO. 3200

01-00-005