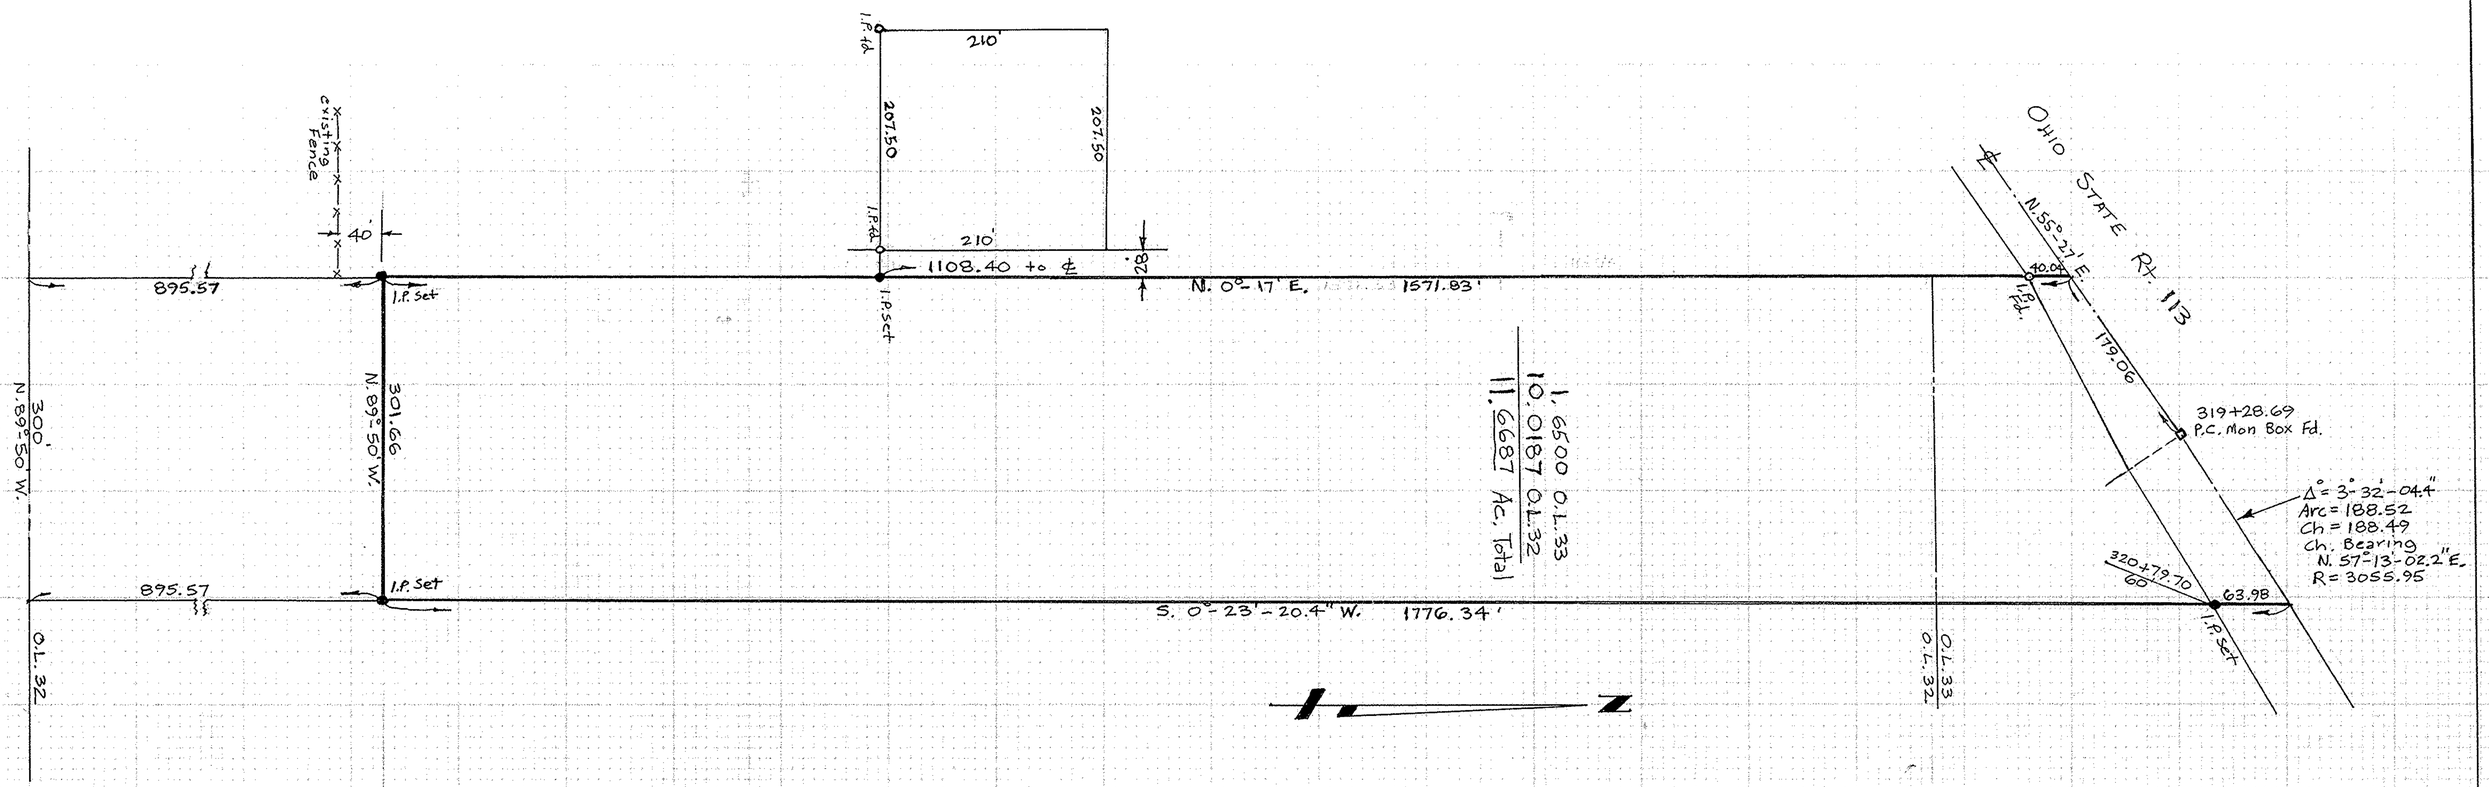

Survey of a 11.6687 acre of land in Original Lot 32, Amherst Township, and in Original Lot 33, Amherst Township, Lorain County, Ohio, for U.S. Auto Raceways, Inc.

Scale 1" = 100' Jan. 12, 1977

mc Glinchy & Associates - 538 Broad St. - Elyria, Ohio

#761509