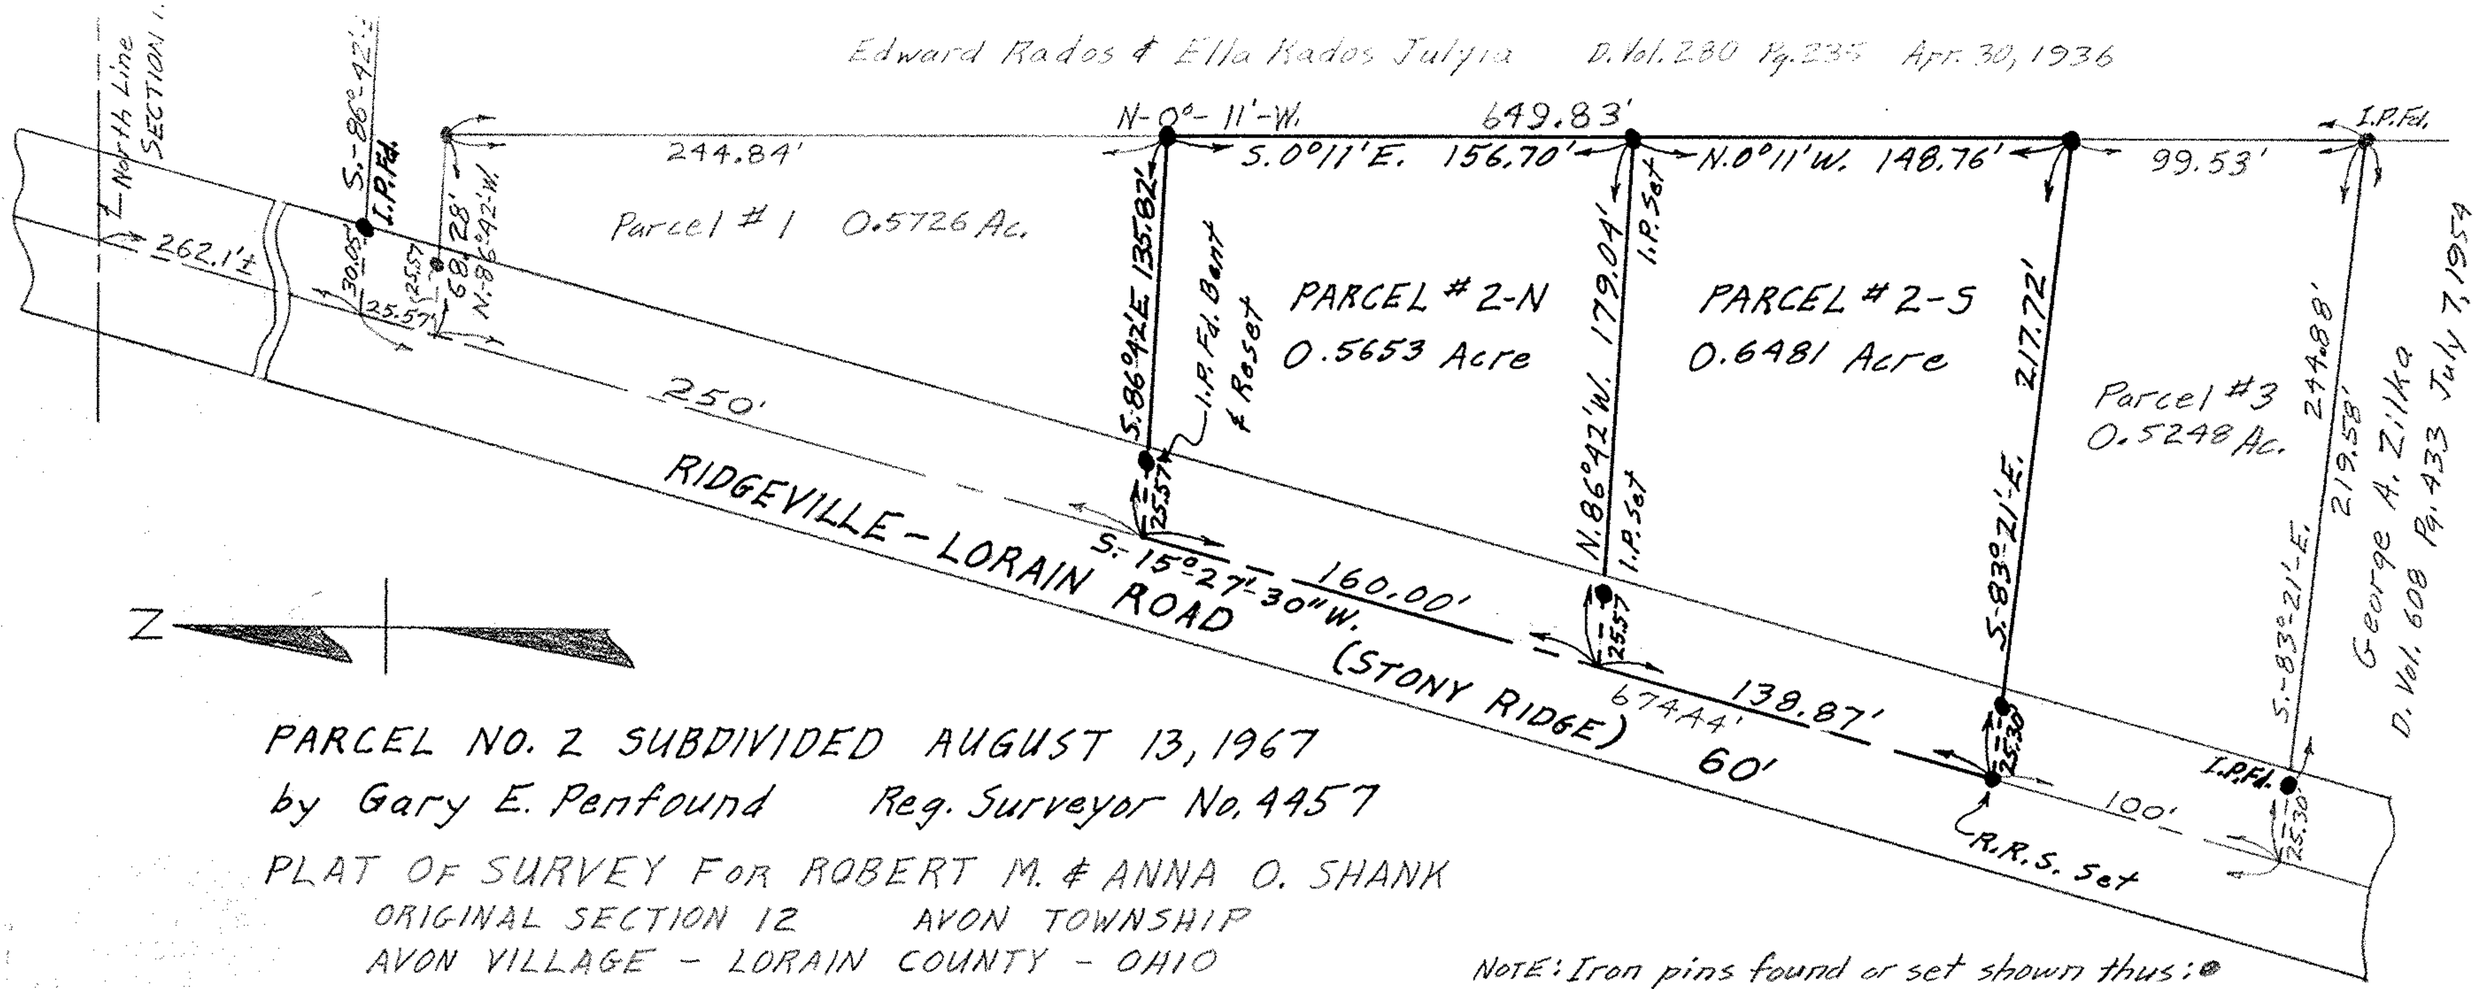

PARCEL NO. 2 SUBDIVIDED AUGUST 13, 1967
by Gary E. Penfound Reg. Surveyor No. 4457

PLAT OF SURVEY FOR ROBERT M. & ANNA O. SHANK
ORIGINAL SECTION 12 AVON TOWNSHIP
AVON VILLAGE - LORAIN COUNTY - OHIO
SCALE: 1" = 60' MAY 20, 1957
C.E. Penfound Registered Surveyor

NOTE: Iron pins found or set shown thus: ●

04-00-012