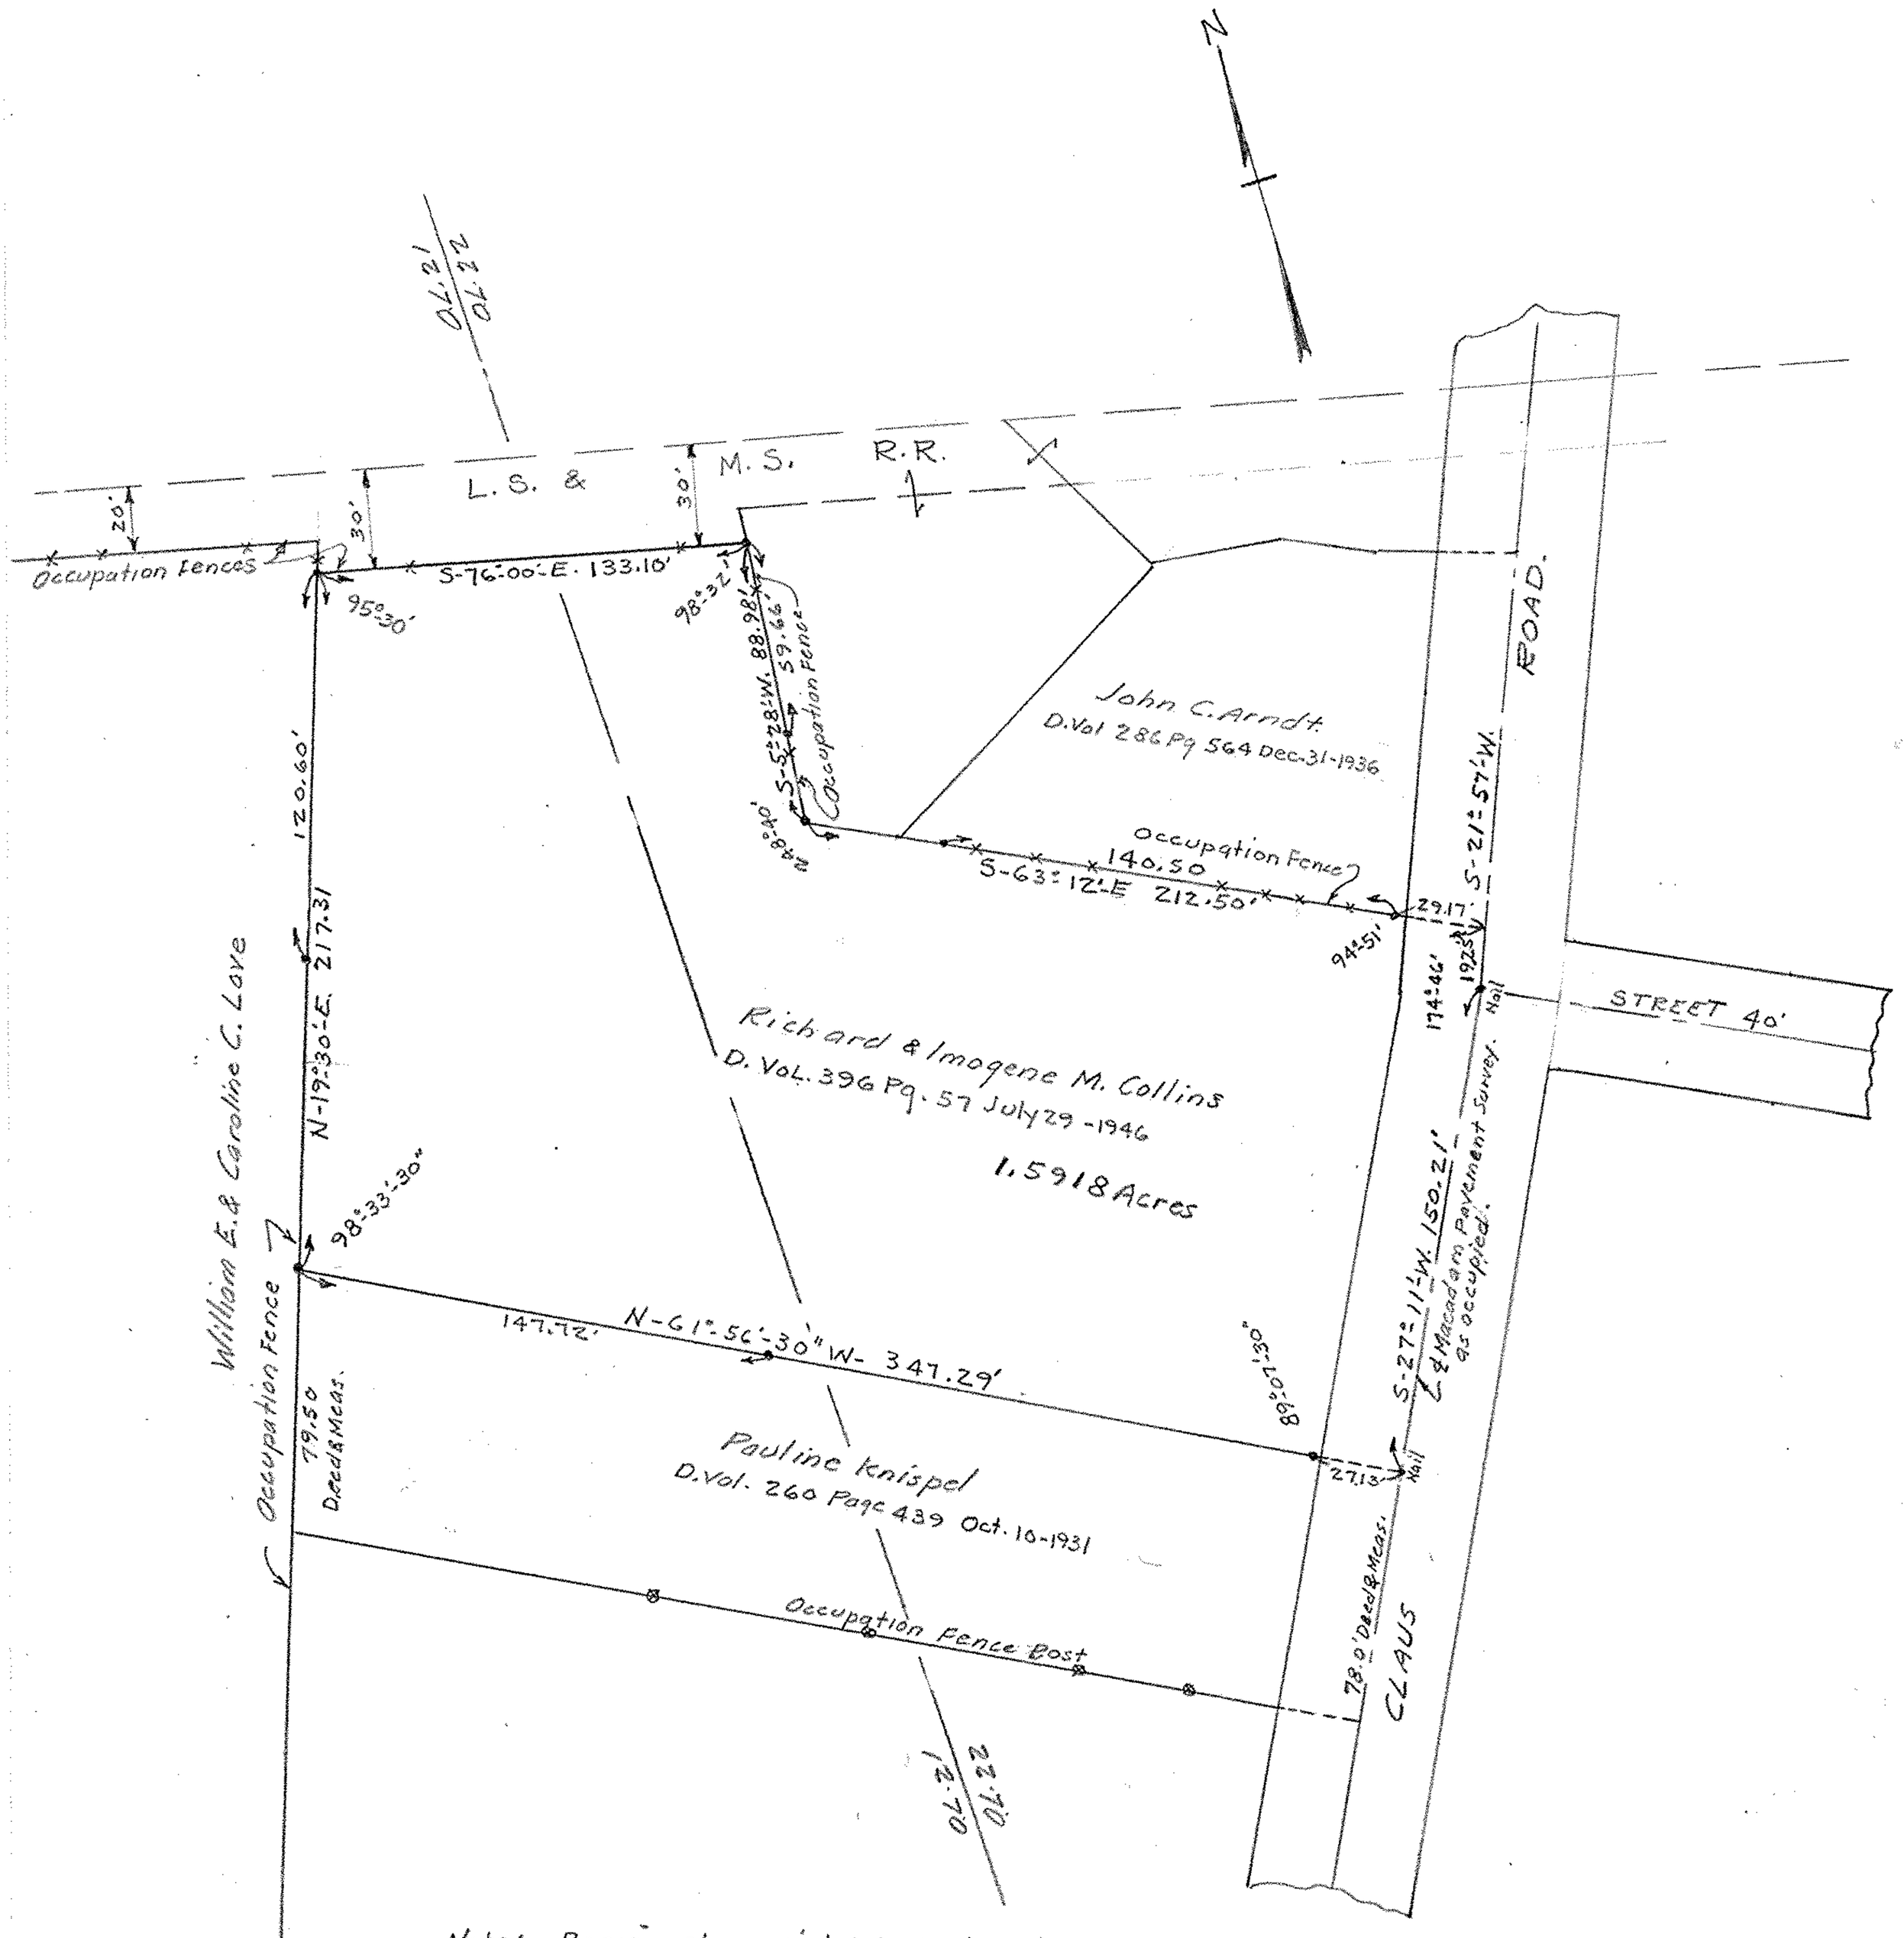

Note:- Bearing shown indicate angles only
Iron pins found or set shown thus. •

MAP OF SURVEY FOR
RICHARD & IMOGENE M. COLLINS
BROWNHELM STATION
O.L. 21 & 22 BROWNHELM TOWNSHIP
LORAIN COUNTY OHIO
Scale 1" = 50' JUNE 23-1952
C.E. Penfound Registered Surveyor.