MAP OF PART OF ORIGINAL LOT NO. 6
BROWNHELM TWP. VERMILION CITY
LORAIN COUNTY OHIO
SCALE: 1"=30' MAY 26-1970 11:00 A.M.

CITY TITLE Co. Order No. E-1135
Holiday Inn # Motel, Inc.

Otho Buehring O.Vol.277 - Pg.449

NOTE: There are no encroachments onto this property, but asphalt turnout encroaches off of property.
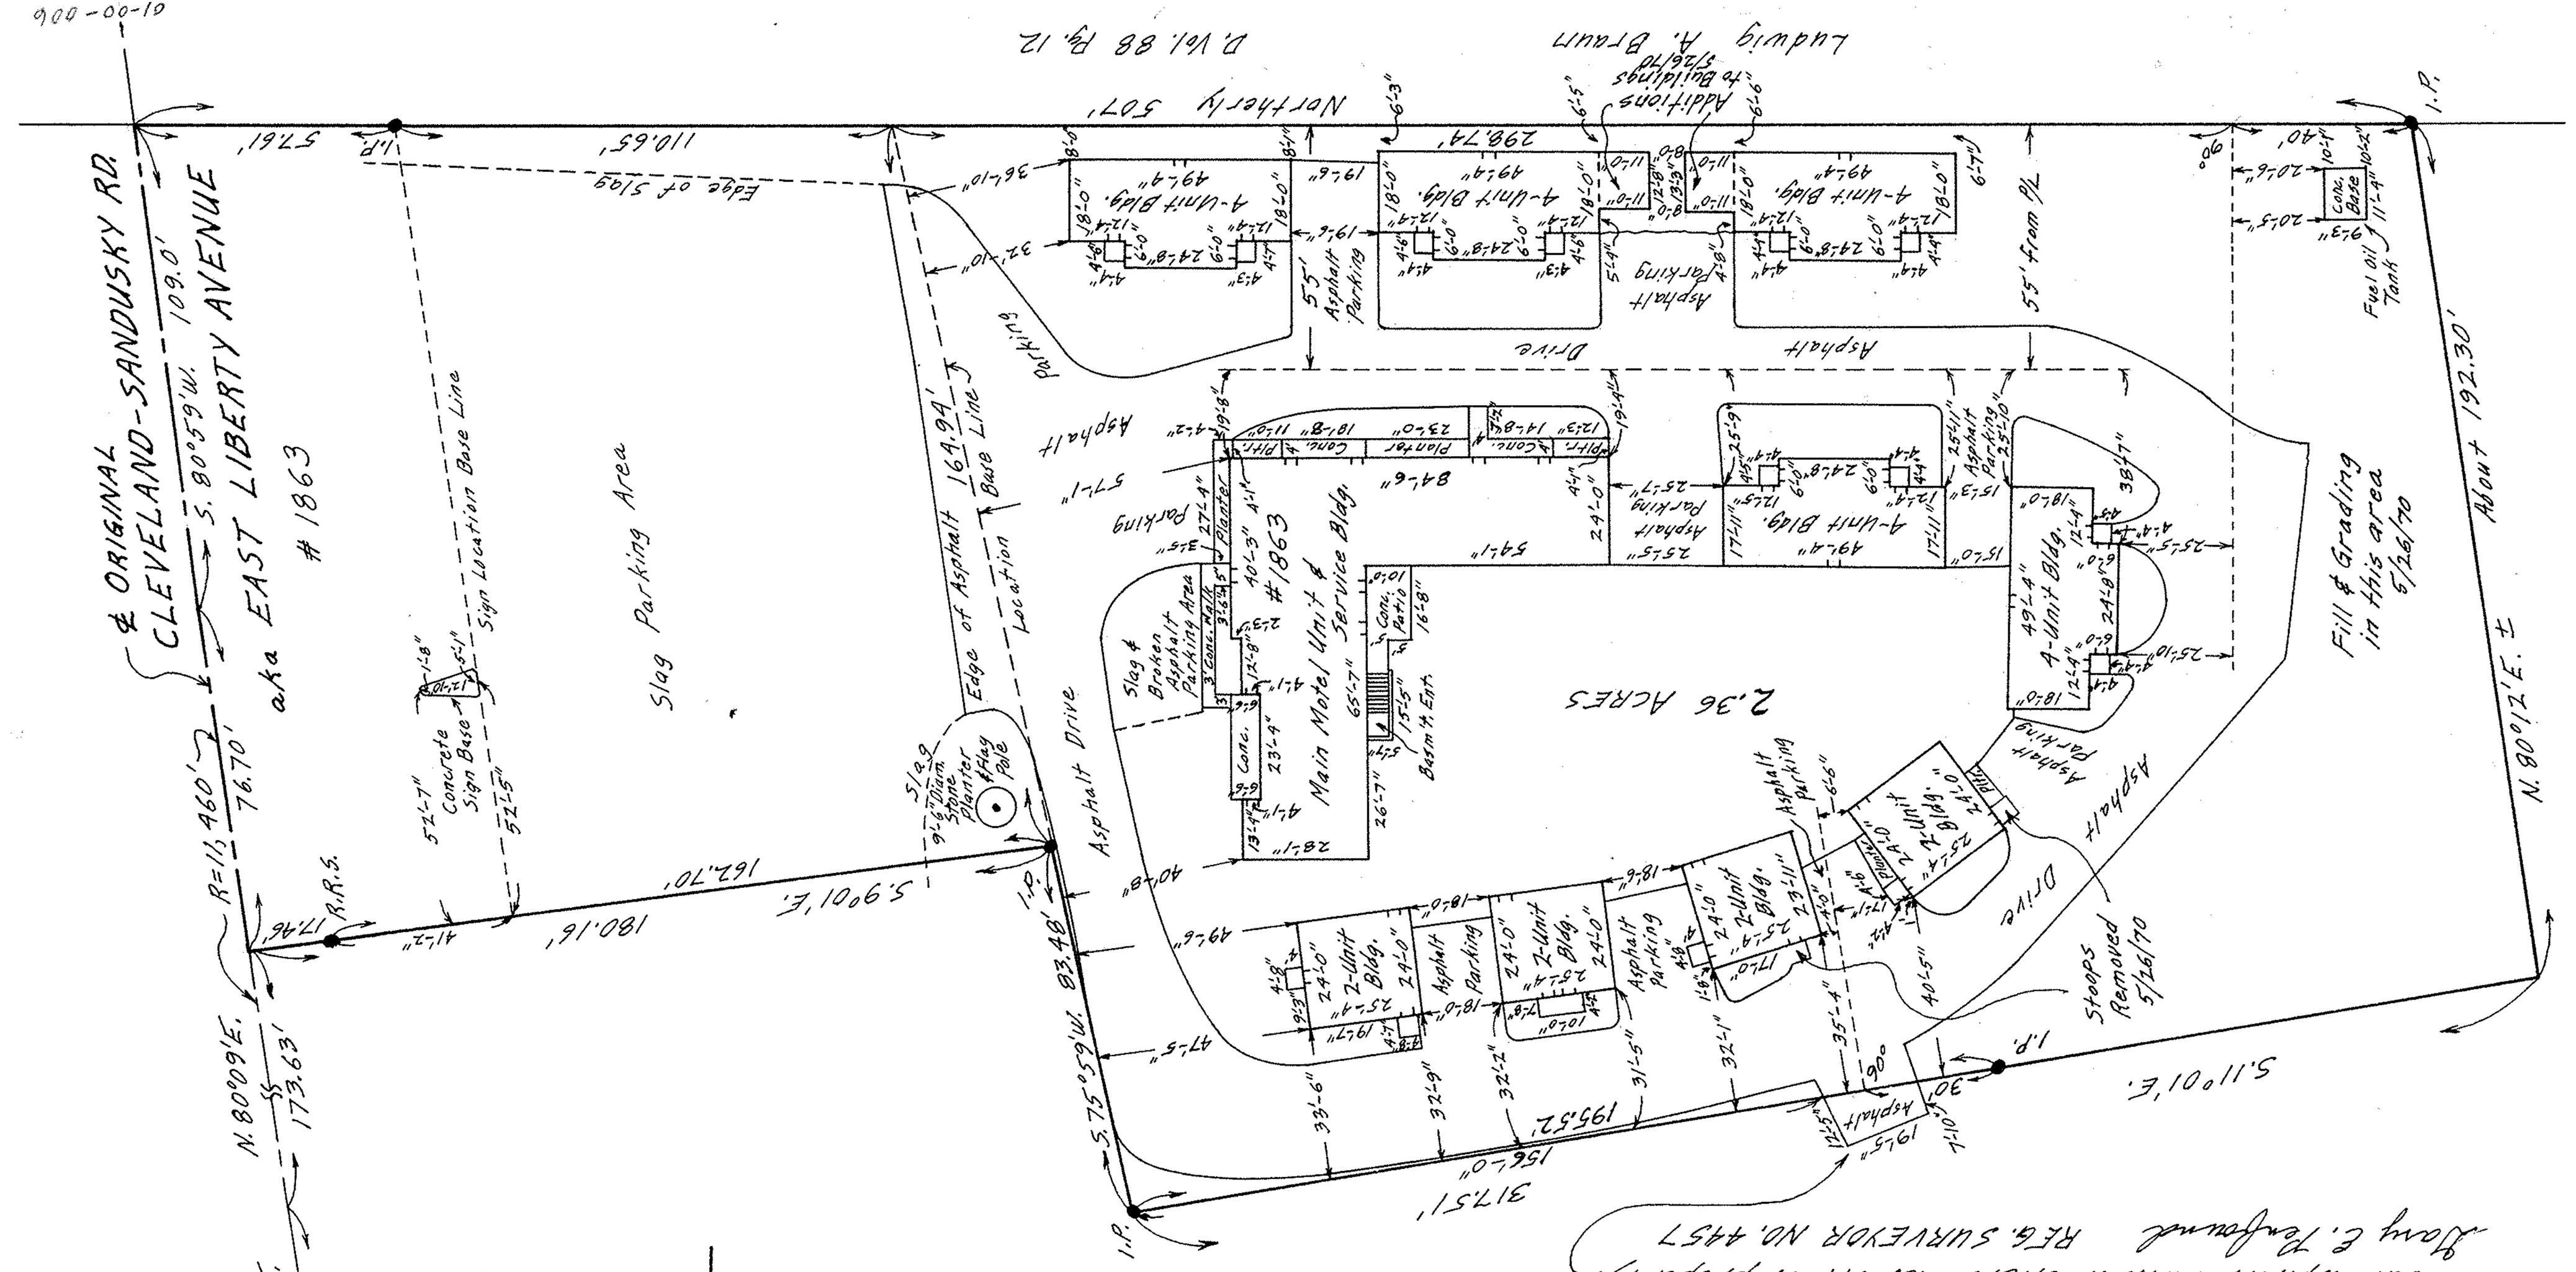
Floyd E. Ferguson REG. SURVEYOR NO. 4457