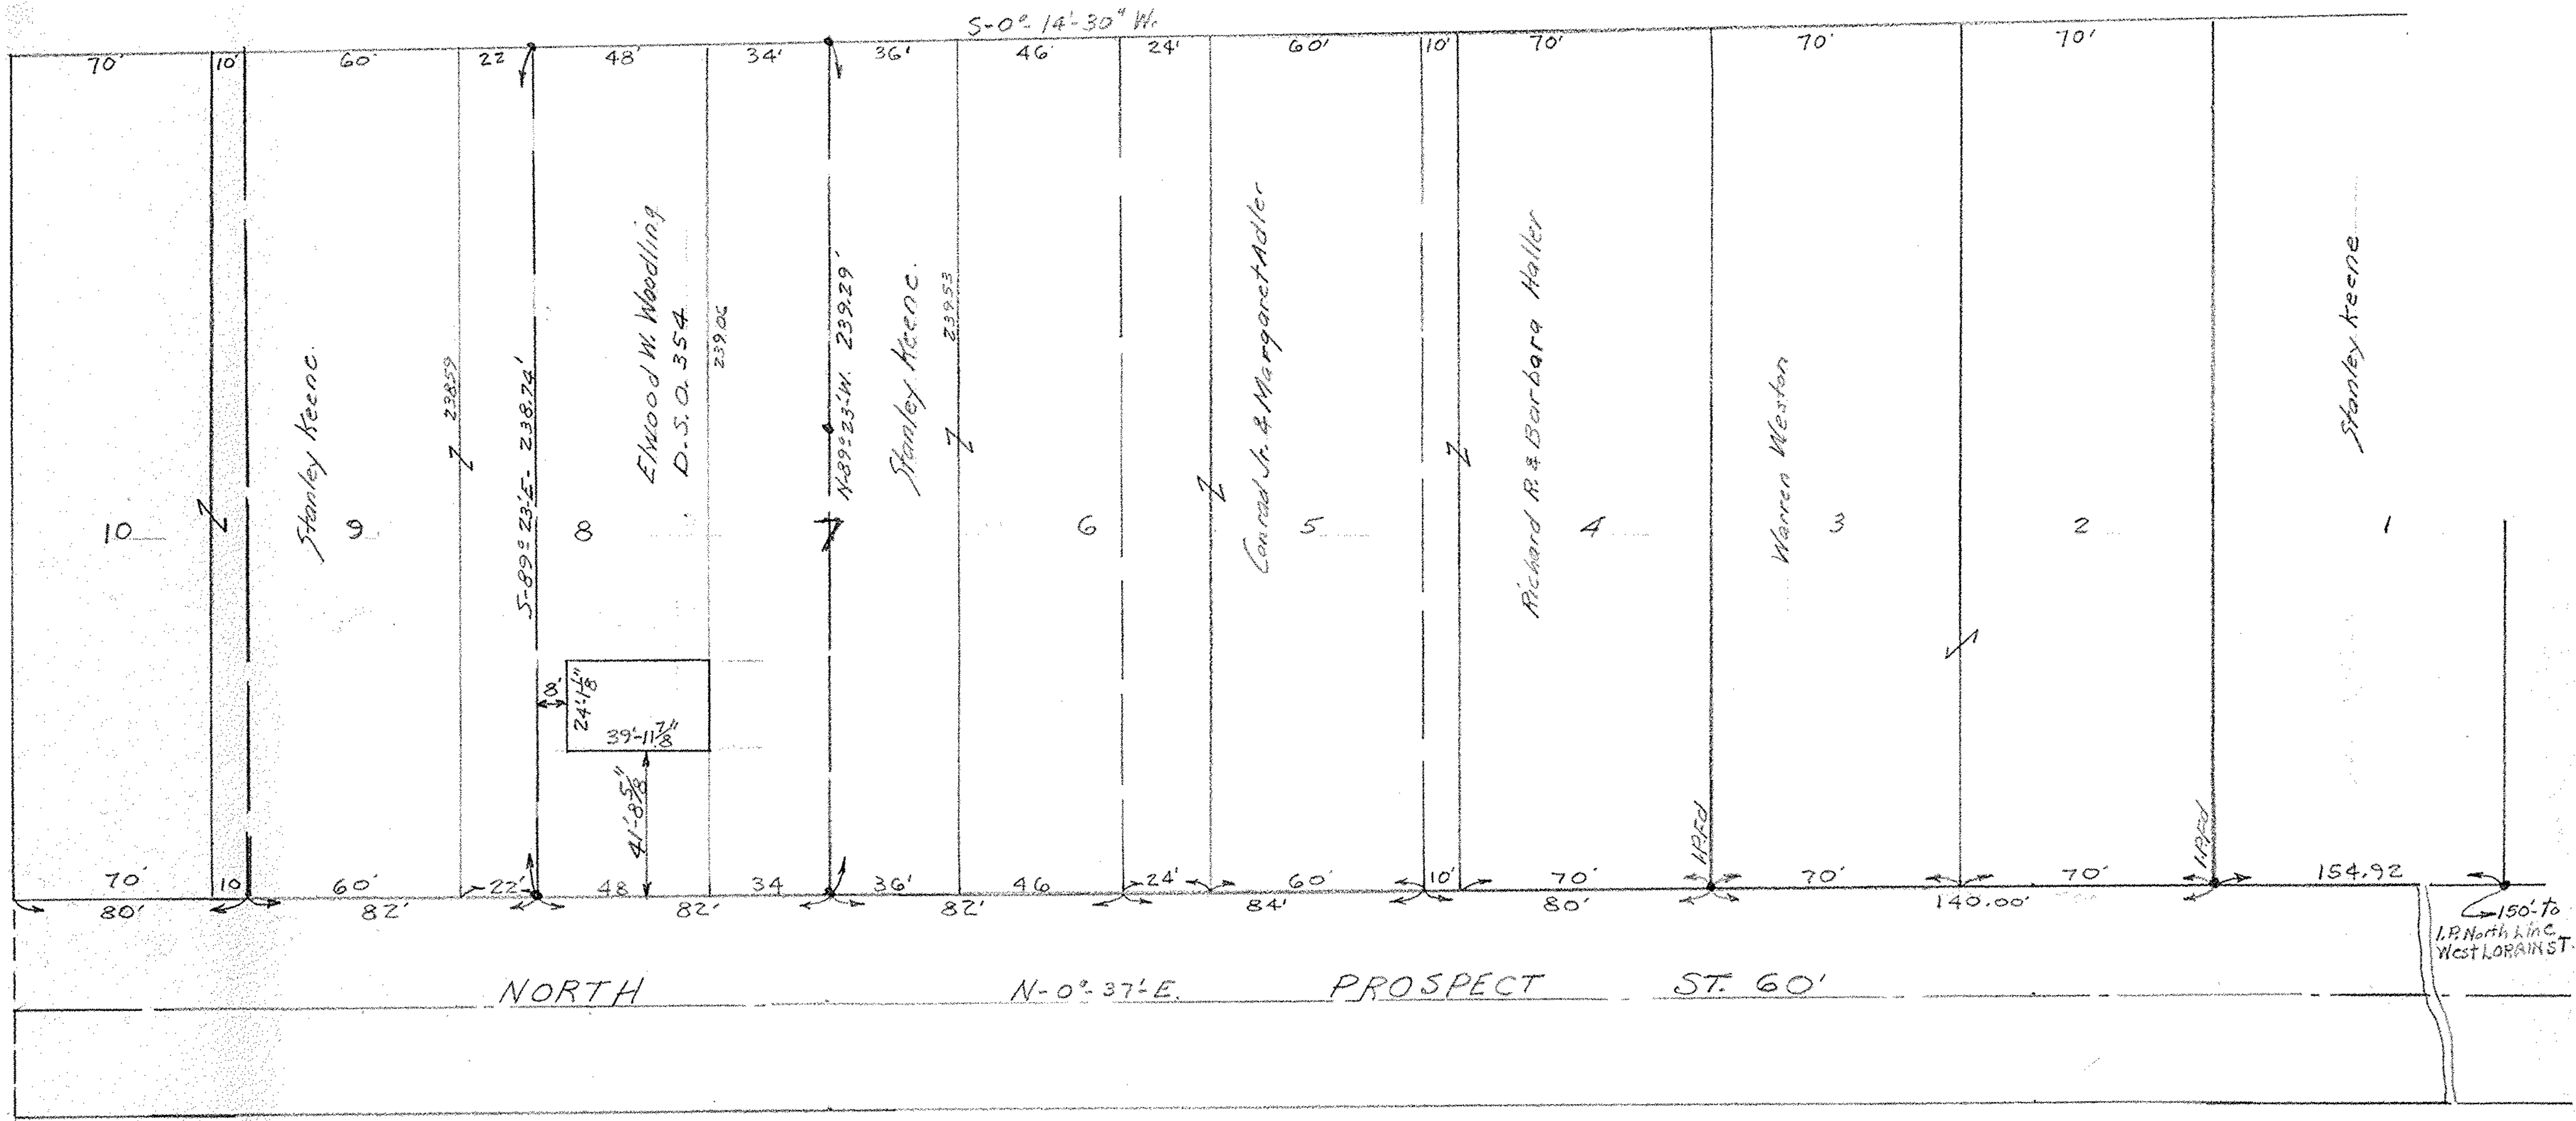

Indicates proposed Sub-Lot lines

Indicates establised property lines.

MAP OF SURVEY FOR
THE MEISTER CO. & ELWOOD W. WOODLING.
PART OF PROPOSED KEENE ADDITION
OBERLIN VILLAGE - LORAIN COUNTY OHIO
PART OF ORIGINAL RUSSIA TWP. LOTS 74-75
SCALE 1" = 40' MAY-18-1953
C.E. Penfound Registered Surveyor

09-00-074,075