PLAT OF SURVEY FOR
AUGUST & STELLA C. VIRAG
ORIG. LOTS 5, 6, 15, & 16 TRACT 12
HENRIETTA TWP. — LORAIN COUNTY — OHIO
SCALE: 1" = 100' MARCH 6, 1956
C.E. Penfound Registered Surveyor

NOTE: Iron pins found or set shown thus: ●

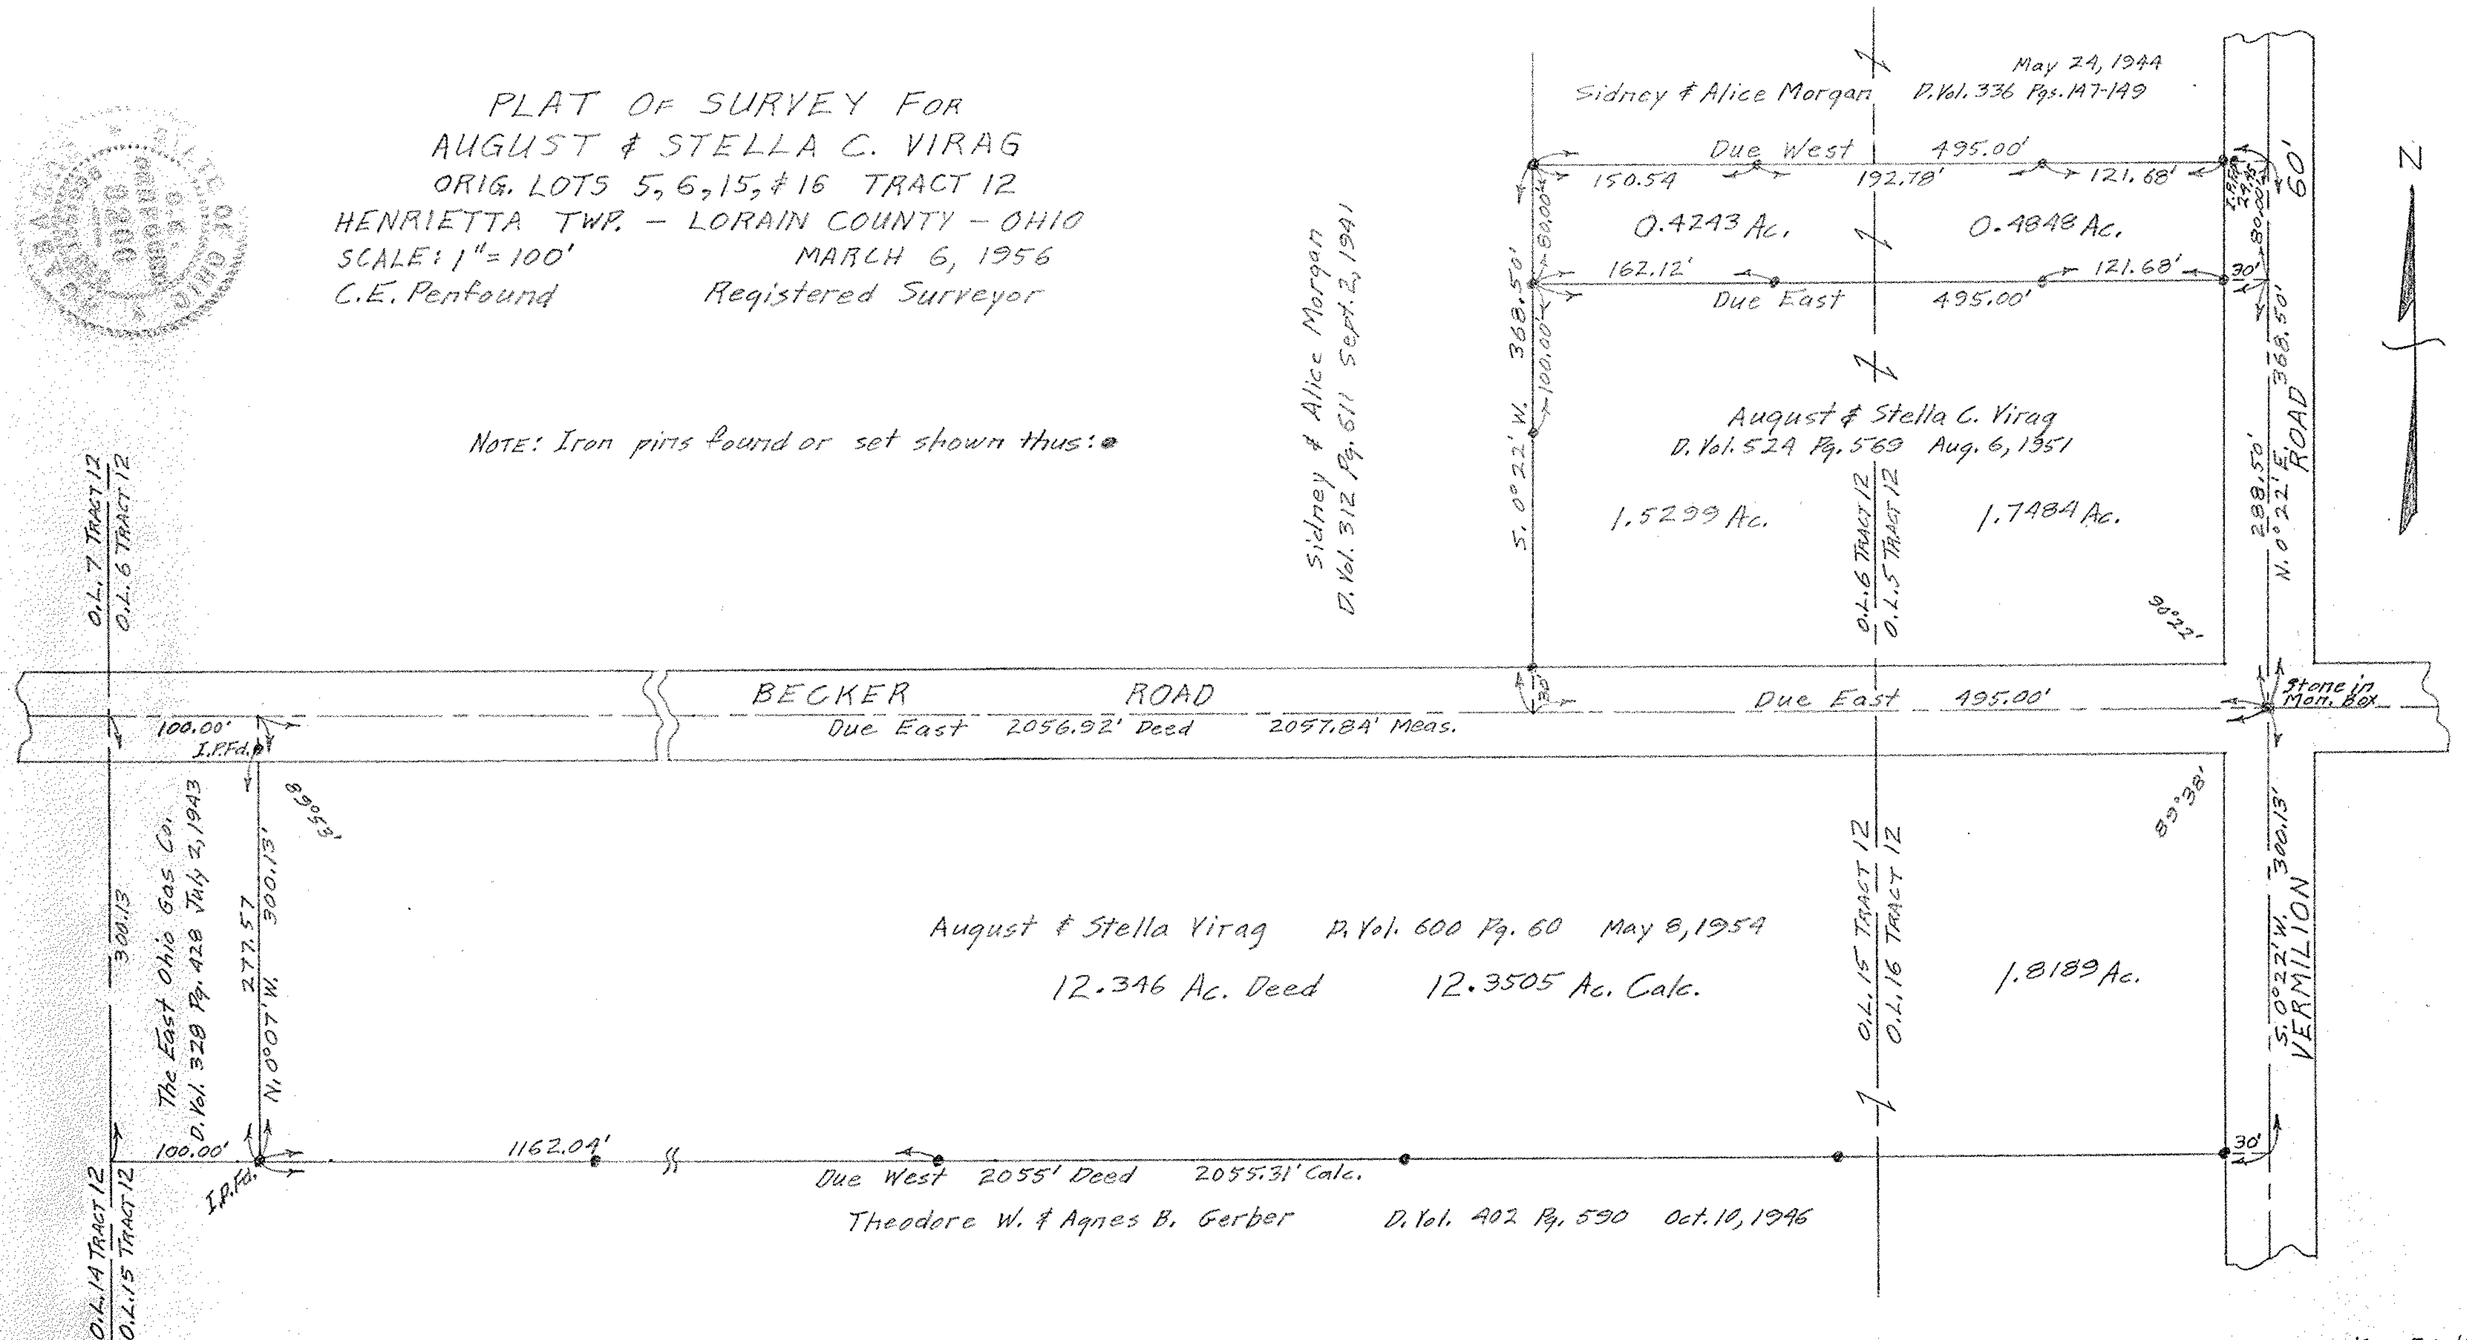

08-12-005, 6, 15, 16