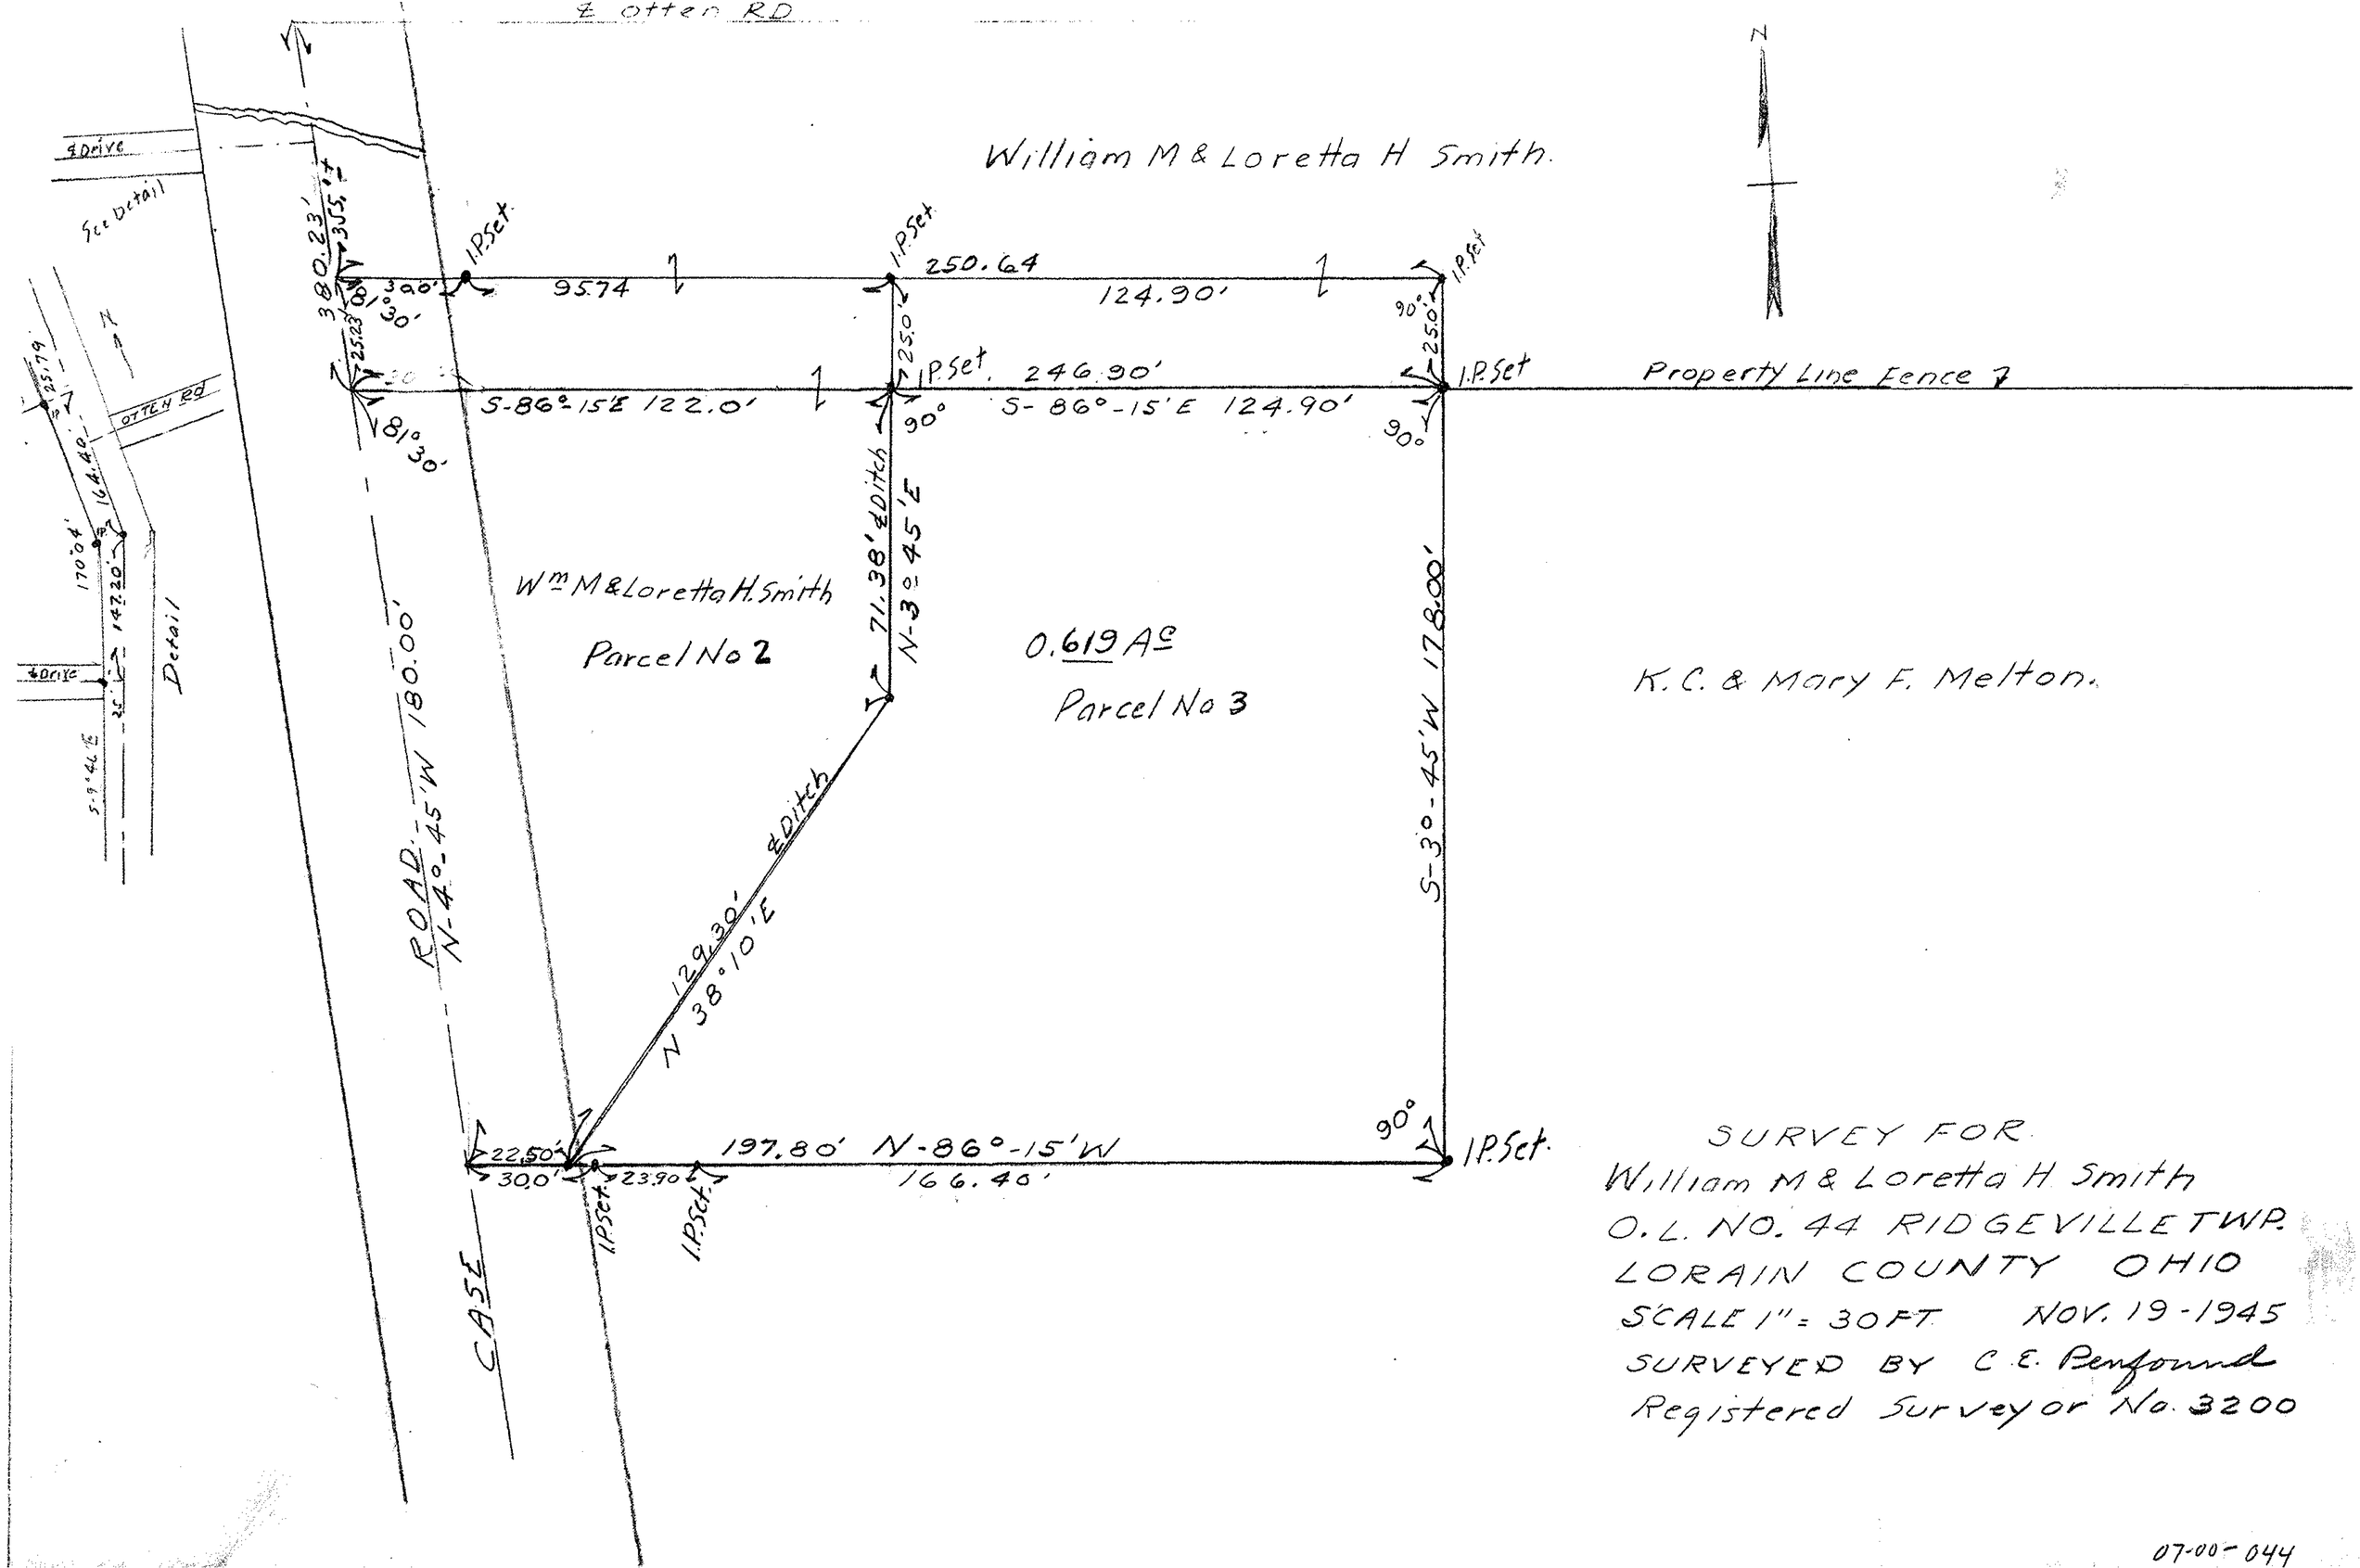

SURVEY FOR
William M & Loretta H Smith
O.L. NO. 44 RIDGEVILLE TWP.
LORAIN COUNTY OHIO
SCALE 1" = 30 FT NOV. 19-1945
SURVEYED BY C. E. Penfound
Registered Surveyor No. 3200

07-00-044