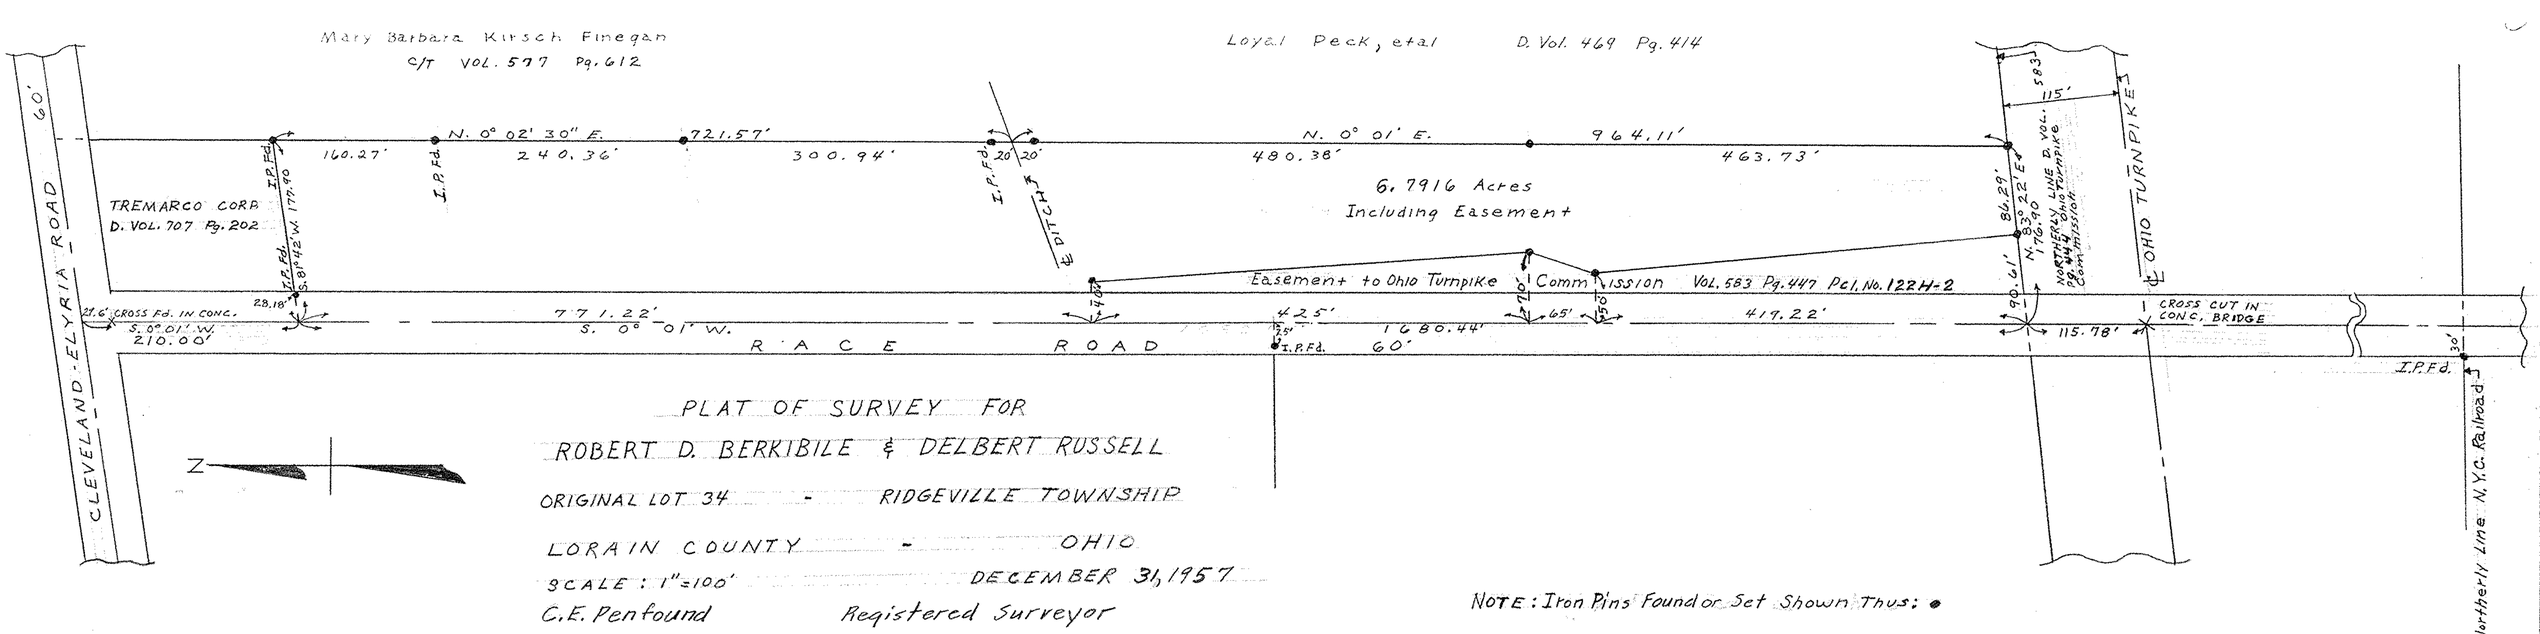

PLAT OF SURVEY FOR

ROBERT D. BERKIBILE & DELBERT RUSSELL

ORIGINAL LOT 34 - RIDGEVILLE TOWNSHIP

LORAIN COUNTY - OHIO

SCALE: 1"=100' DECEMBER 31, 1957

C.E. Penfound Registered Surveyor