PLAT OF SURVEY FOR TADEUSZ WOJDASZ
AND FOR 29603 LORAIN, Inc. (SIMMONS HOMES)

ORIGINAL LOT NO. 27 – EATON TOWNSHIP
LORAIN COUNTY OHIO
SCALE: 1" = 100' APRIL – 1978
Gary E. Penfound Reg. Surveyor No. 4457

REVISED MAY 27-1978 FOR LOTS NOS. 1 AND 2

USED
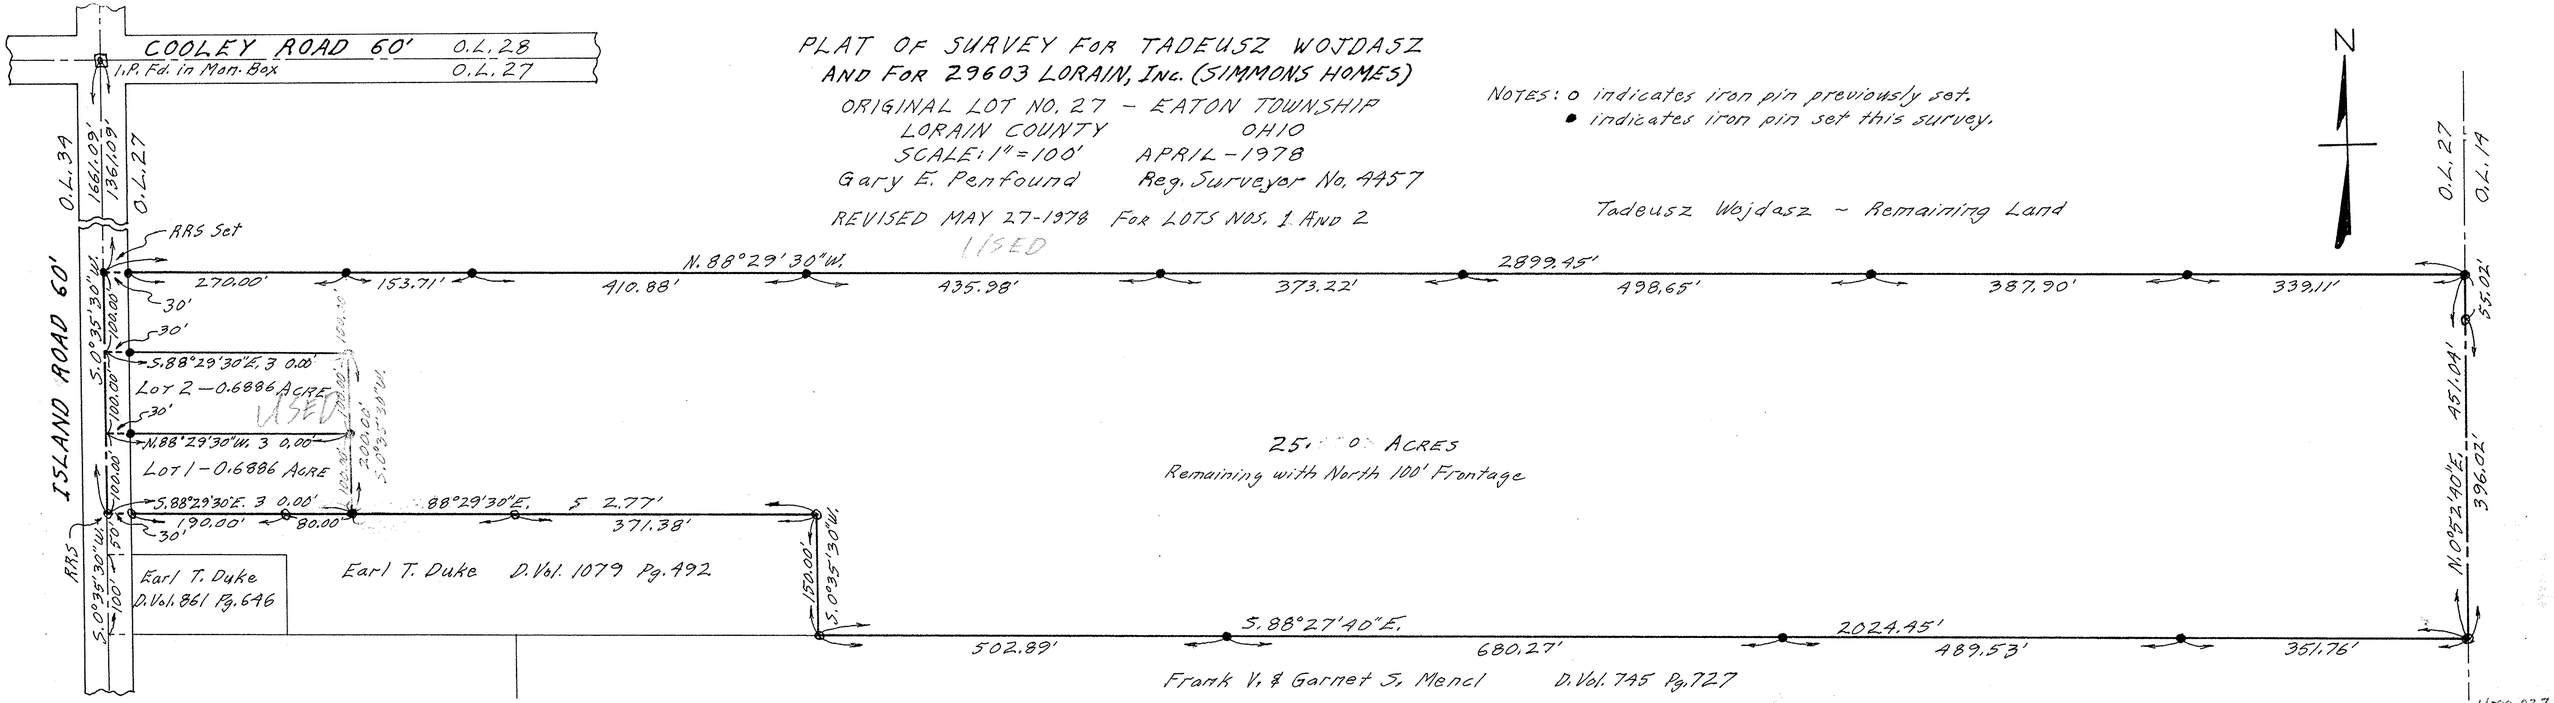
NOTES: o indicates iron pin previously set.
• indicates iron pin set this survey.