PLAT OF SURVEYS FOR
MIDLAND TITLE SECURITY, INC.
DIVISION OF PROPERTY OF
RAYMOND M. BENEDICT

ORIGINAL LOT NO. 72 EATON TWP.
LORAIN COUNTY OHIO
SCALE: 1" = 60' JUNE & SEPTEMBER 1972
Gary E. Penfound Reg. Surveyor No. 4457

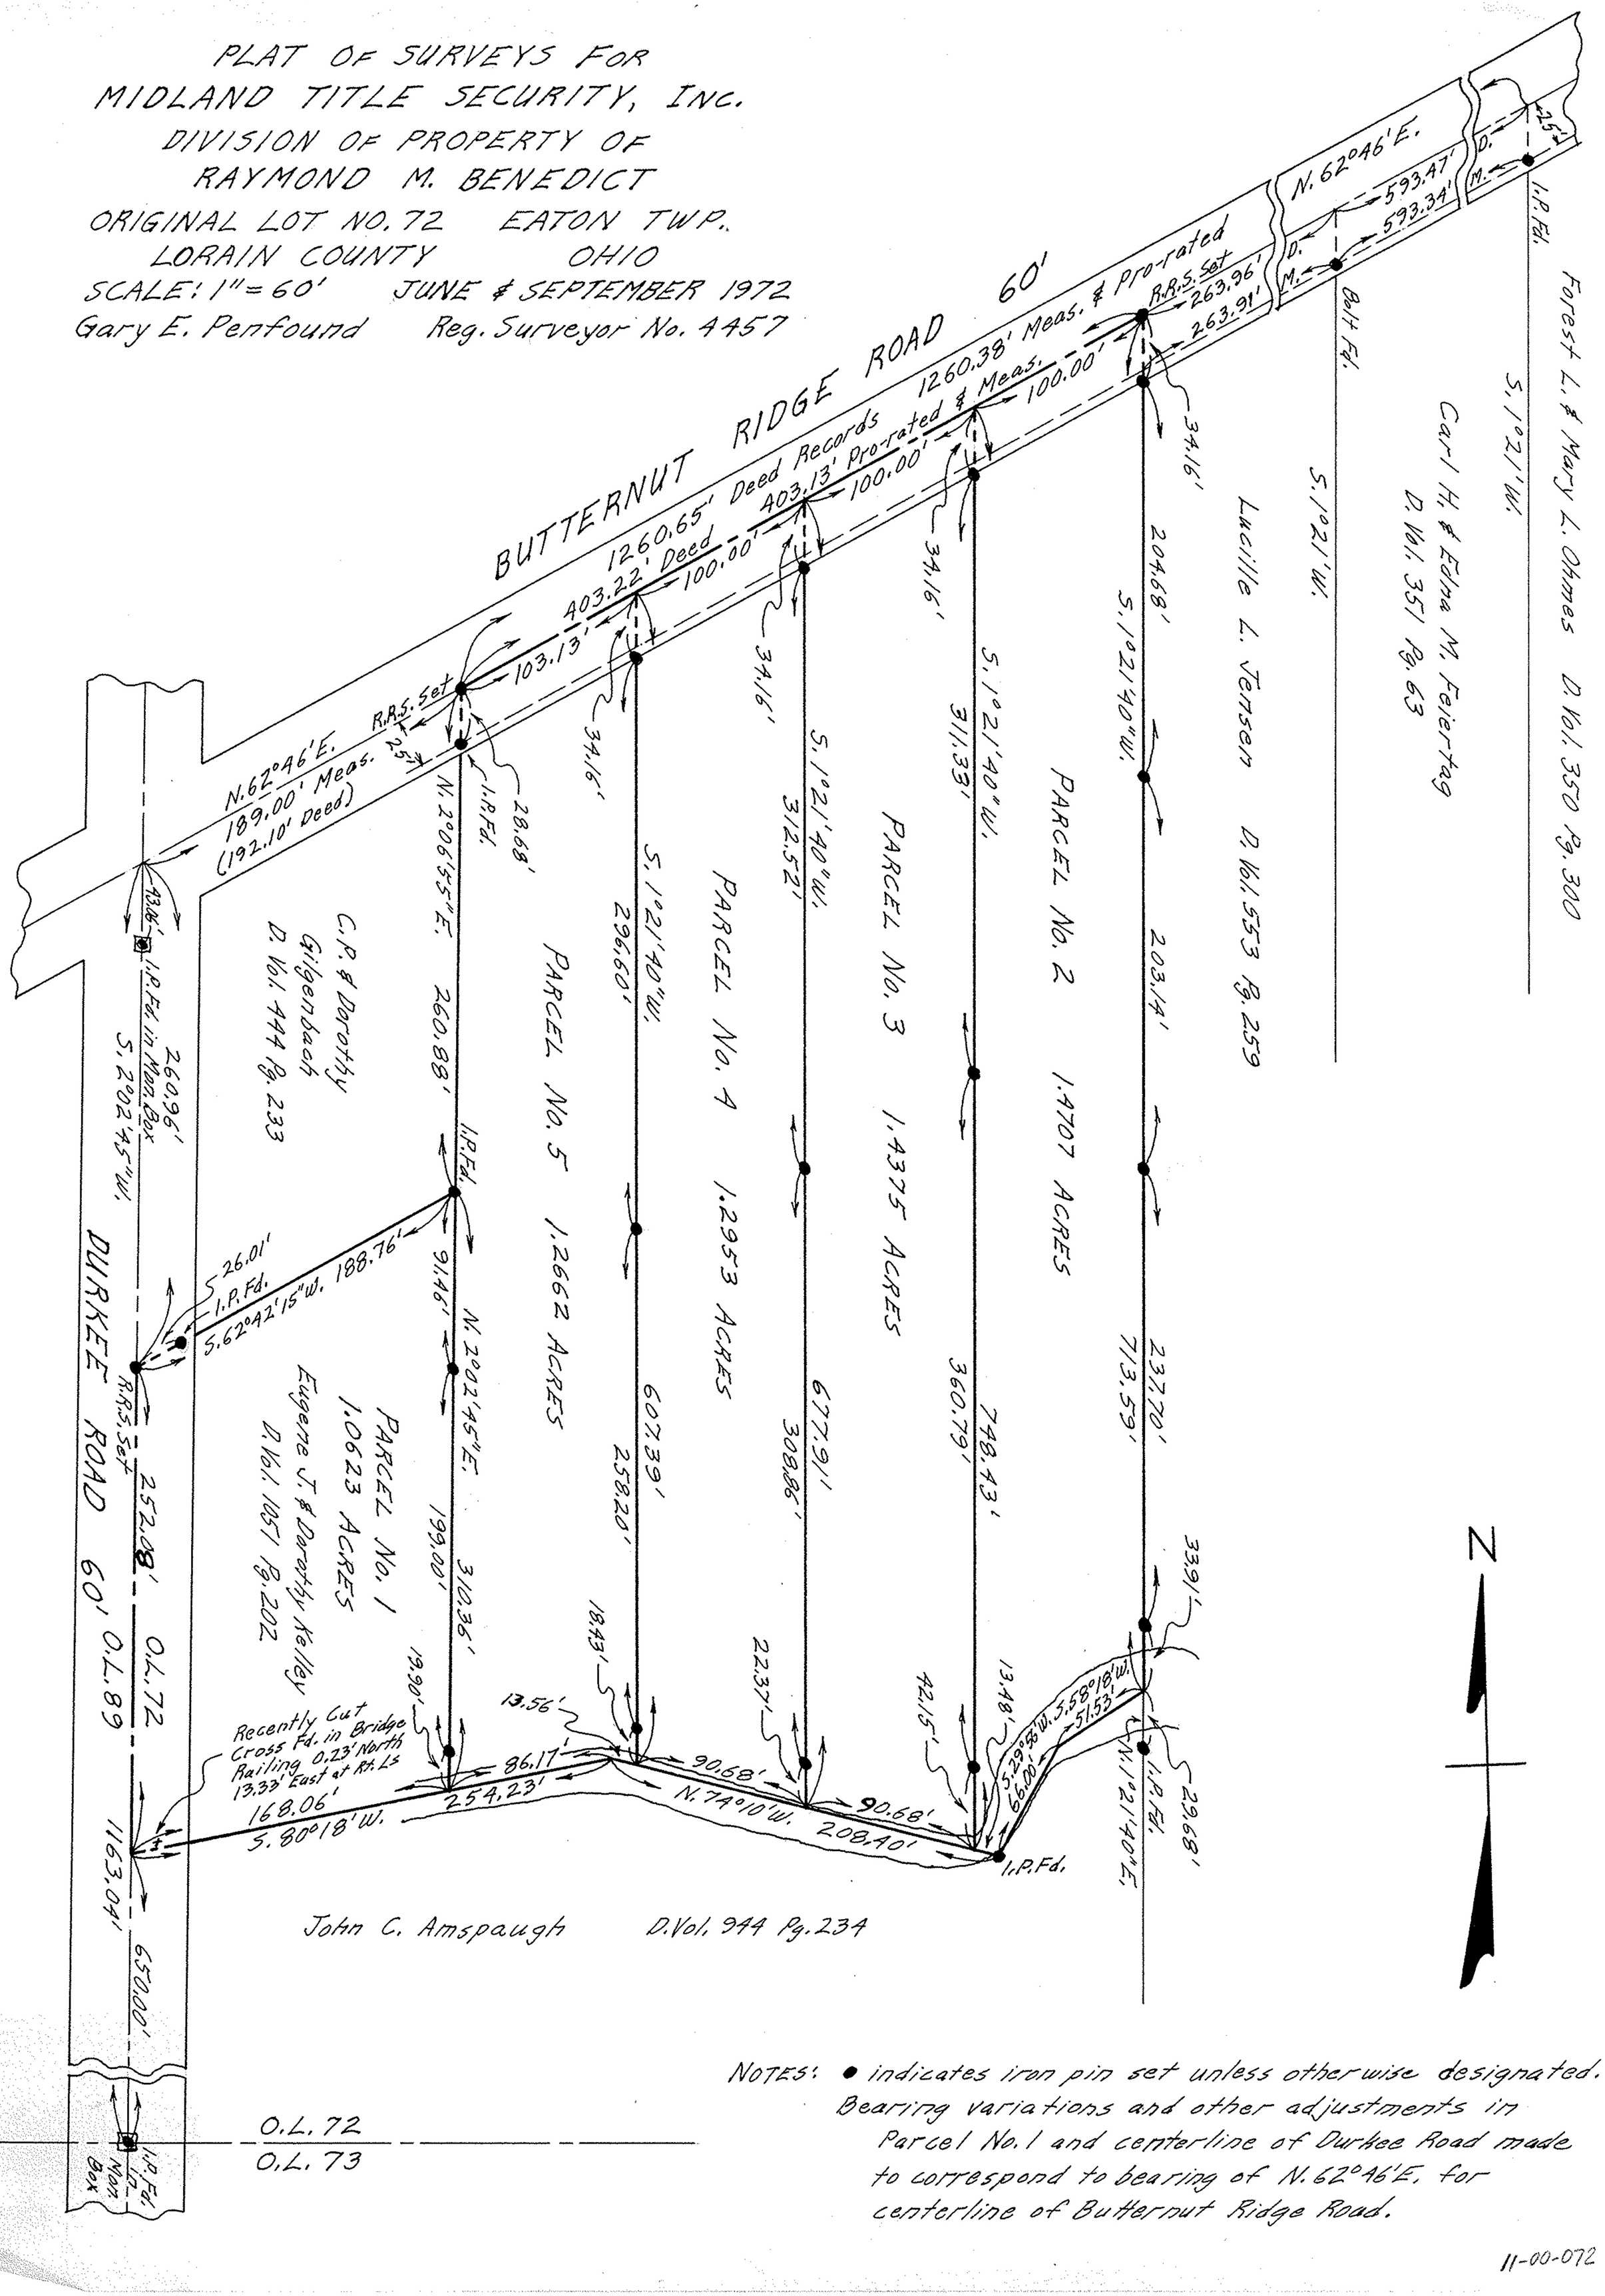

NOTES: • indicates iron pin set unless otherwise designated.
Bearing variations and other adjustments in Parcel No. 1 and centerline of Durkee Road made to correspond to bearing of N. 62°46'E. for centerline of Buttermut Ridge Road.

11-00-072