PLAT OF SURVEYS FOR
RICHARD C. & JANET V. OHMES

ORIGINAL LOT 72 EATON TOWNSHIP
LORAIN COUNTY OHIO
SCALE: 1" = 60' JUNE 1972
Gary E. Penfound Reg. Surveyor No. 4457

NOTES: ○ indicates iron pin found.
● indicates iron pin set
unless otherwise designated.

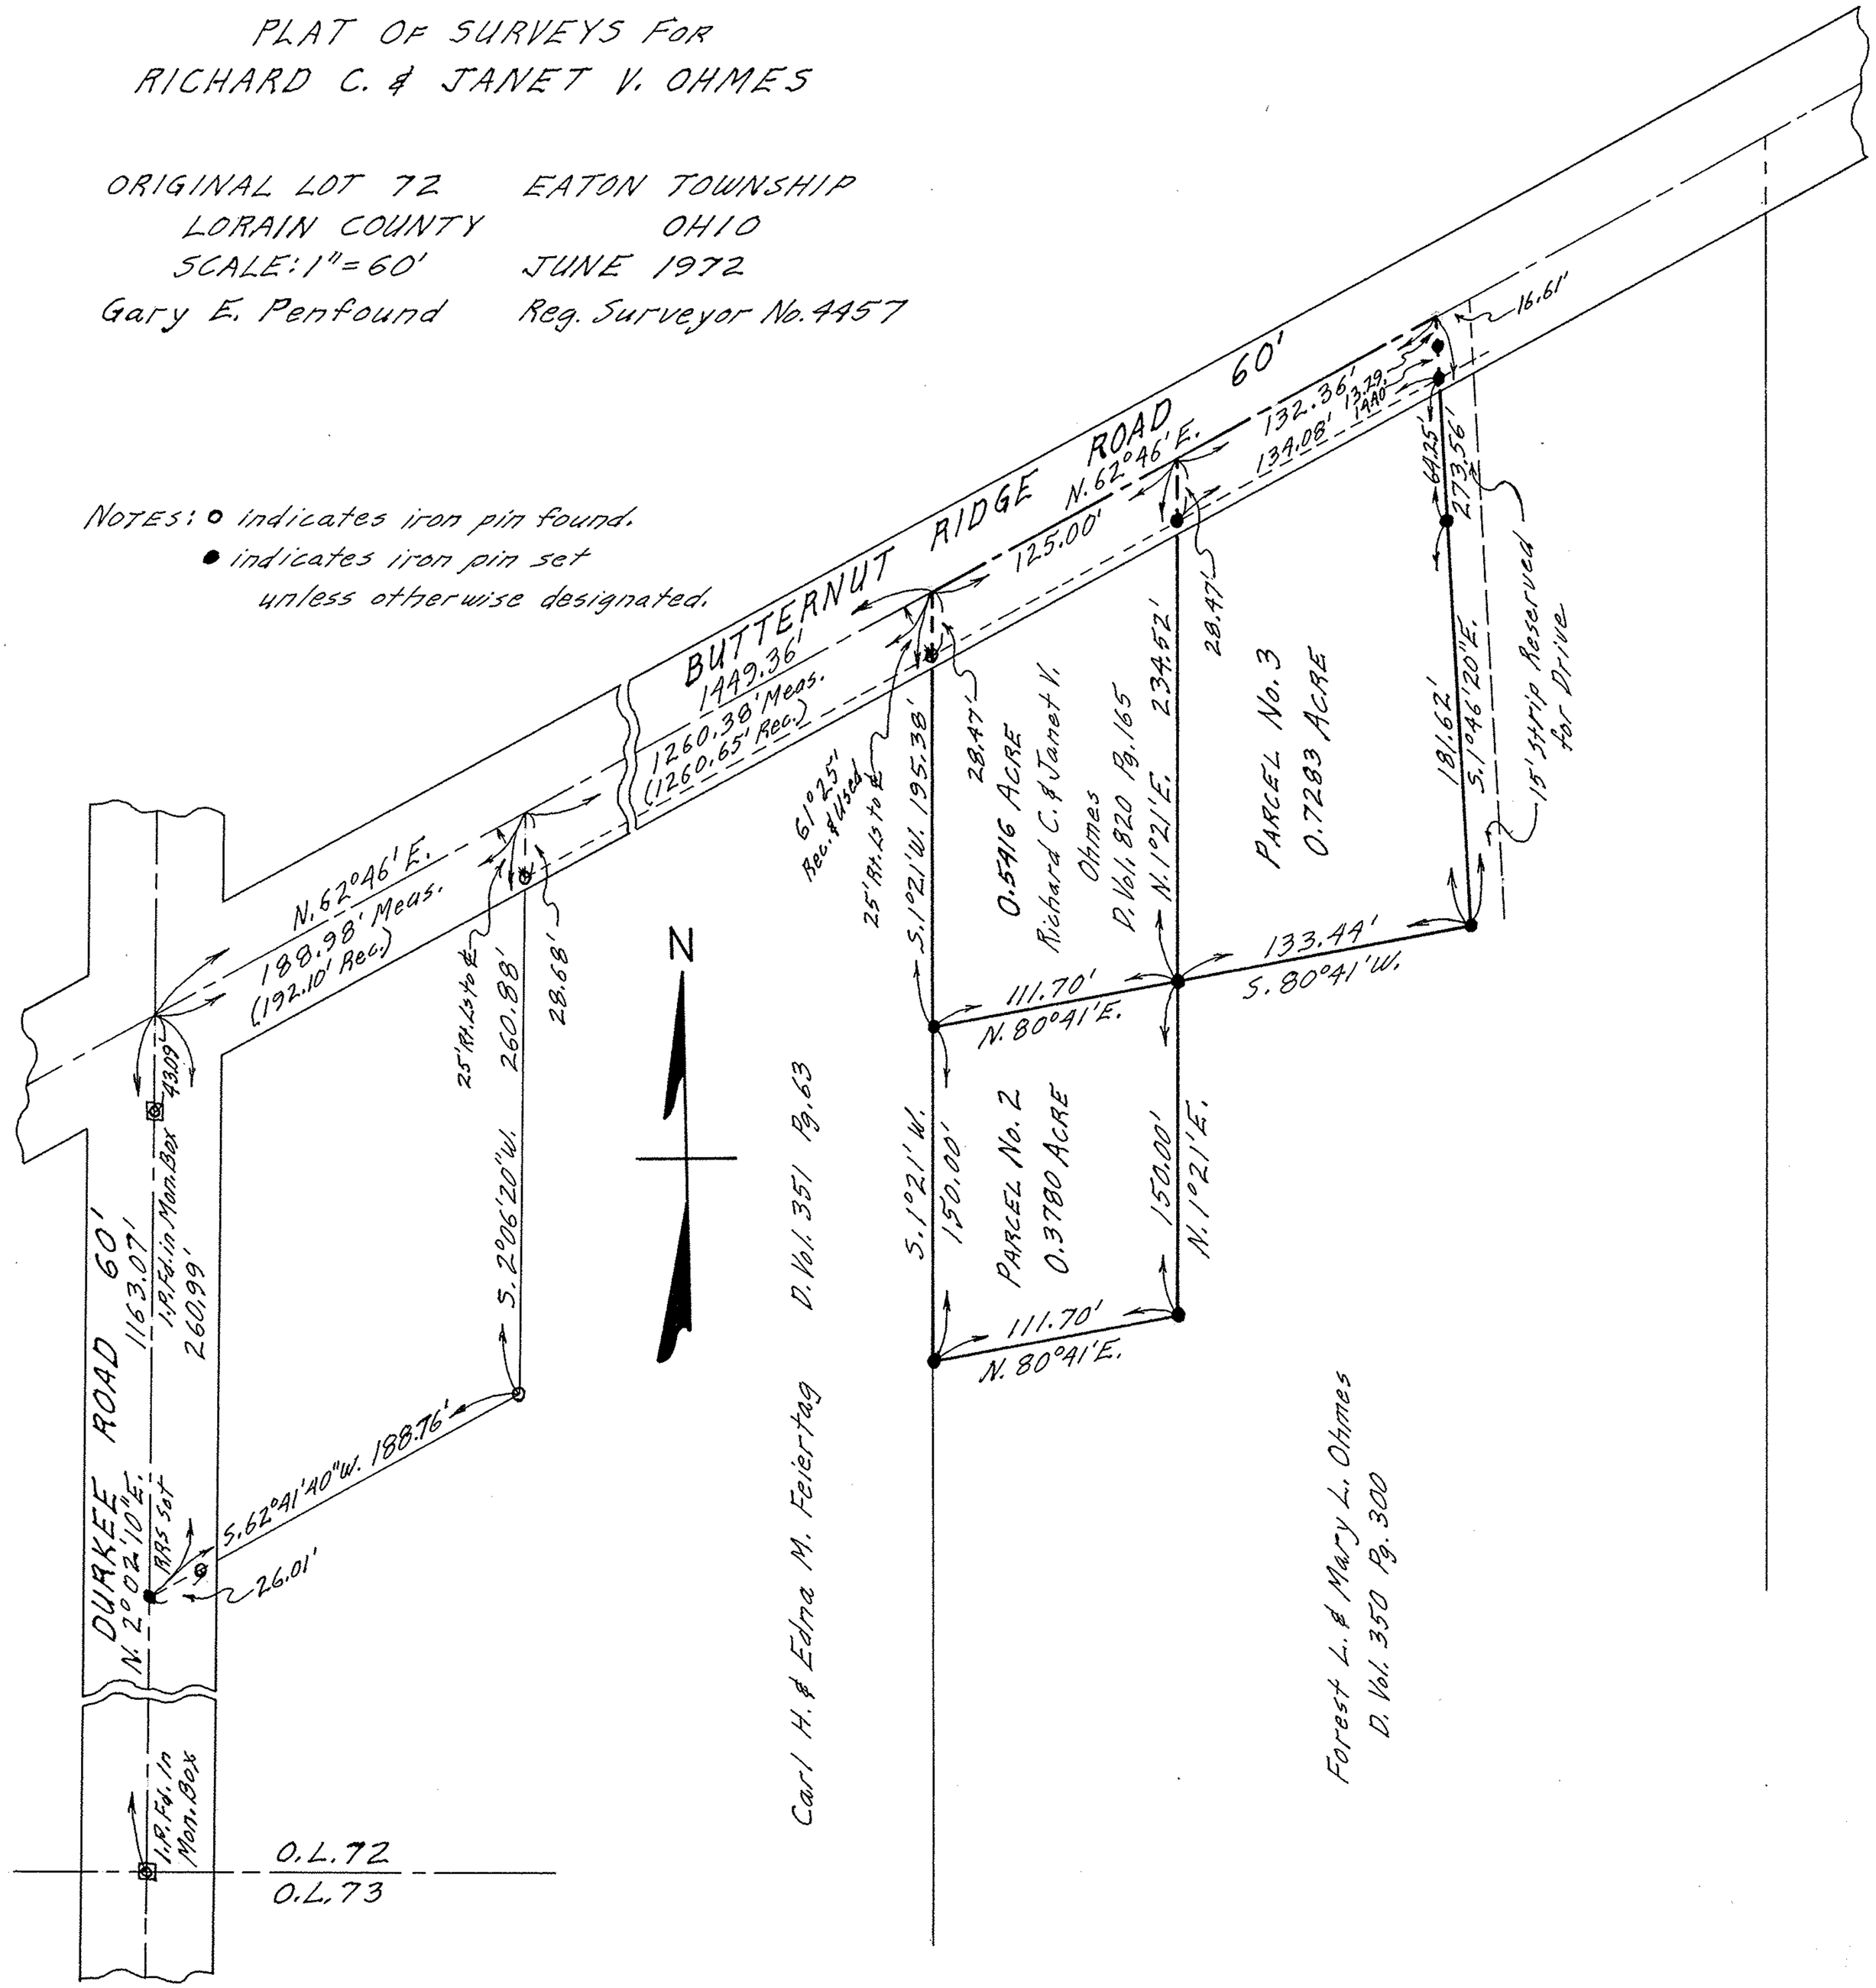

11-00-072