PLAT OF SURVEYS FOR
WALTER G. CASPER
AND MRS. MARY CASPER

ORIGINAL LOT NO. 13 COLUMBIA TOWNSHIP
LORAIN COUNTY OHIO
SCALE: 1" = 100' OCTOBER - 1979
Gary E. Penfound Reg. Surveyor No. 4457
SURVEY MARKERS FOR PARCELS NOS. 1 THRU 7
~~SET DECEMBER 1979 AND JANUARY 1980~~

NOTES: ● indicates iron pin set on this or previous surveying.
o indicates railroad spike set in pavement.

All iron pins and railroad spikes set as shown Apr. 29 - May 1, 1980.

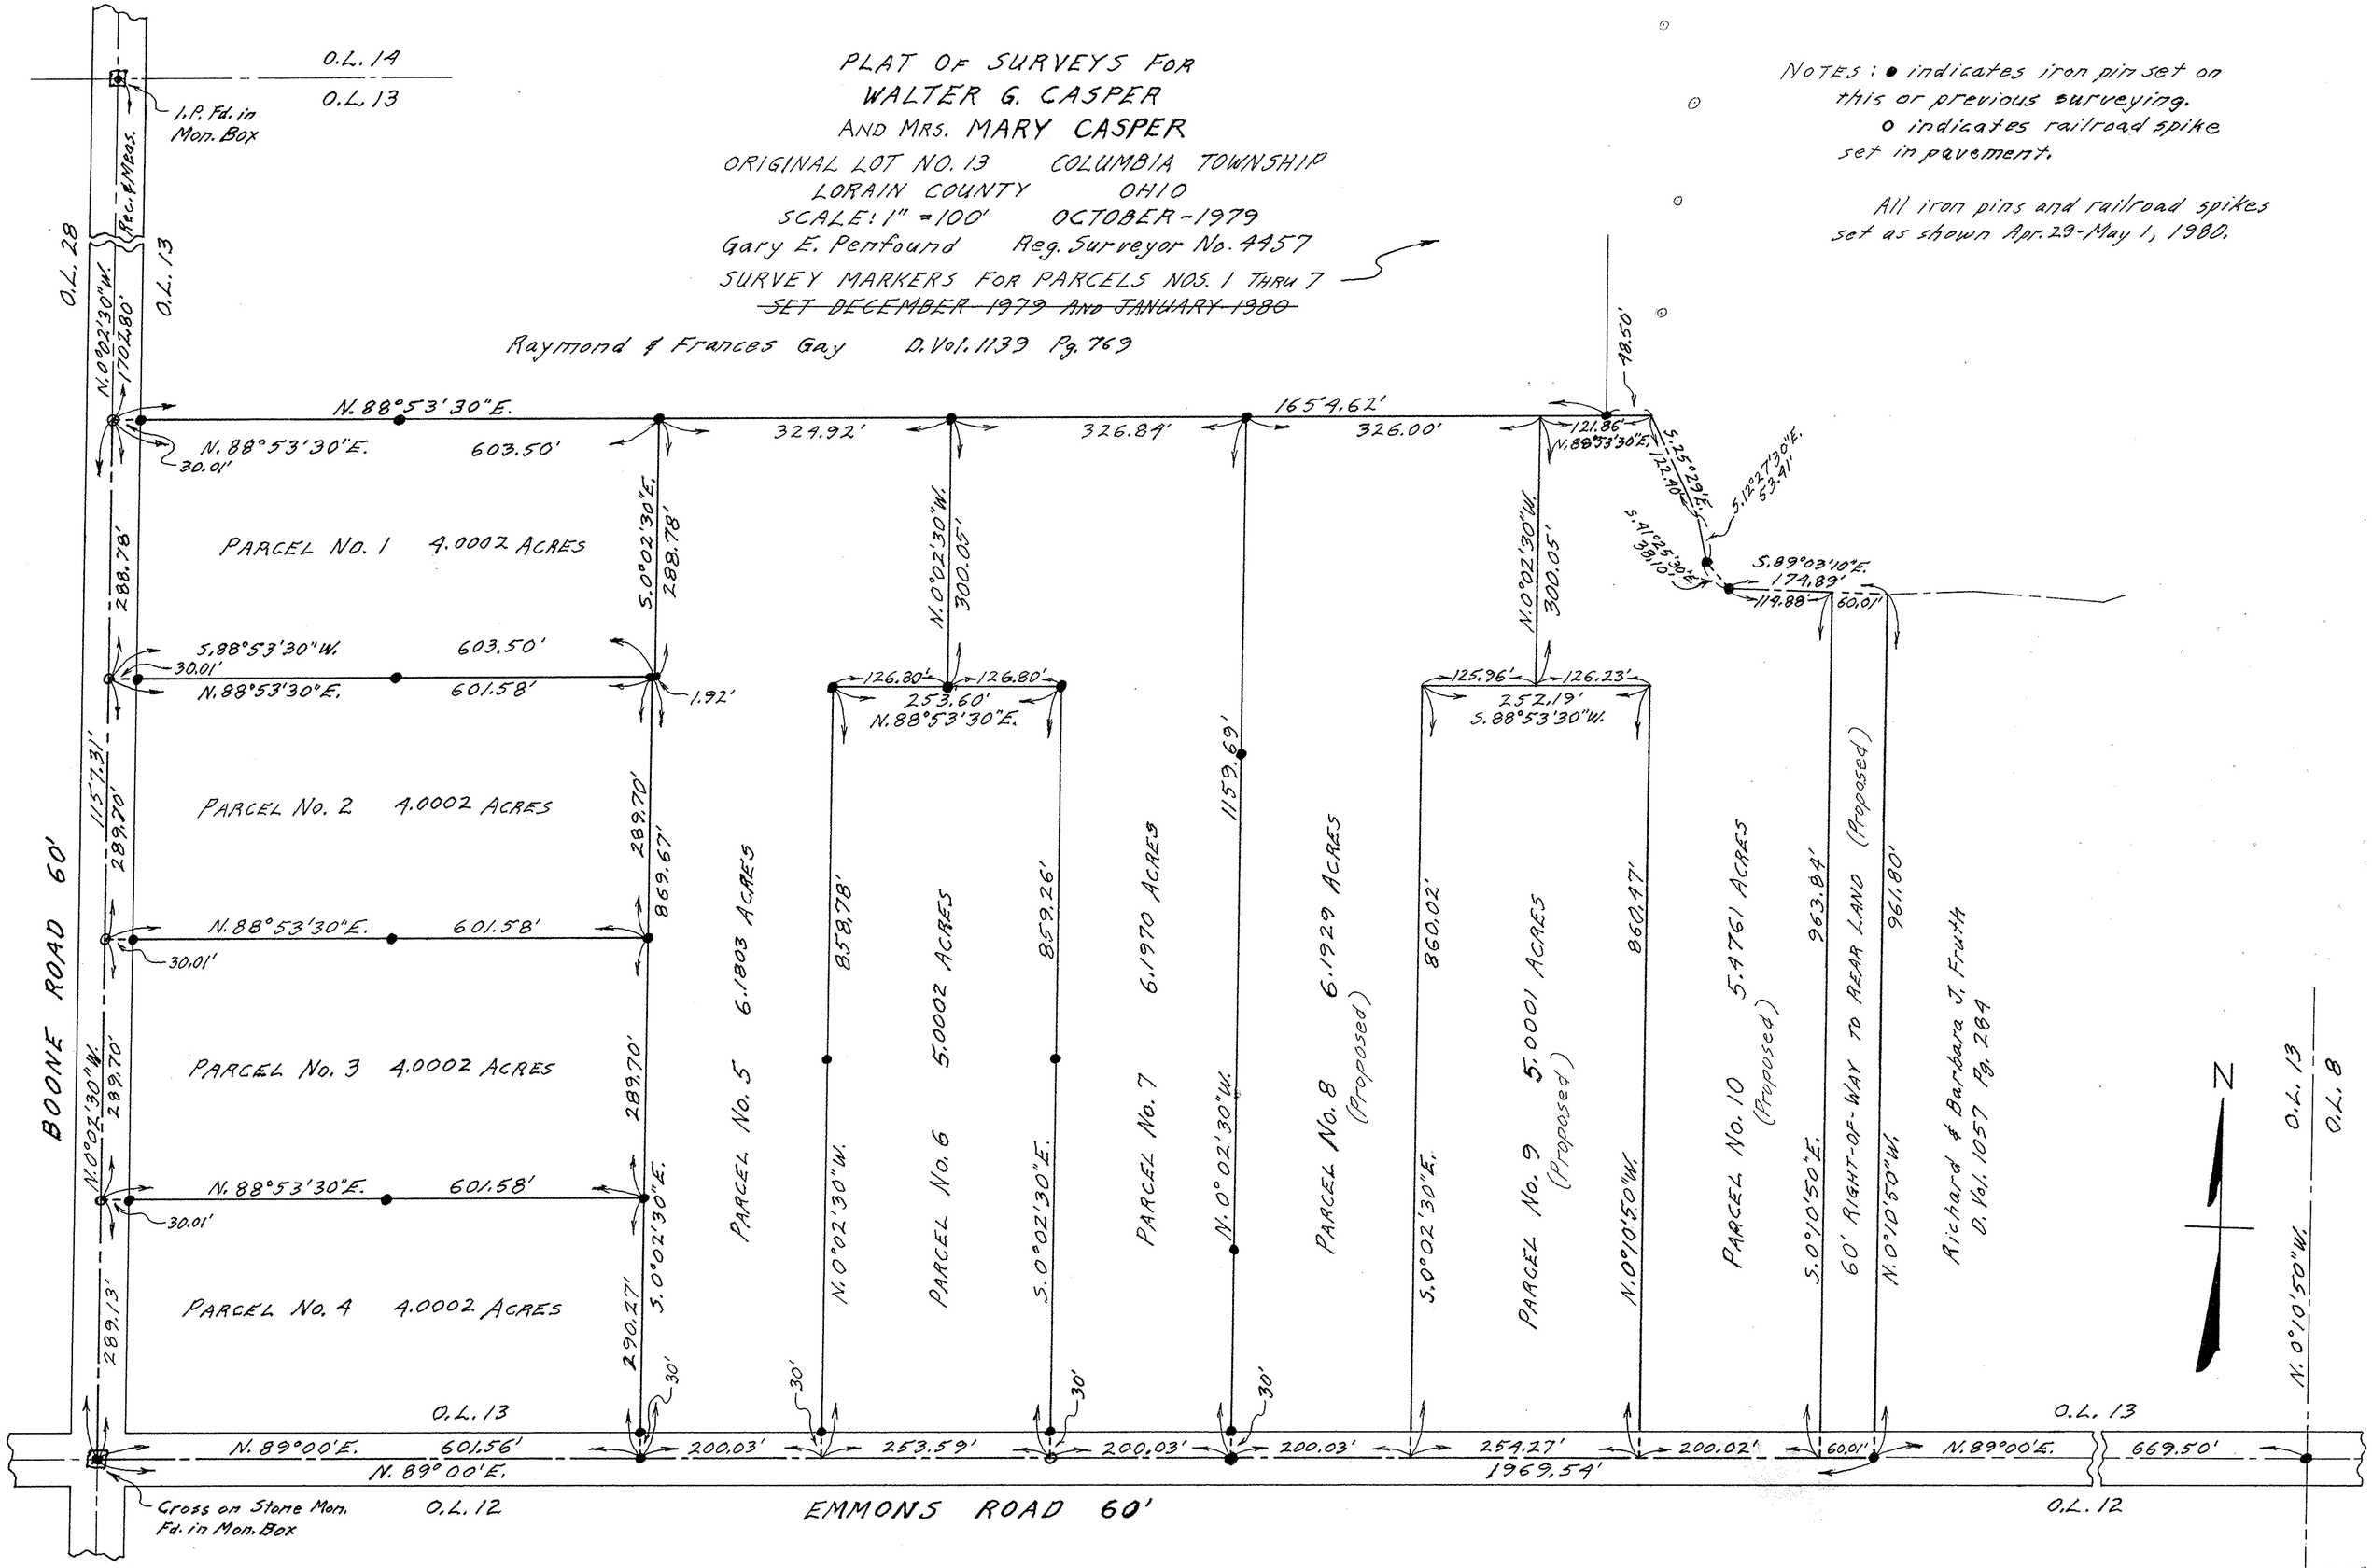

12-00-013