


NOTES: ○ indicates iron pin found.
 ● indicates iron pin set
 unless otherwise designated.

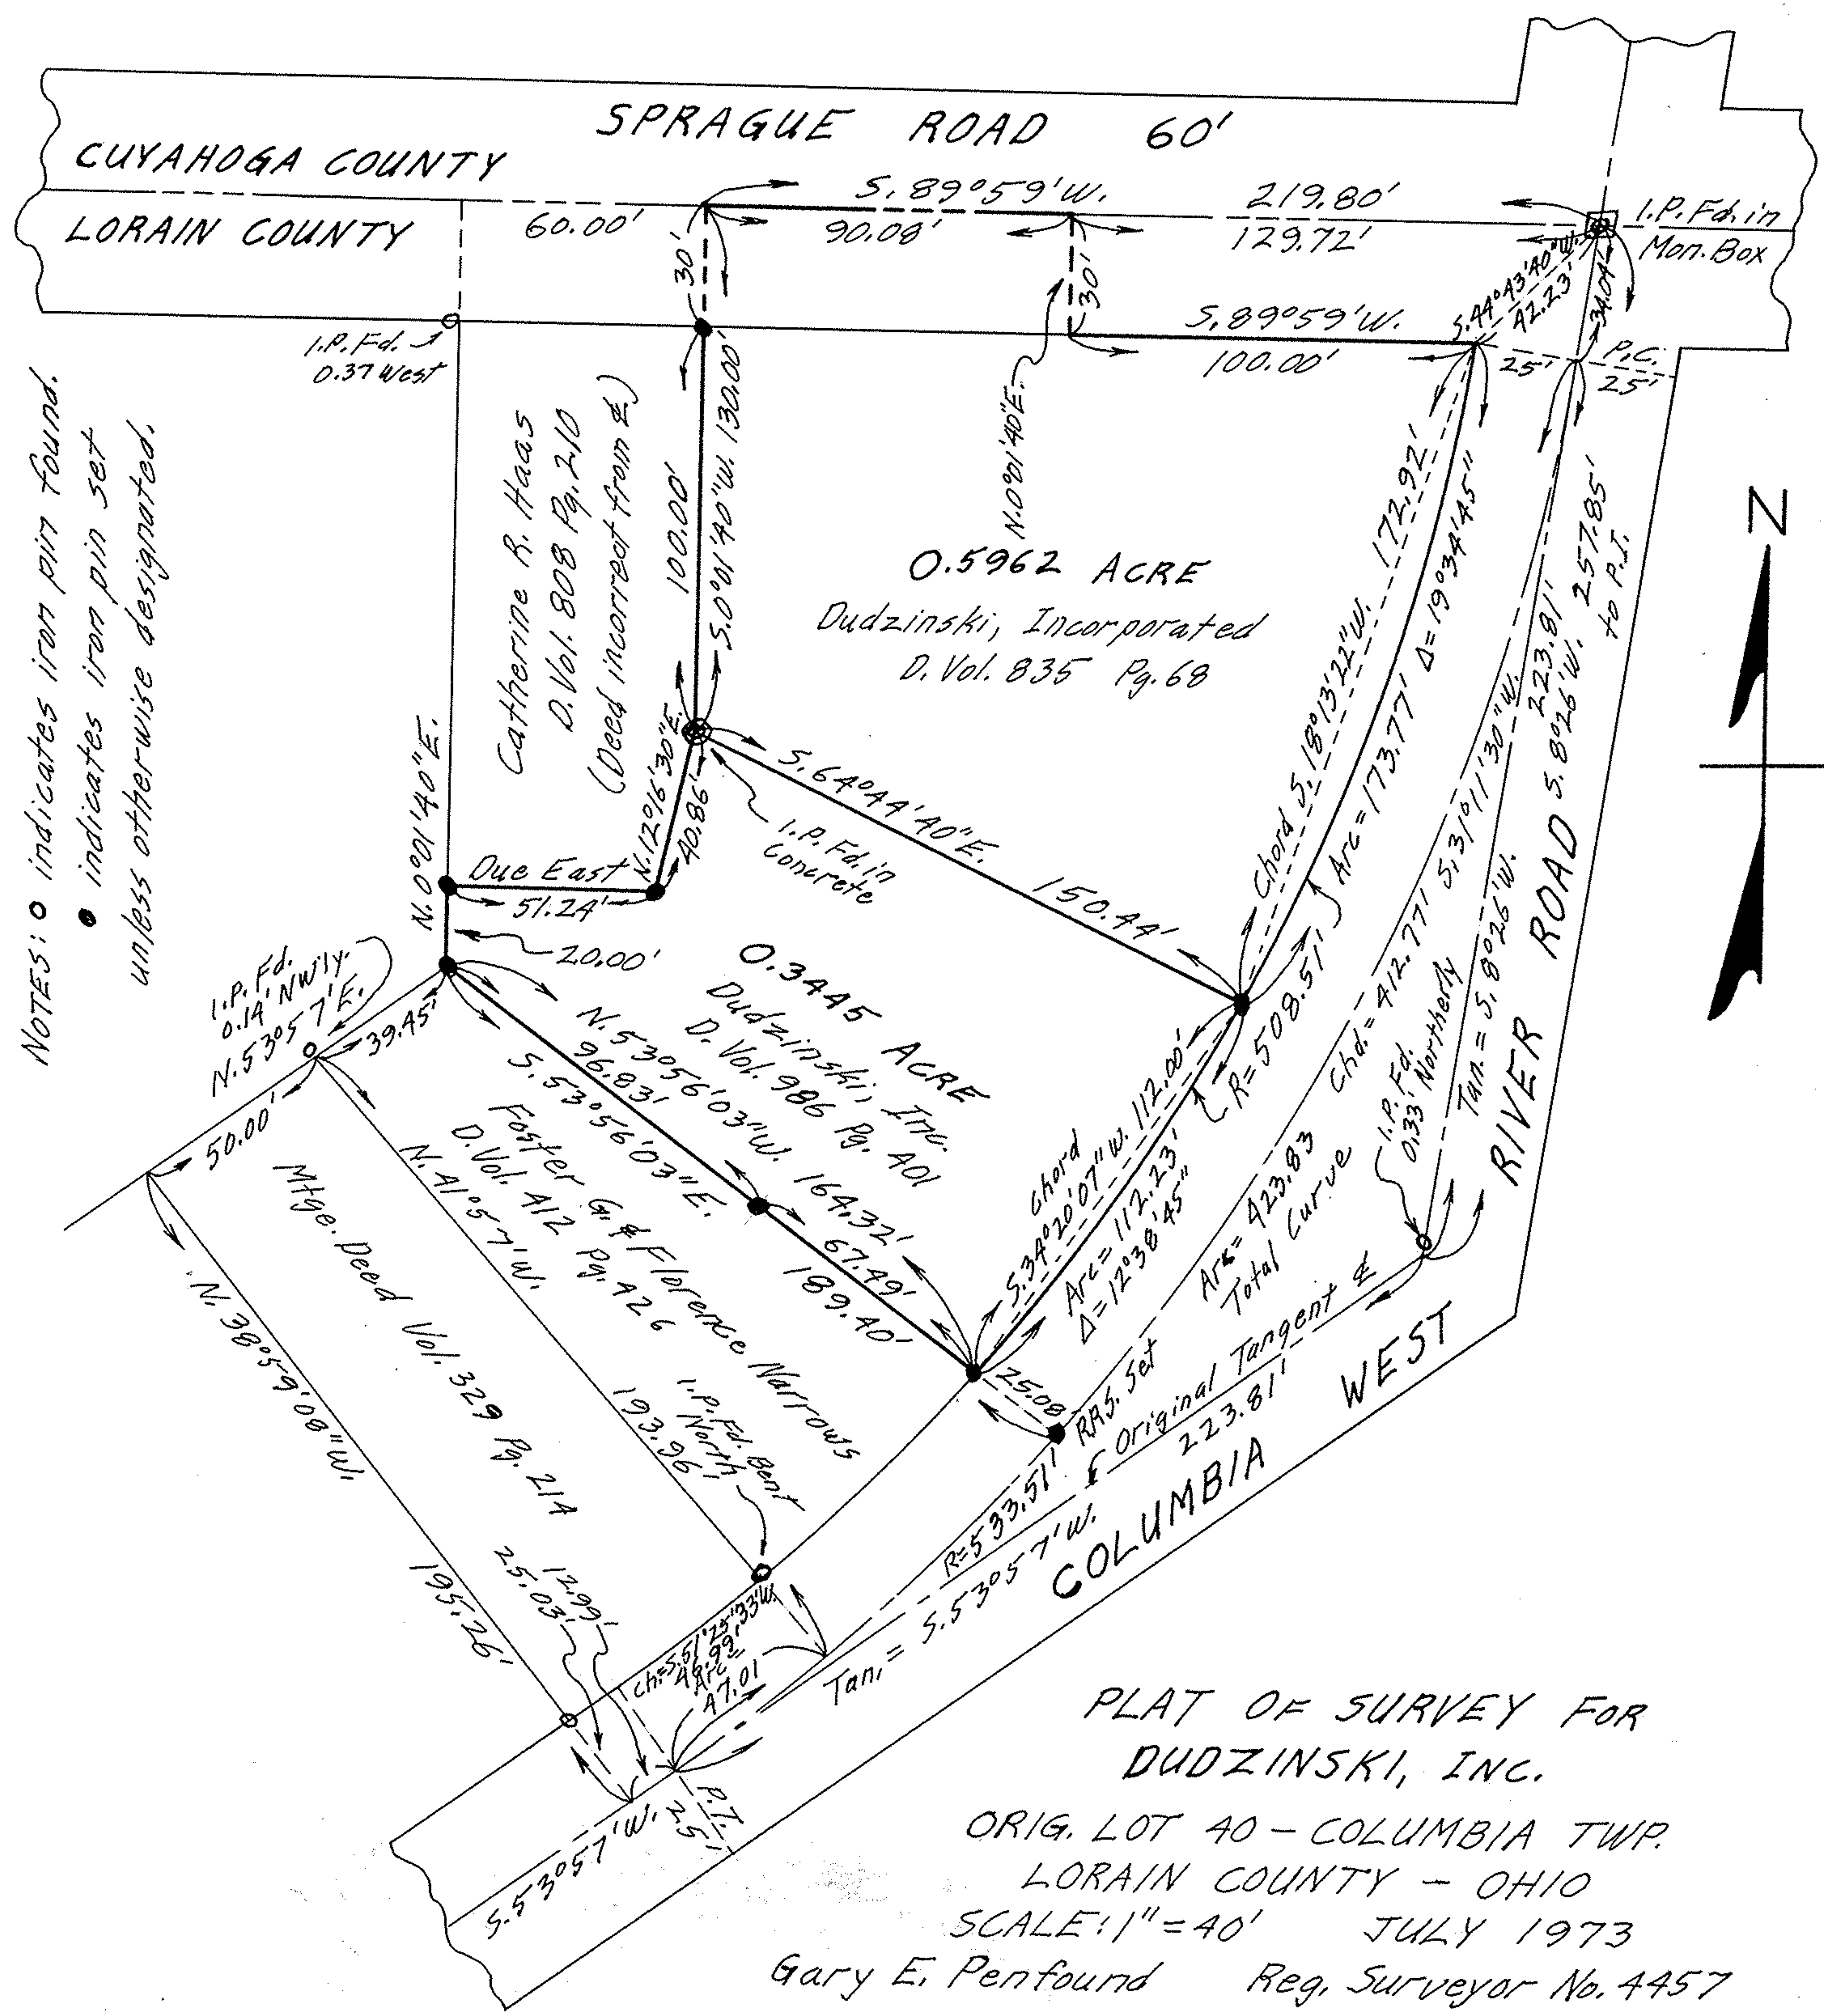

0.5962 ACRE
 Dudzinski, Incorporated
 D. Vol. 835 Pg. 68

0.3445 ACRE
 Dudzinski, Inc.
 D. Vol. 986 Pg. 401

COLUMBIA WEST

PLAT OF SURVEY FOR
 DUDZINSKI, INC.
 ORIG. LOT 40 - COLUMBIA TWP.
 LORAIN COUNTY - OHIO
 SCALE: 1" = 40' JULY 1973
 Gary E. Penfound Reg. Surveyor No. 4457