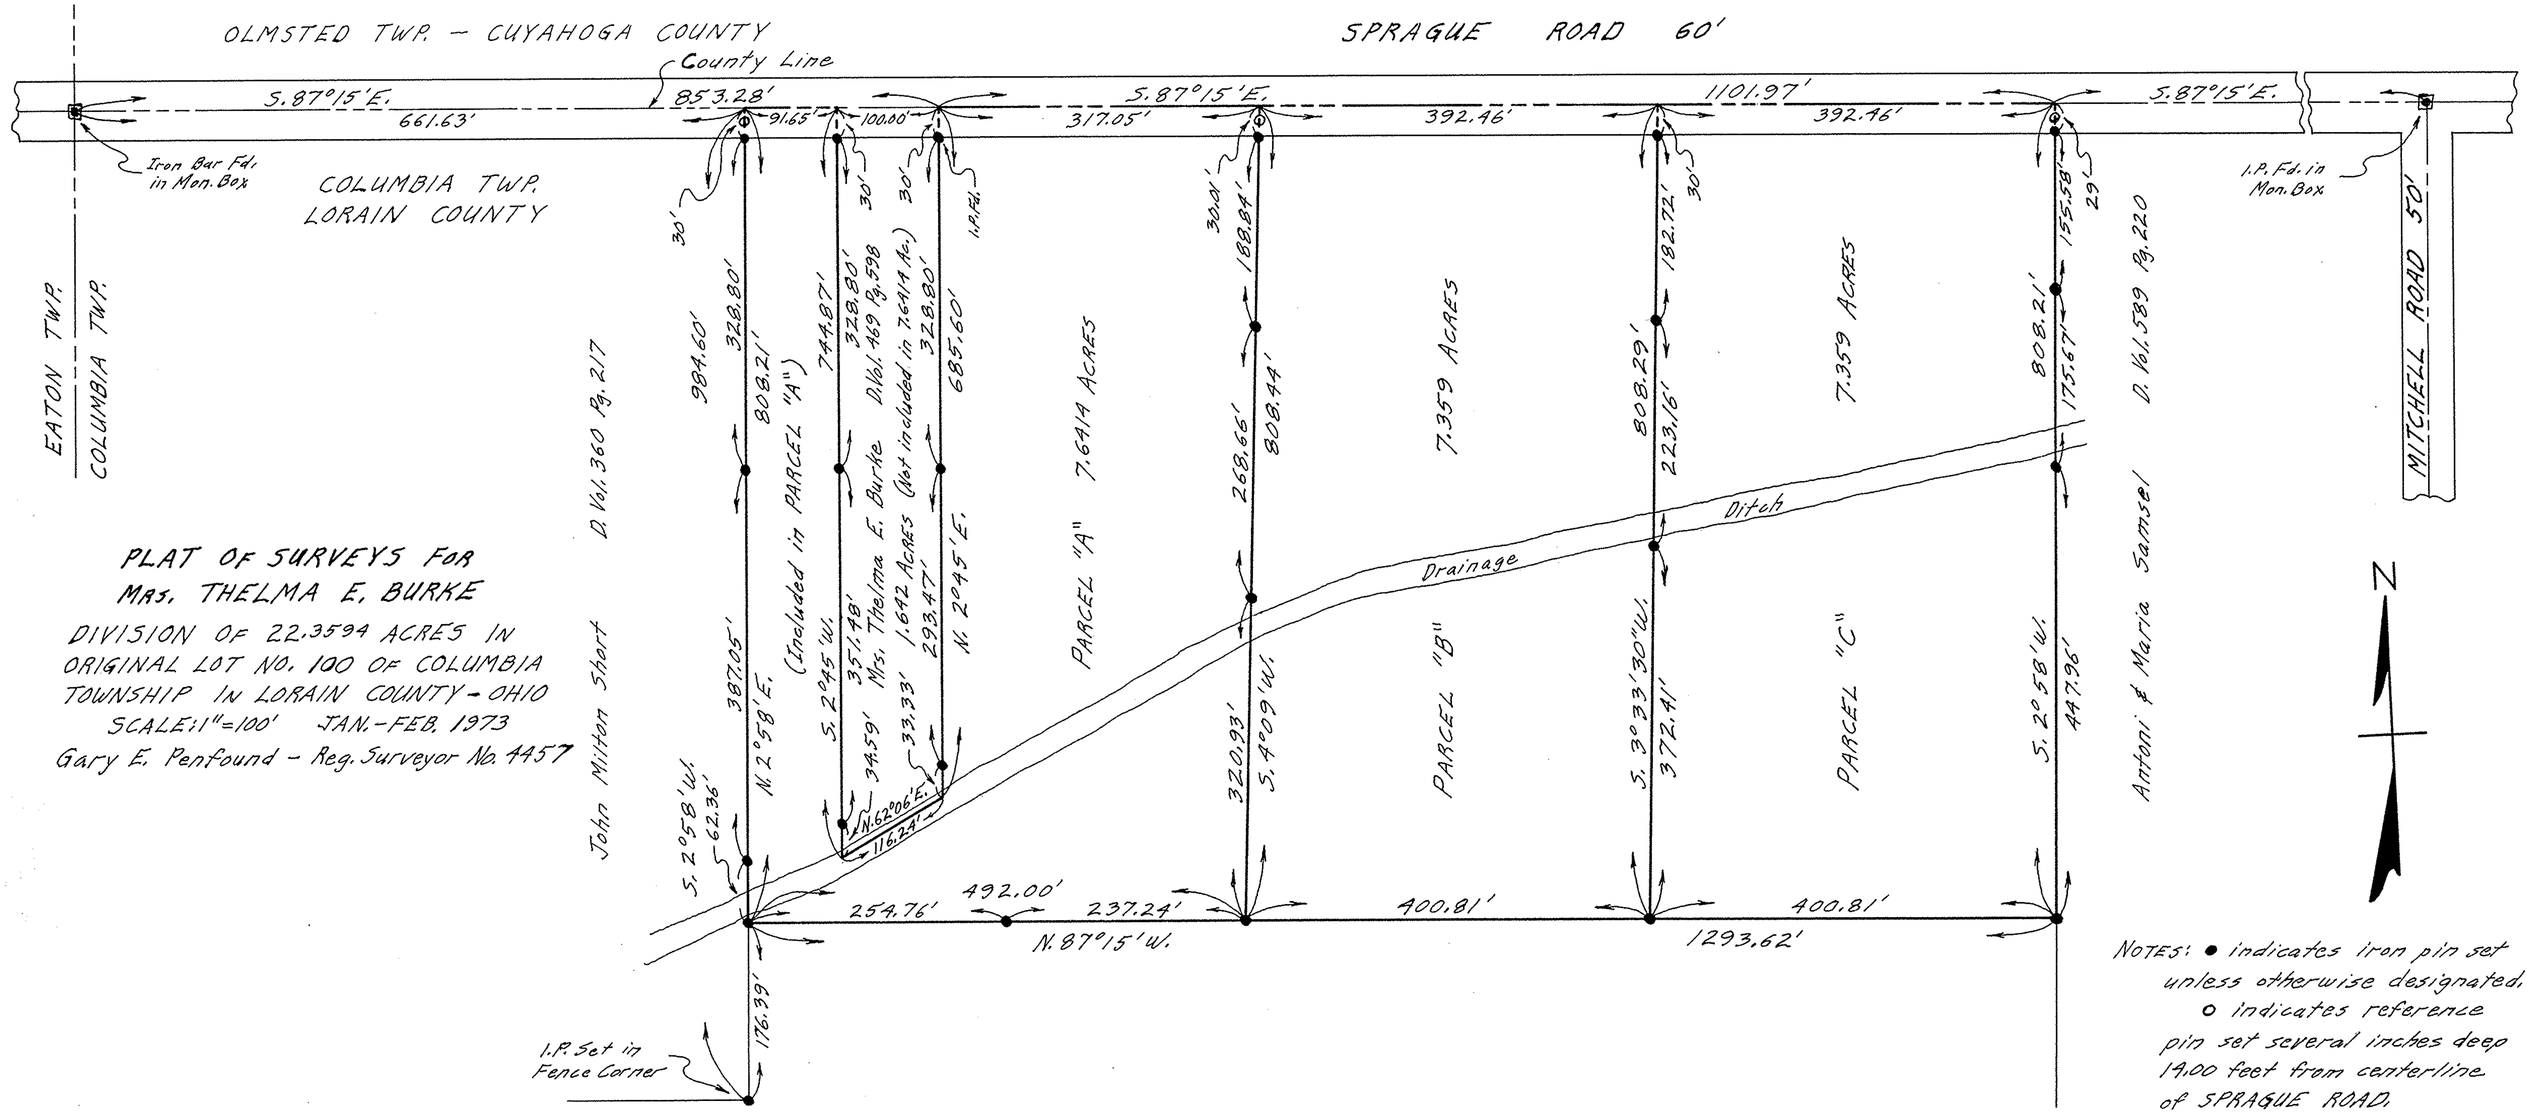

PLAT OF SURVEYS FOR MRS. THELMA E. BURKE

DIVISION OF 22.3594 ACRES IN ORIGINAL LOT NO. 100 OF COLUMBIA TOWNSHIP IN LORAIN COUNTY – OHIO

SCALE: 1" = 100' JAN.–FEB. 1973

Gary E. Penfound – Reg. Surveyor No. 4457

NOTES: ● indicates iron pin set unless otherwise designated.
○ indicates reference pin set several inches deep 19.00 feet from centerline of SPRAGUE ROAD.

12-00-100