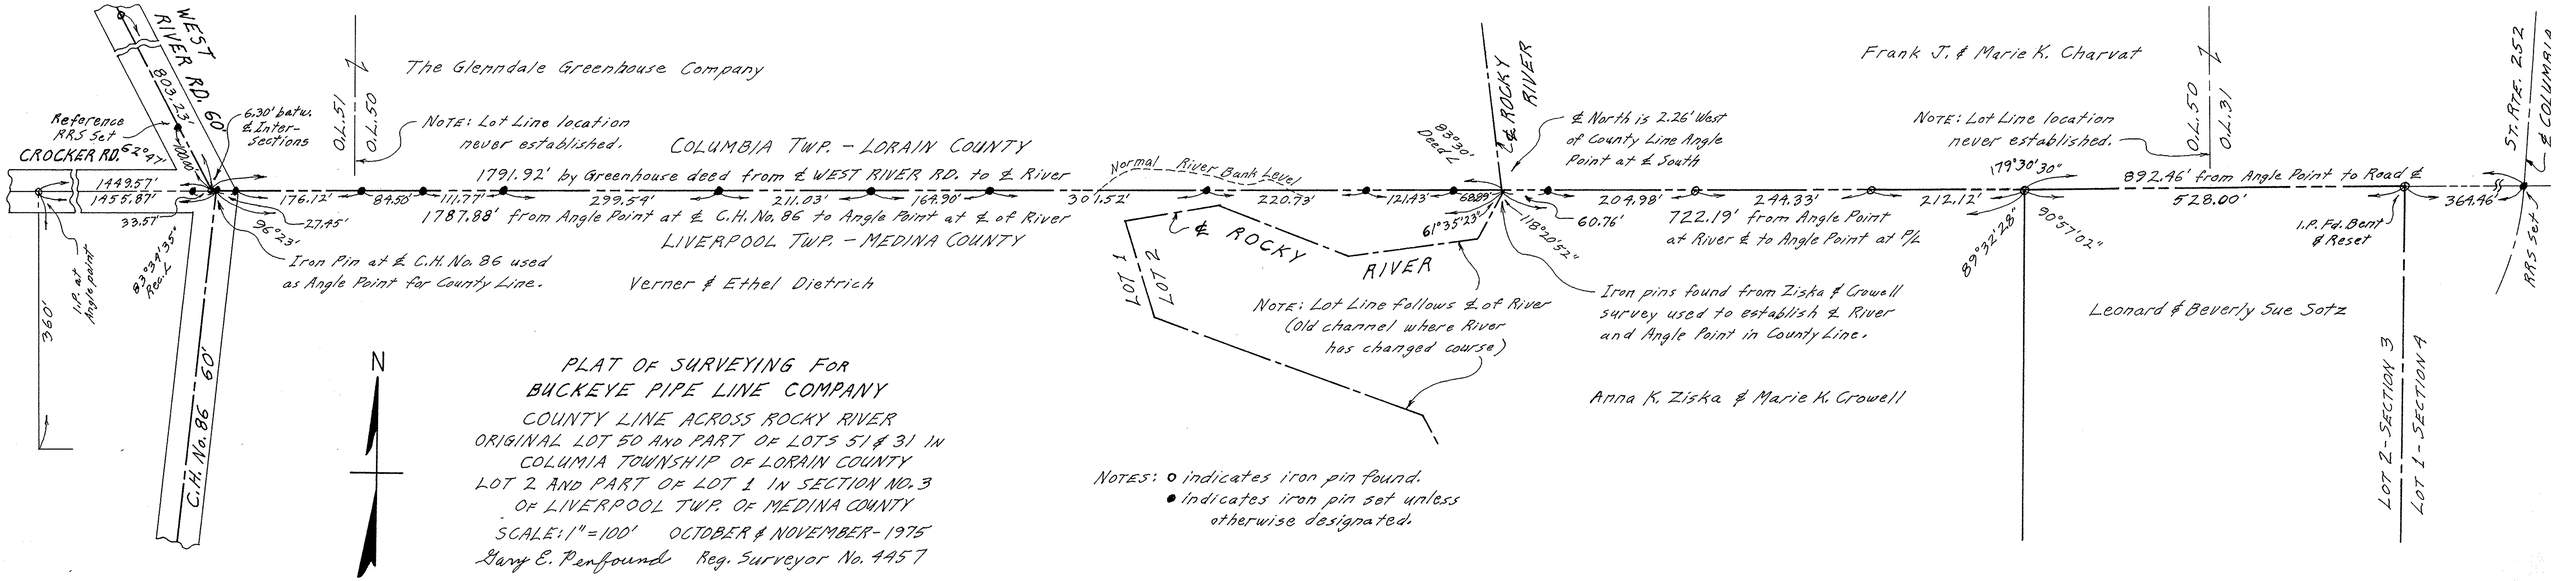

PLAT OF SURVEYING FOR
BUCKEYE PIPE LINE COMPANY
COUNTY LINE ACROSS ROCKY RIVER
ORIGINAL LOT 50 AND PART OF LOTS 51 & 31 IN
COLUMIA TOWNSHIP OF LORAIN COUNTY
LOT 2 AND PART OF LOT 1 IN SECTION NO. 3
OF LIVERPOOL TWP. OF MEDINA COUNTY
SCALE: 1" = 100' OCTOBER & NOVEMBER - 1975
Gary E. Renfound Reg. Surveyor No. 4457

NOTES: ○ indicates iron pin found.
● indicates iron pin set unless otherwise designated.

12-00-050,051