
 


Survey for Adolbert R. Marynoyse
 Orig Lots 21 & 40 Columbia Twp.
 Lorain Co, Ohio Scale: 1"=100' Oct 22, 1927
 Warden & Laundon Civil Engineers

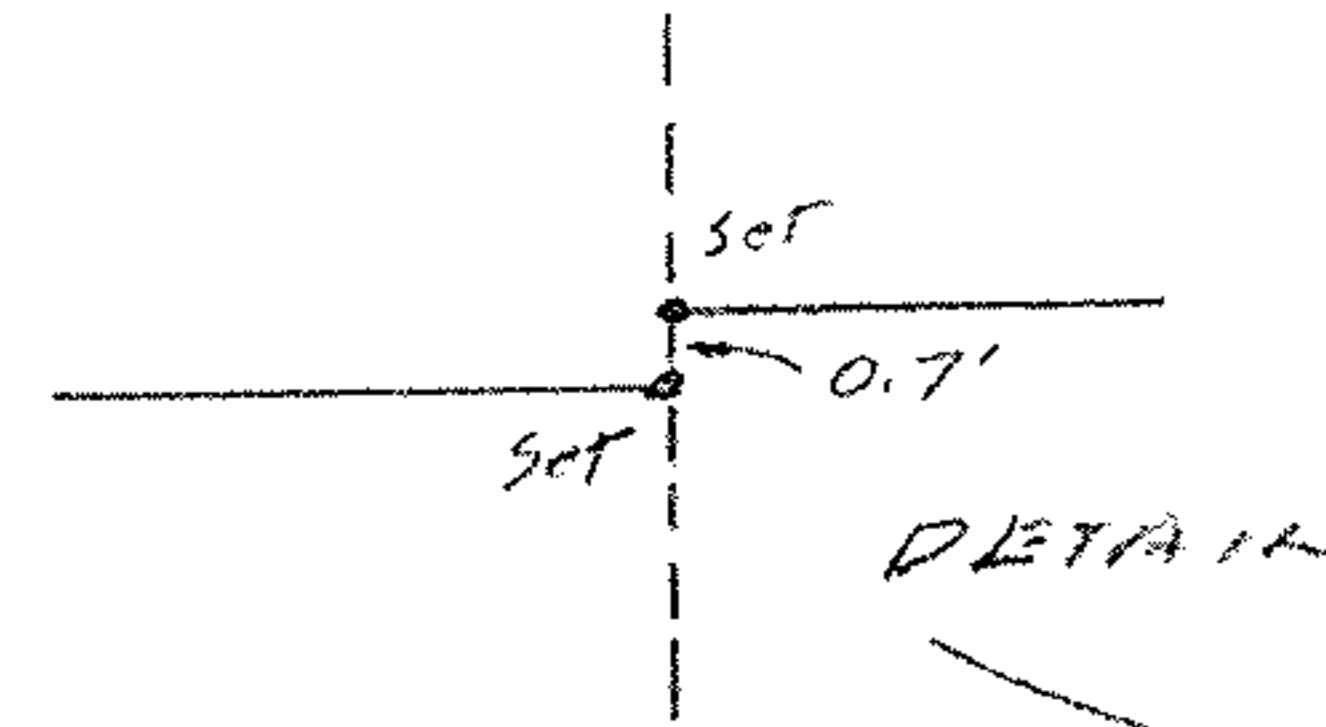

Vol. 193-196 Ex FRED B. GENT
 ALLEN
 AUG. 14-1927
 MARY ZELASKO
 322.0

2.61 ac
 0.21