PLAT OF SURVEYING FOR FRANK HOZALSKI

ORIGINAL LOTS 1 & 16 - TRACT 10 - CAMDEN TWP.
LORAIN COUNTY OHIO
SCALE: 1" = 100' APRIL - 1976
Gary E. Pentfound Reg. Surveyor No. 4457

NOTES: o indicates iron pin found.
● indicates iron pin set unless otherwise designated.

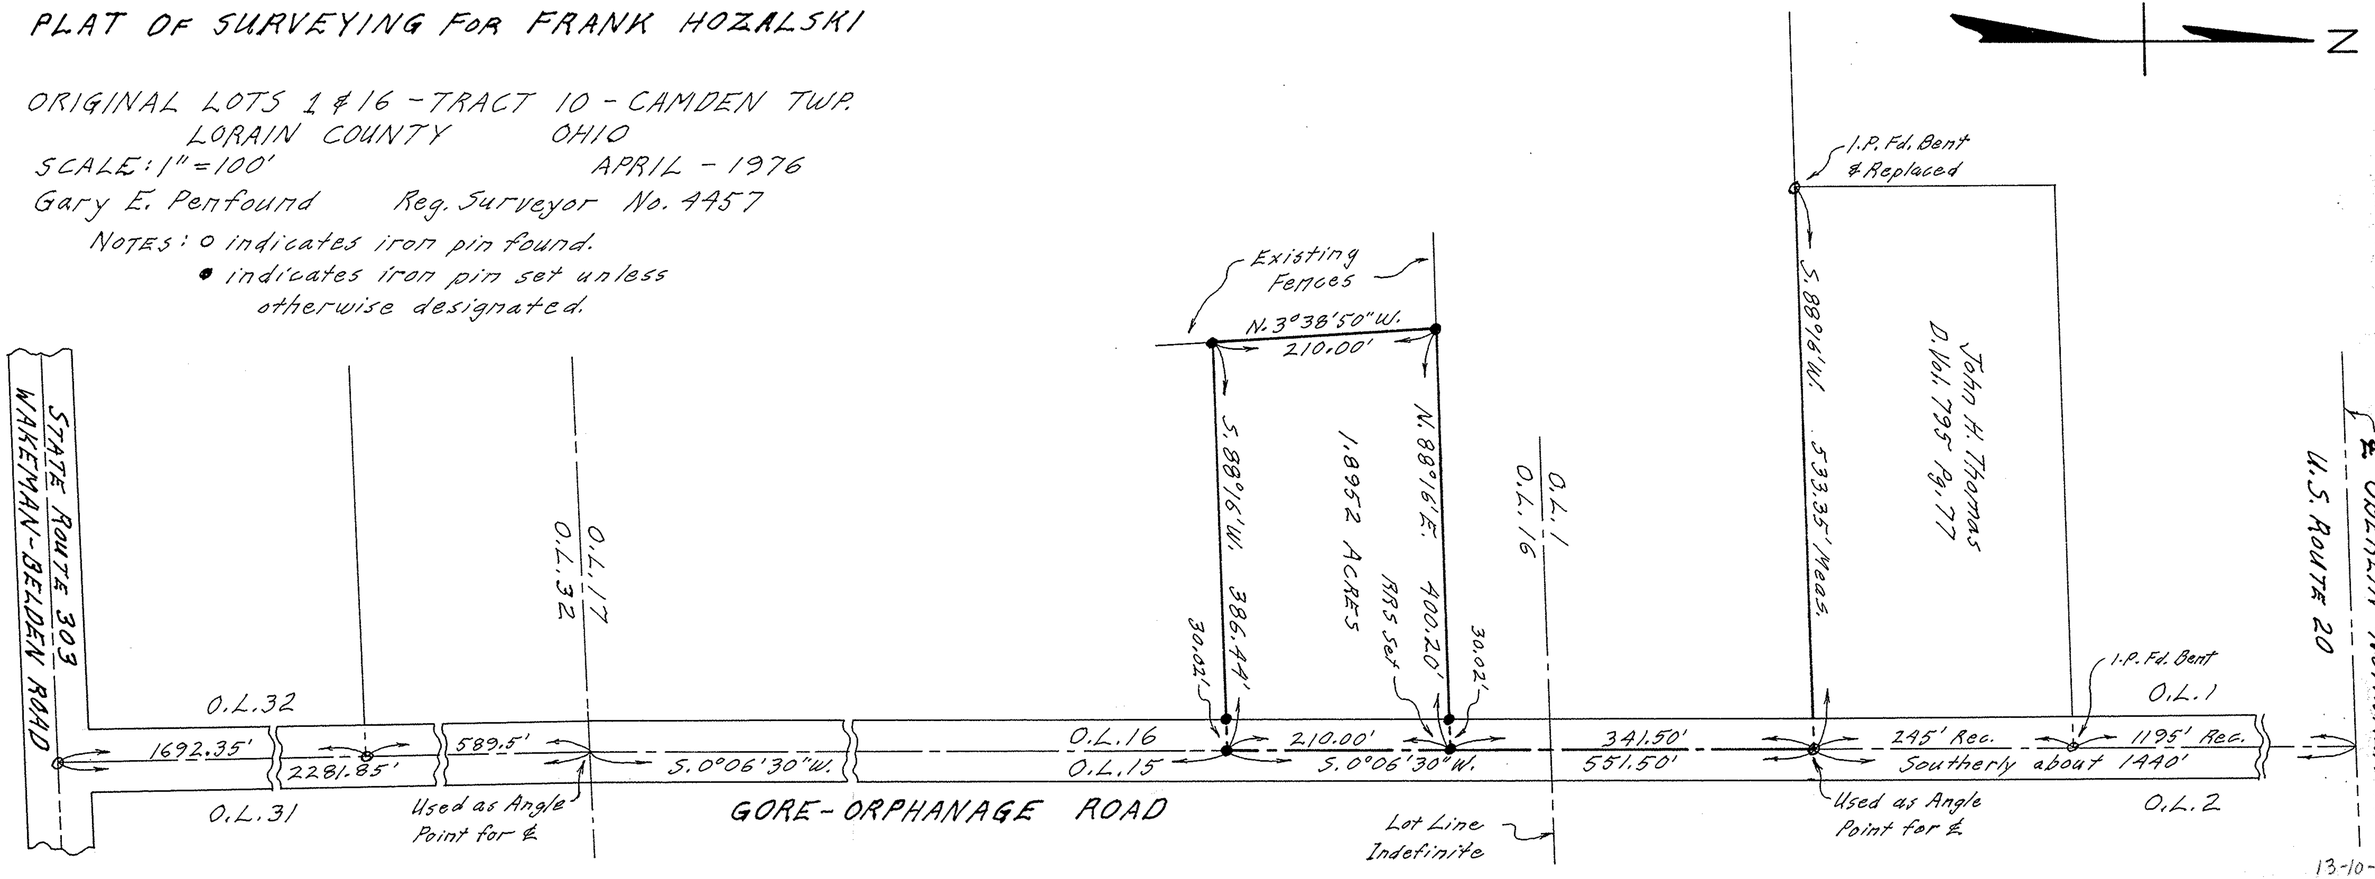

13-10-001.016