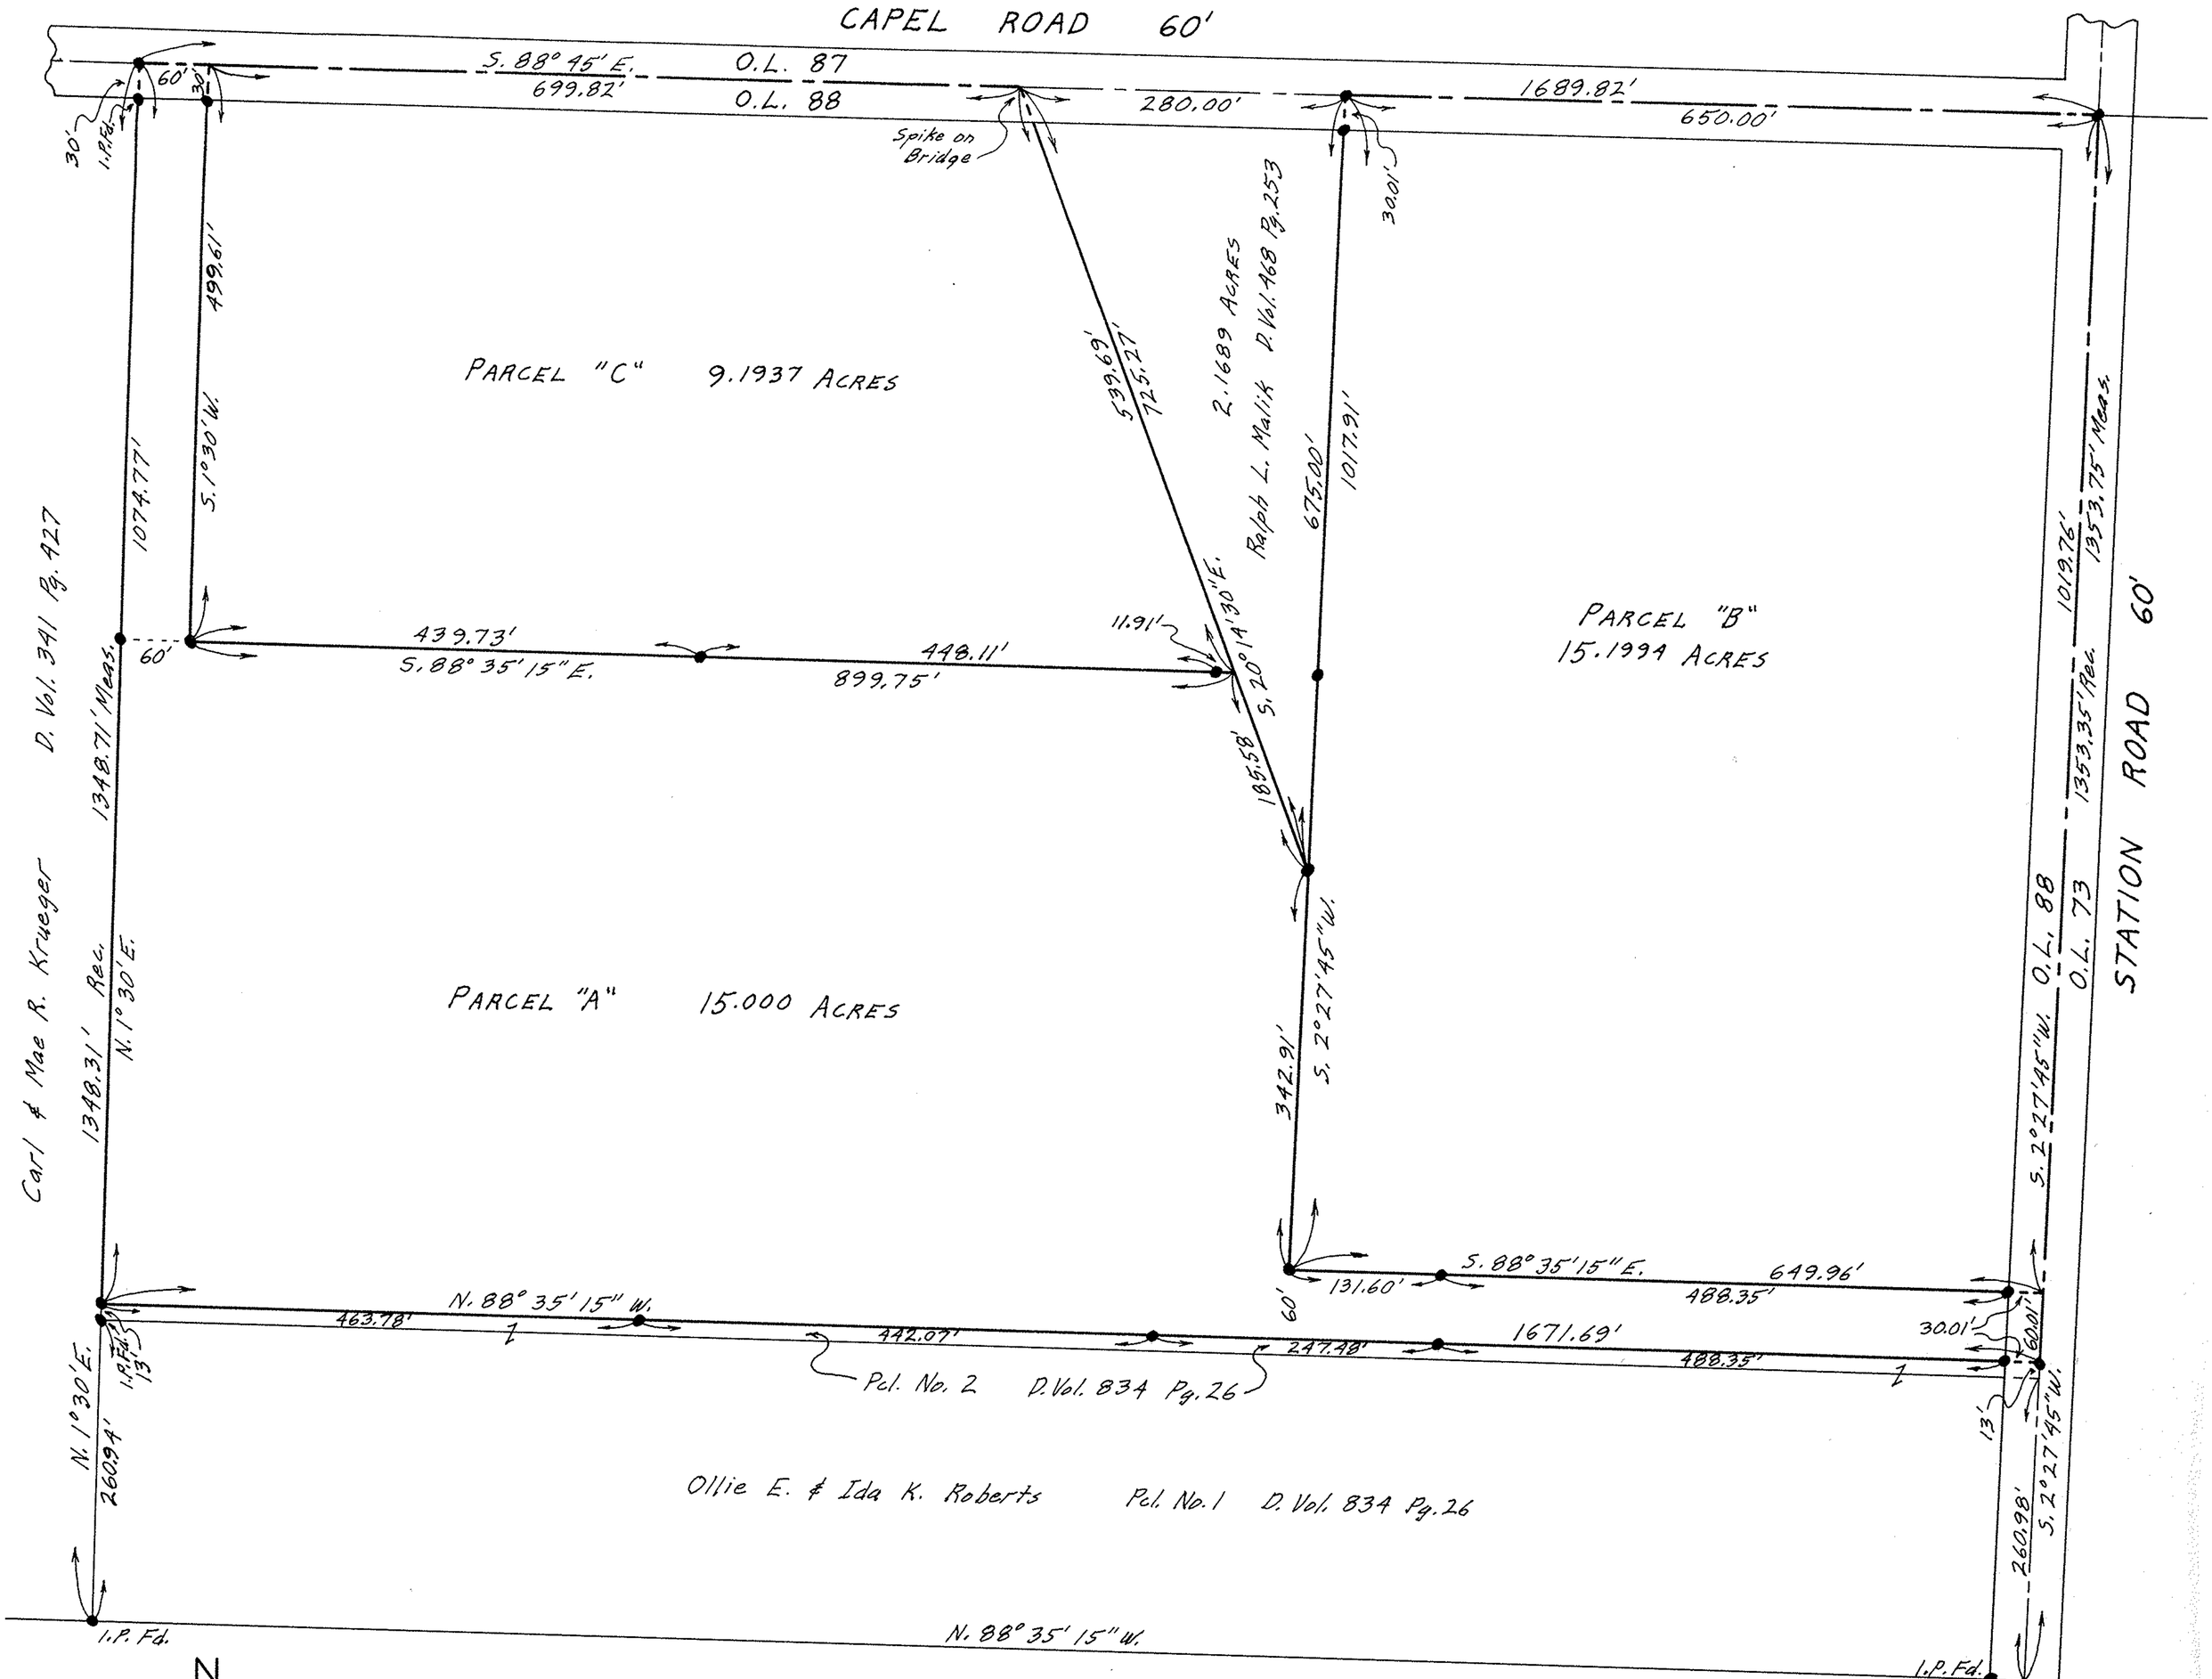

PLAT OF SURVEYS FOR
THERESA M. MALIK
ORIGINAL LOT 88 COLUMBIA TOWNSHIP
LORAIN COUNTY OHIO
SCALE: 1" = 100' MARCH 1967
Gary E. Penfound Reg. Surveyor No. 4457

NOTE: ● indicates iron pin set unless otherwise designated.