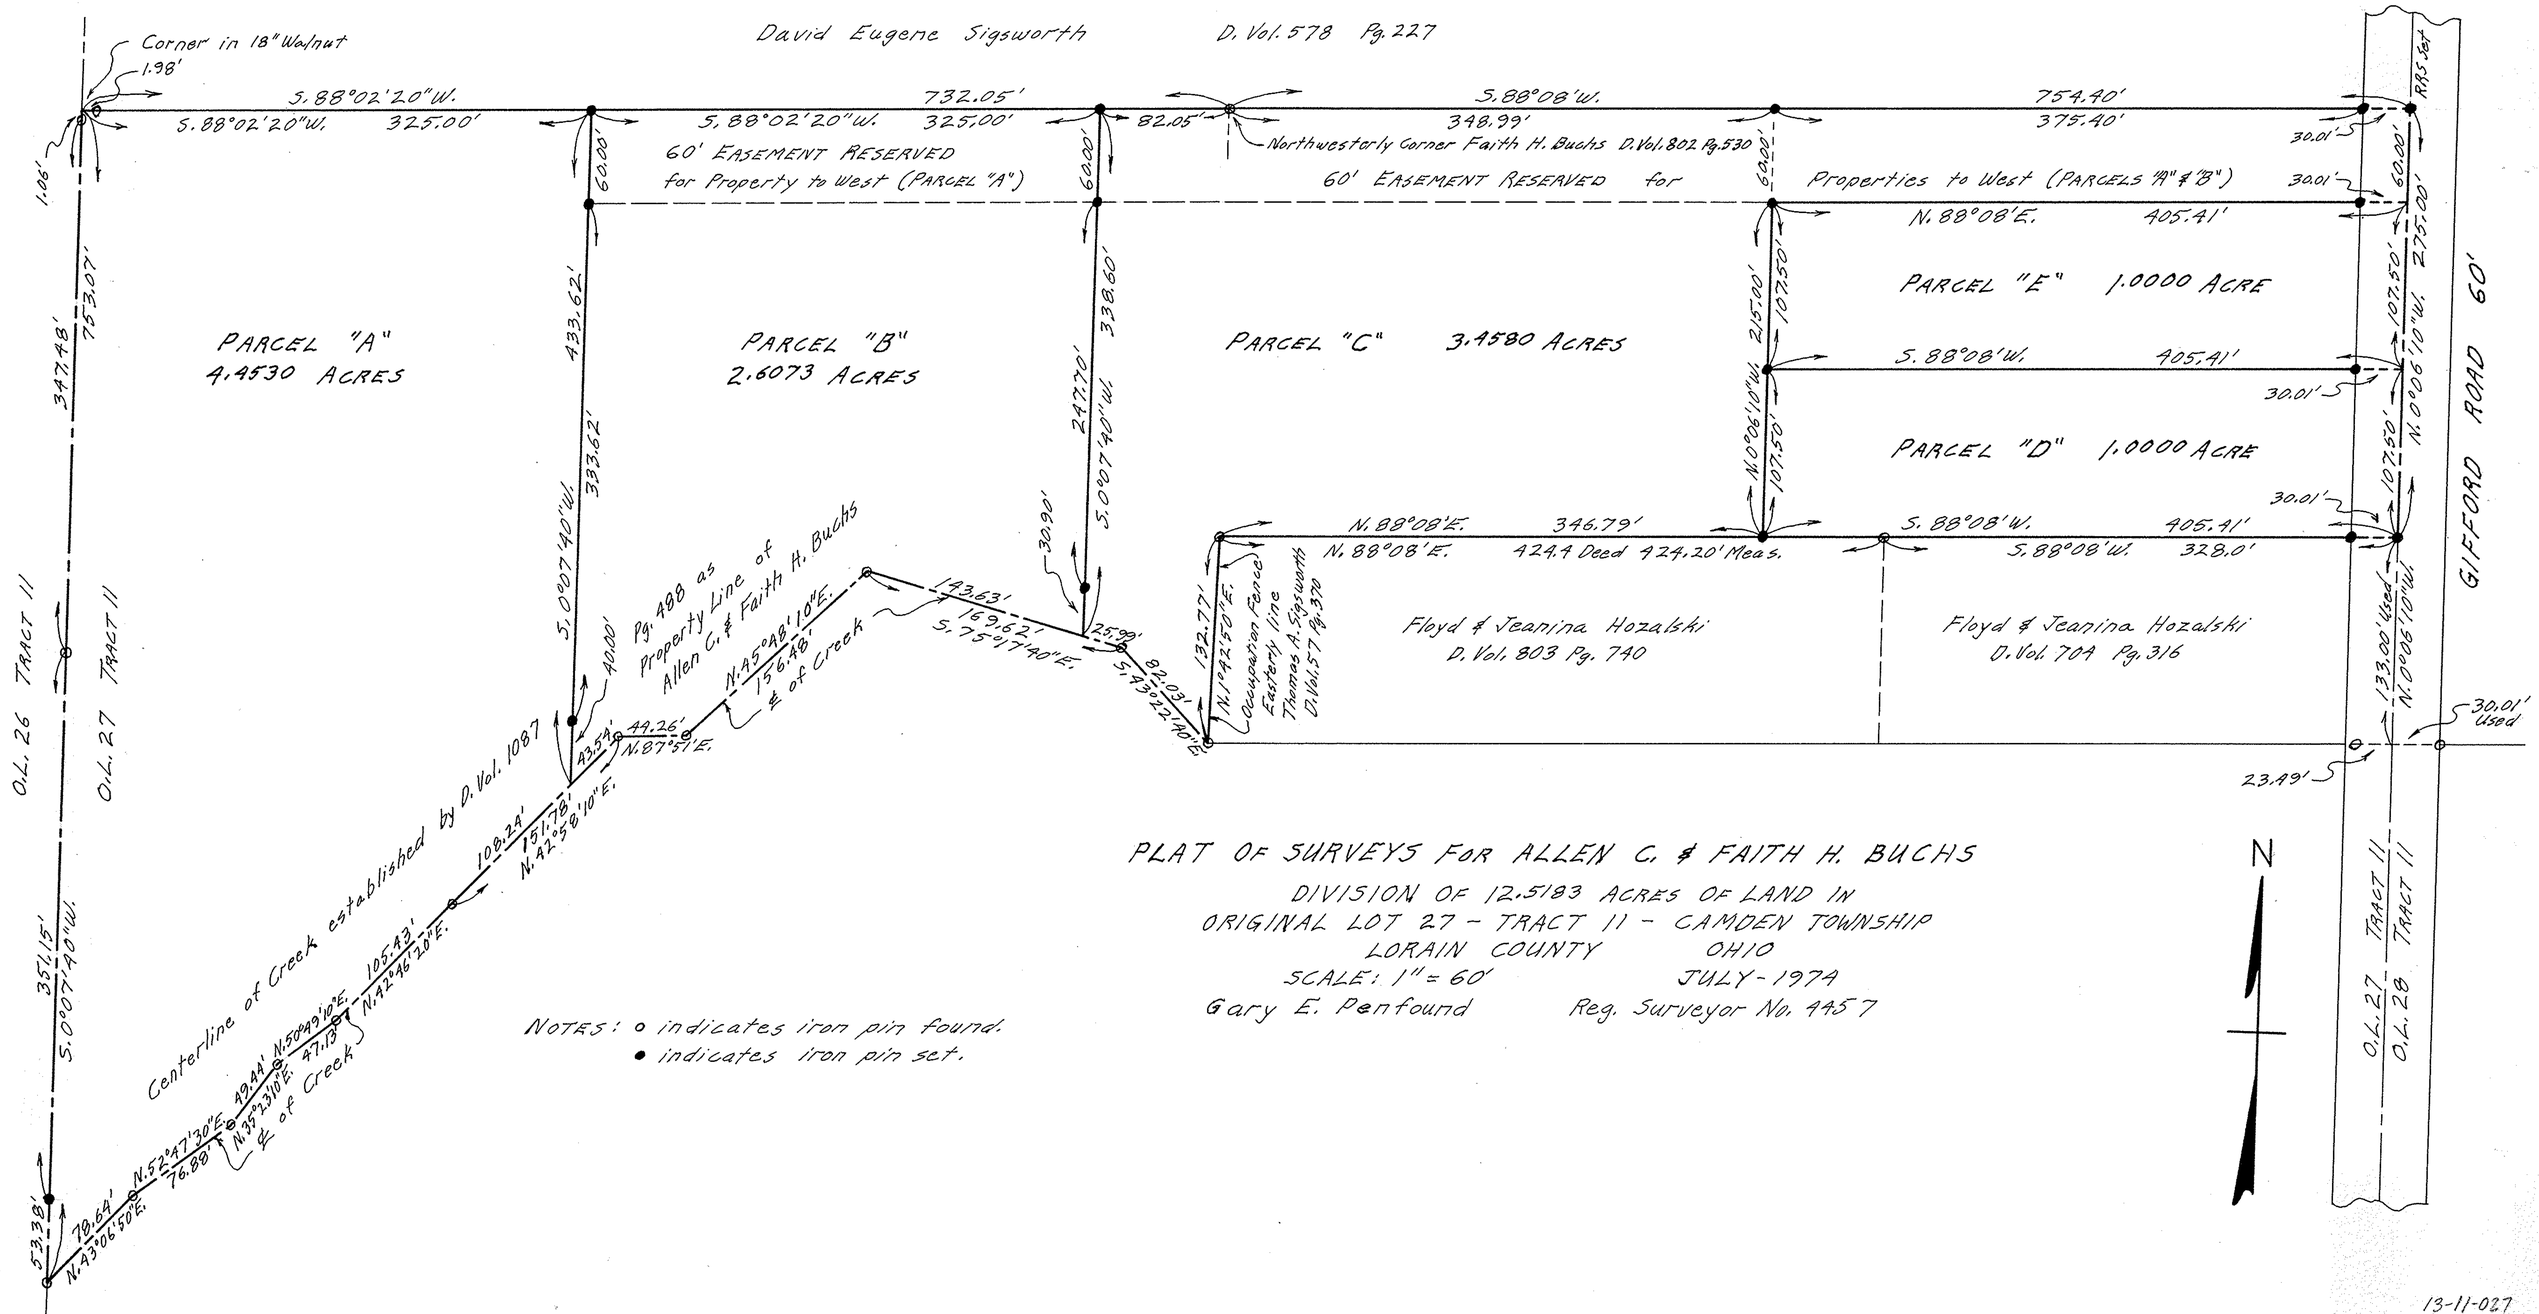

PLAT OF SURVEYS FOR ALLEN C. & FAITH H. BUCHS

DIVISION OF 12.5183 ACRES OF LAND IN
ORIGINAL LOT 27 - TRACT 11 - CAMDEN TOWNSHIP
LORAIN COUNTY OHIO

SCALE: 1" = 60' JULY - 1974

Gary E. Penfound Reg. Surveyor No. 4457

NOTES: o indicates iron pin found.
• indicates iron pin set.

13-11-027