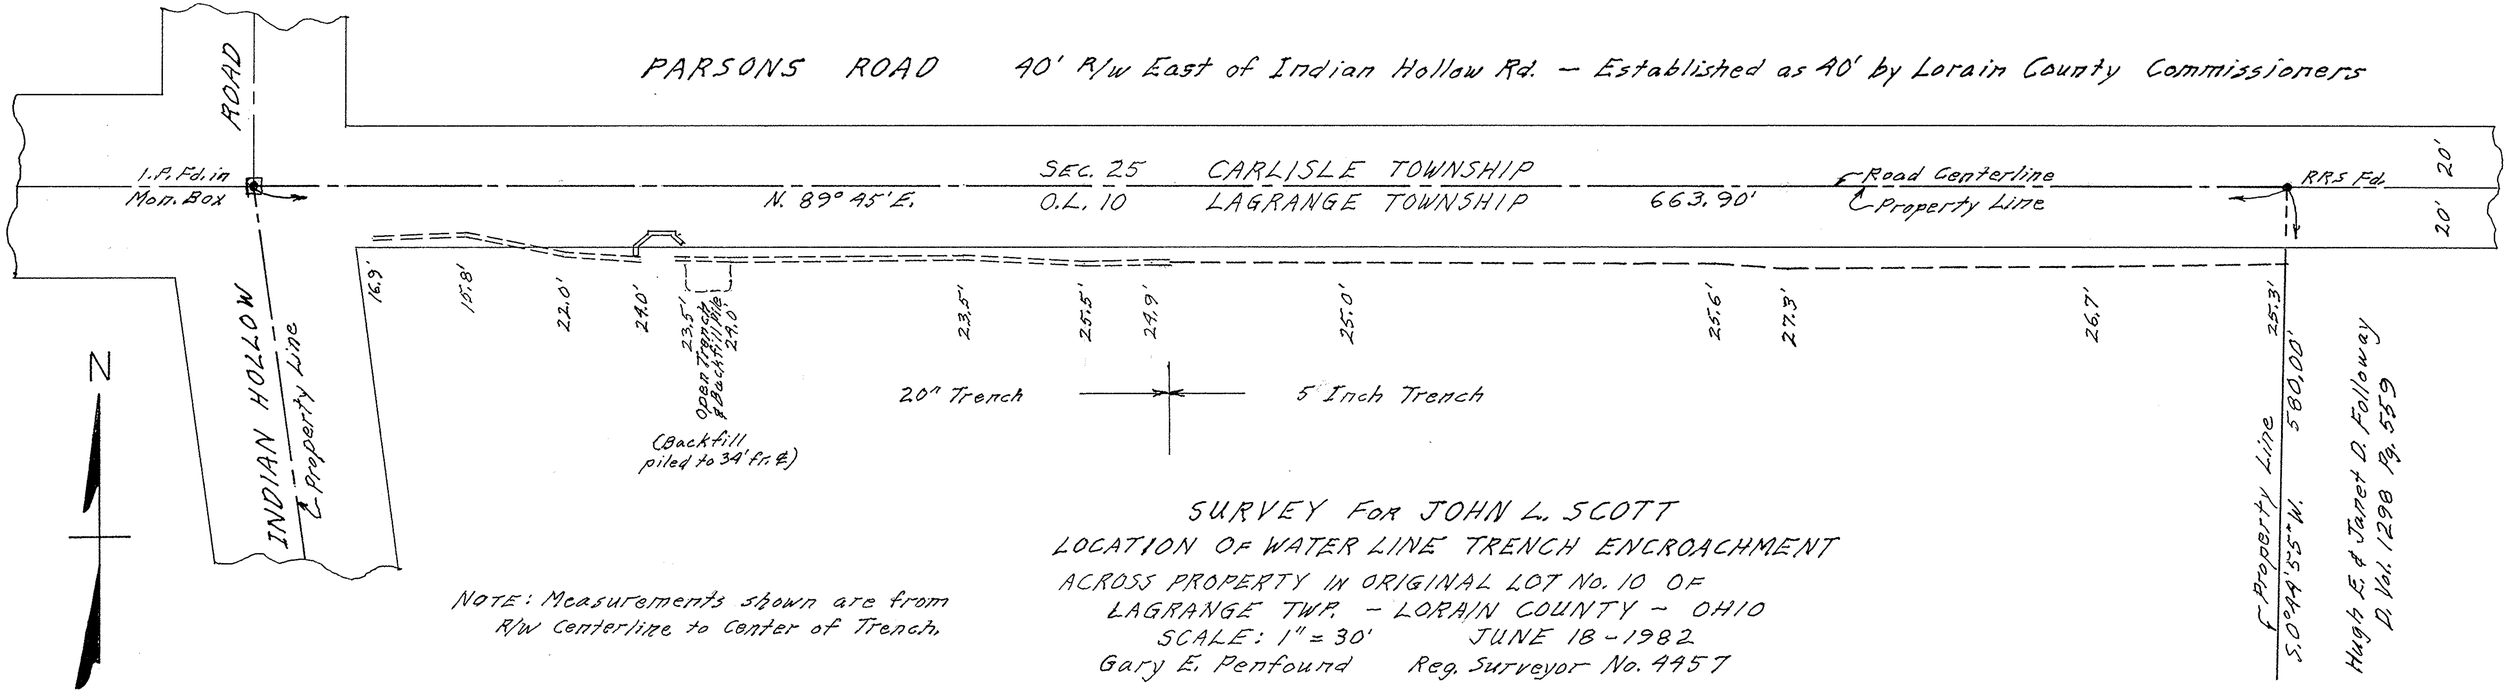

NOTE: Measurements shown are from R/w Centerline to Center of Trench.

SURVEY FOR JOHN L. SCOTT
LOCATION OF WATER LINE TRENCH ENCROACHMENT
ACROSS PROPERTY IN ORIGINAL LOT No. 10 OF
LAGRANGE TWP. – LORAIN COUNTY – OHIO
SCALE: 1" = 30' JUNE 18 – 1982
Gary E. Penfound Reg. Surveyor No. 4457

15-00-010