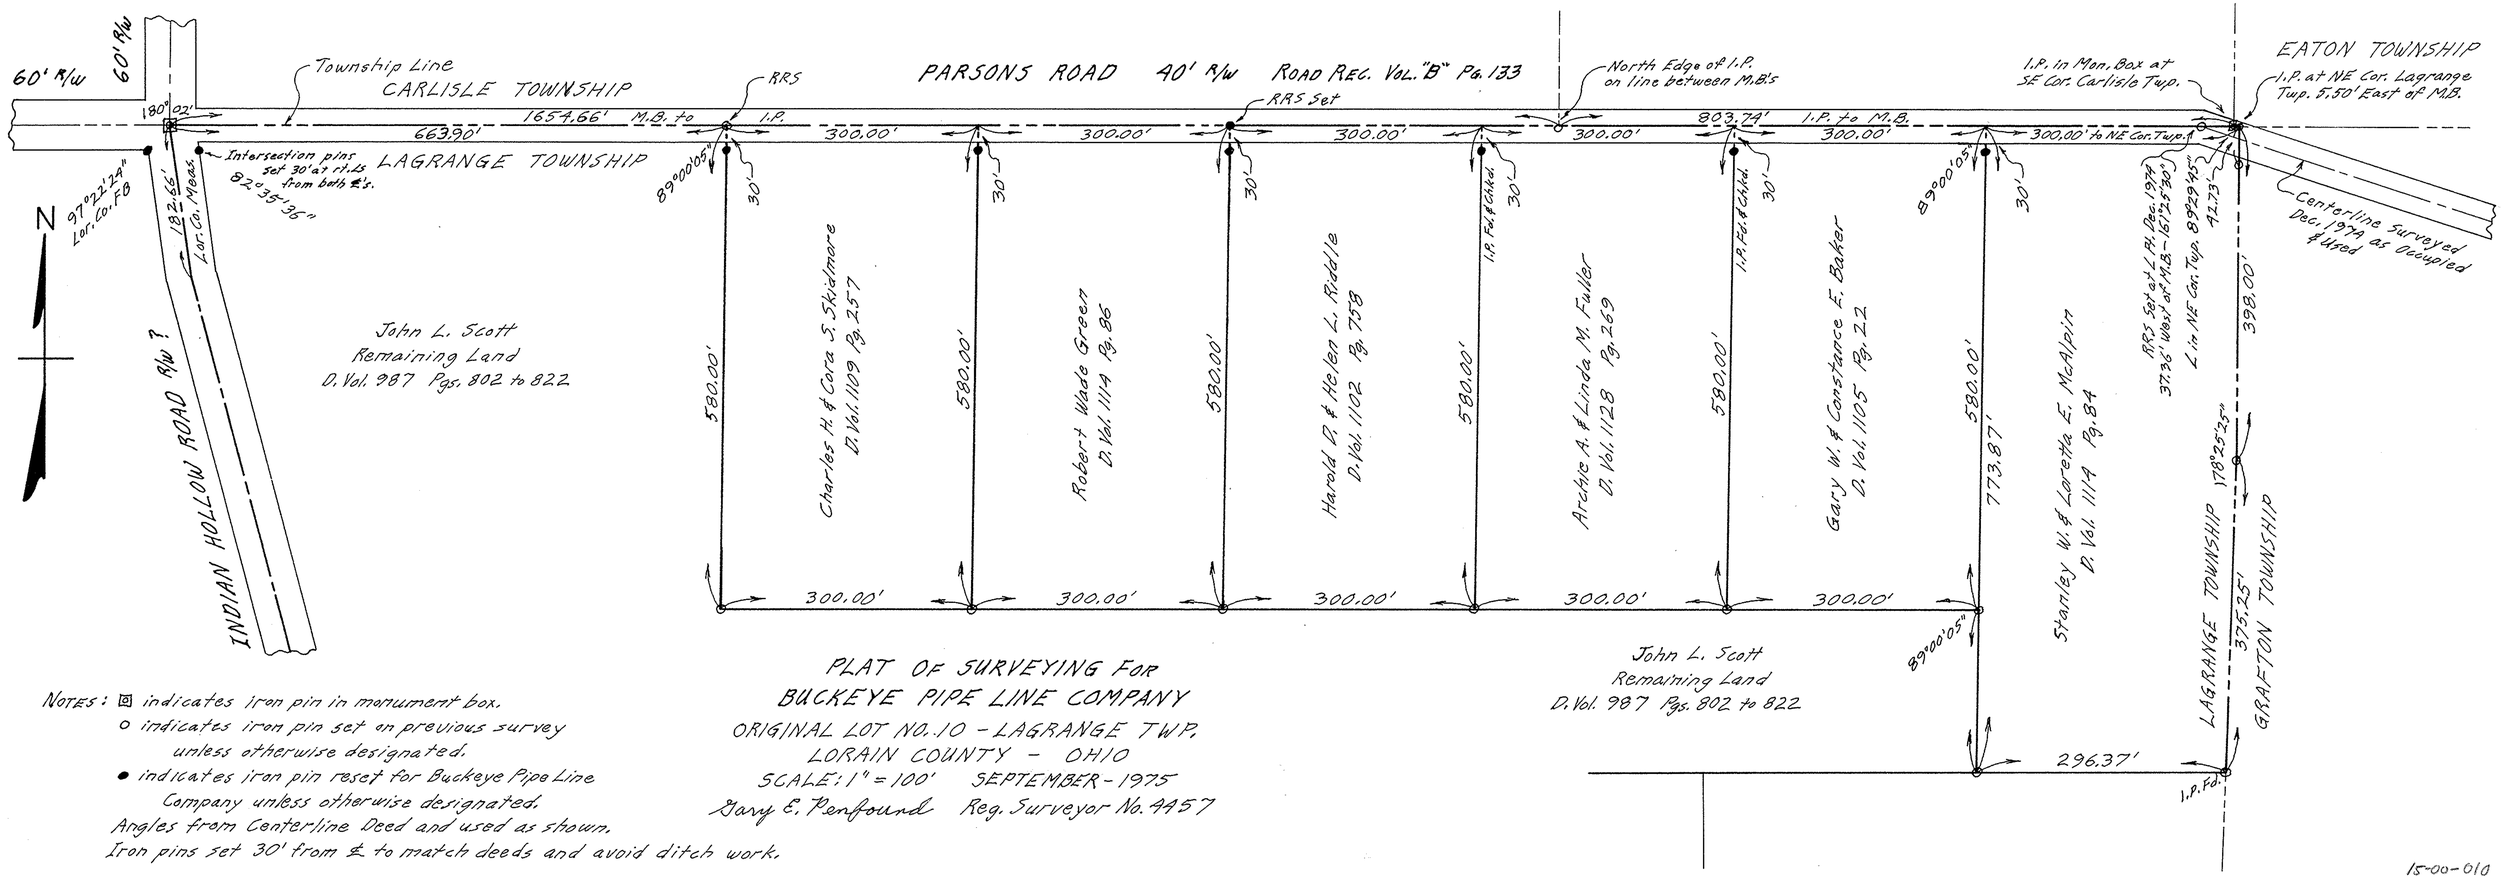

NOTES: ⊡ indicates iron pin in monument box.
o indicates iron pin set on previous survey unless otherwise designated.
● indicates iron pin reset for Buckeye Pipe Line Company unless otherwise designated.
Angles from Centerline Deed and used as shown.
Iron pins set 30' from ℄ to match deeds and avoid ditch work.

PLAT OF SURVEYING FOR
BUCKEYE PIPE LINE COMPANY
ORIGINAL LOT NO. 10 - LAGRANGE TWP.
LORAIN COUNTY - OHIO
SCALE: 1" = 100' SEPTEMBER - 1975
Gary E. Renfound Reg. Surveyor No. 4457

15-00-010